


Township 4 North Range 27 East Will. Mr. Oregon.

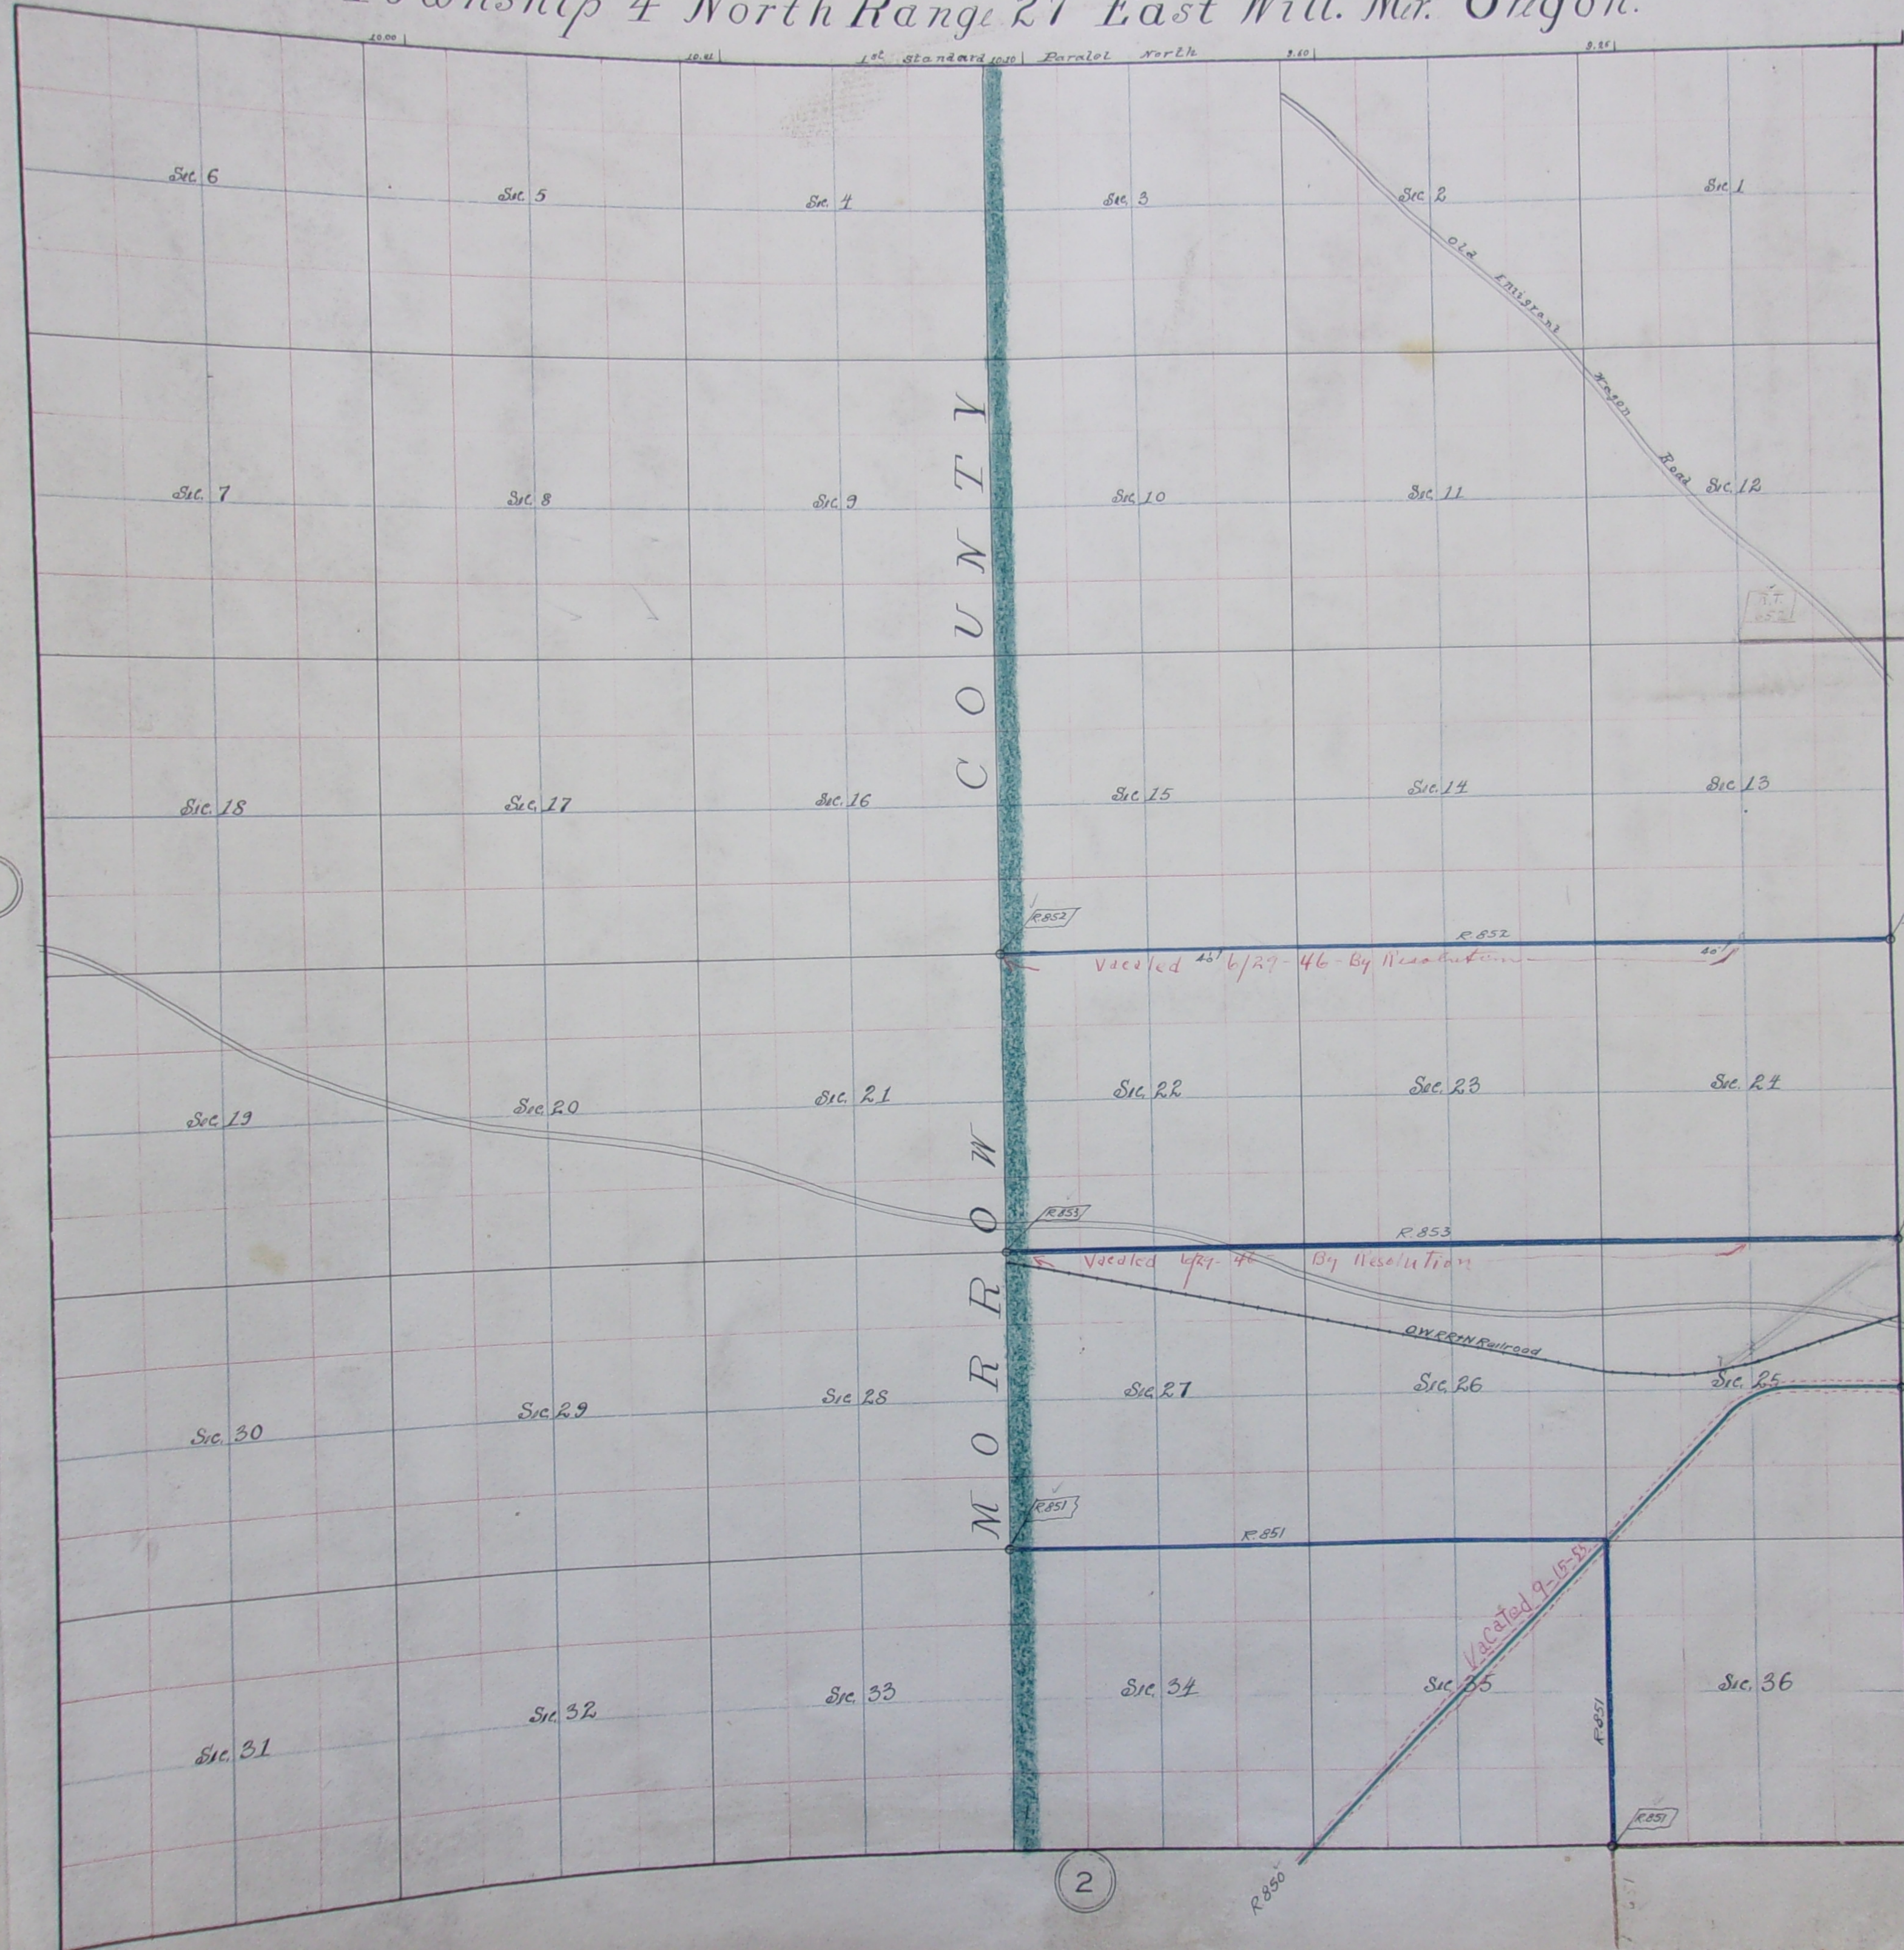

Date	No.	Box	Book	Page	Date	No.	Box	Book	Page
May 9, 1908	652	233	77L						
April 9, 1926	852		0						
April 9, 1926	851		0						
April 9, 1926	853		0						
April 9, 1926	850		0	168					

Scale 25 chains to 1 inch