Township 2 North Range 28 East Will. Mer. Oregon.

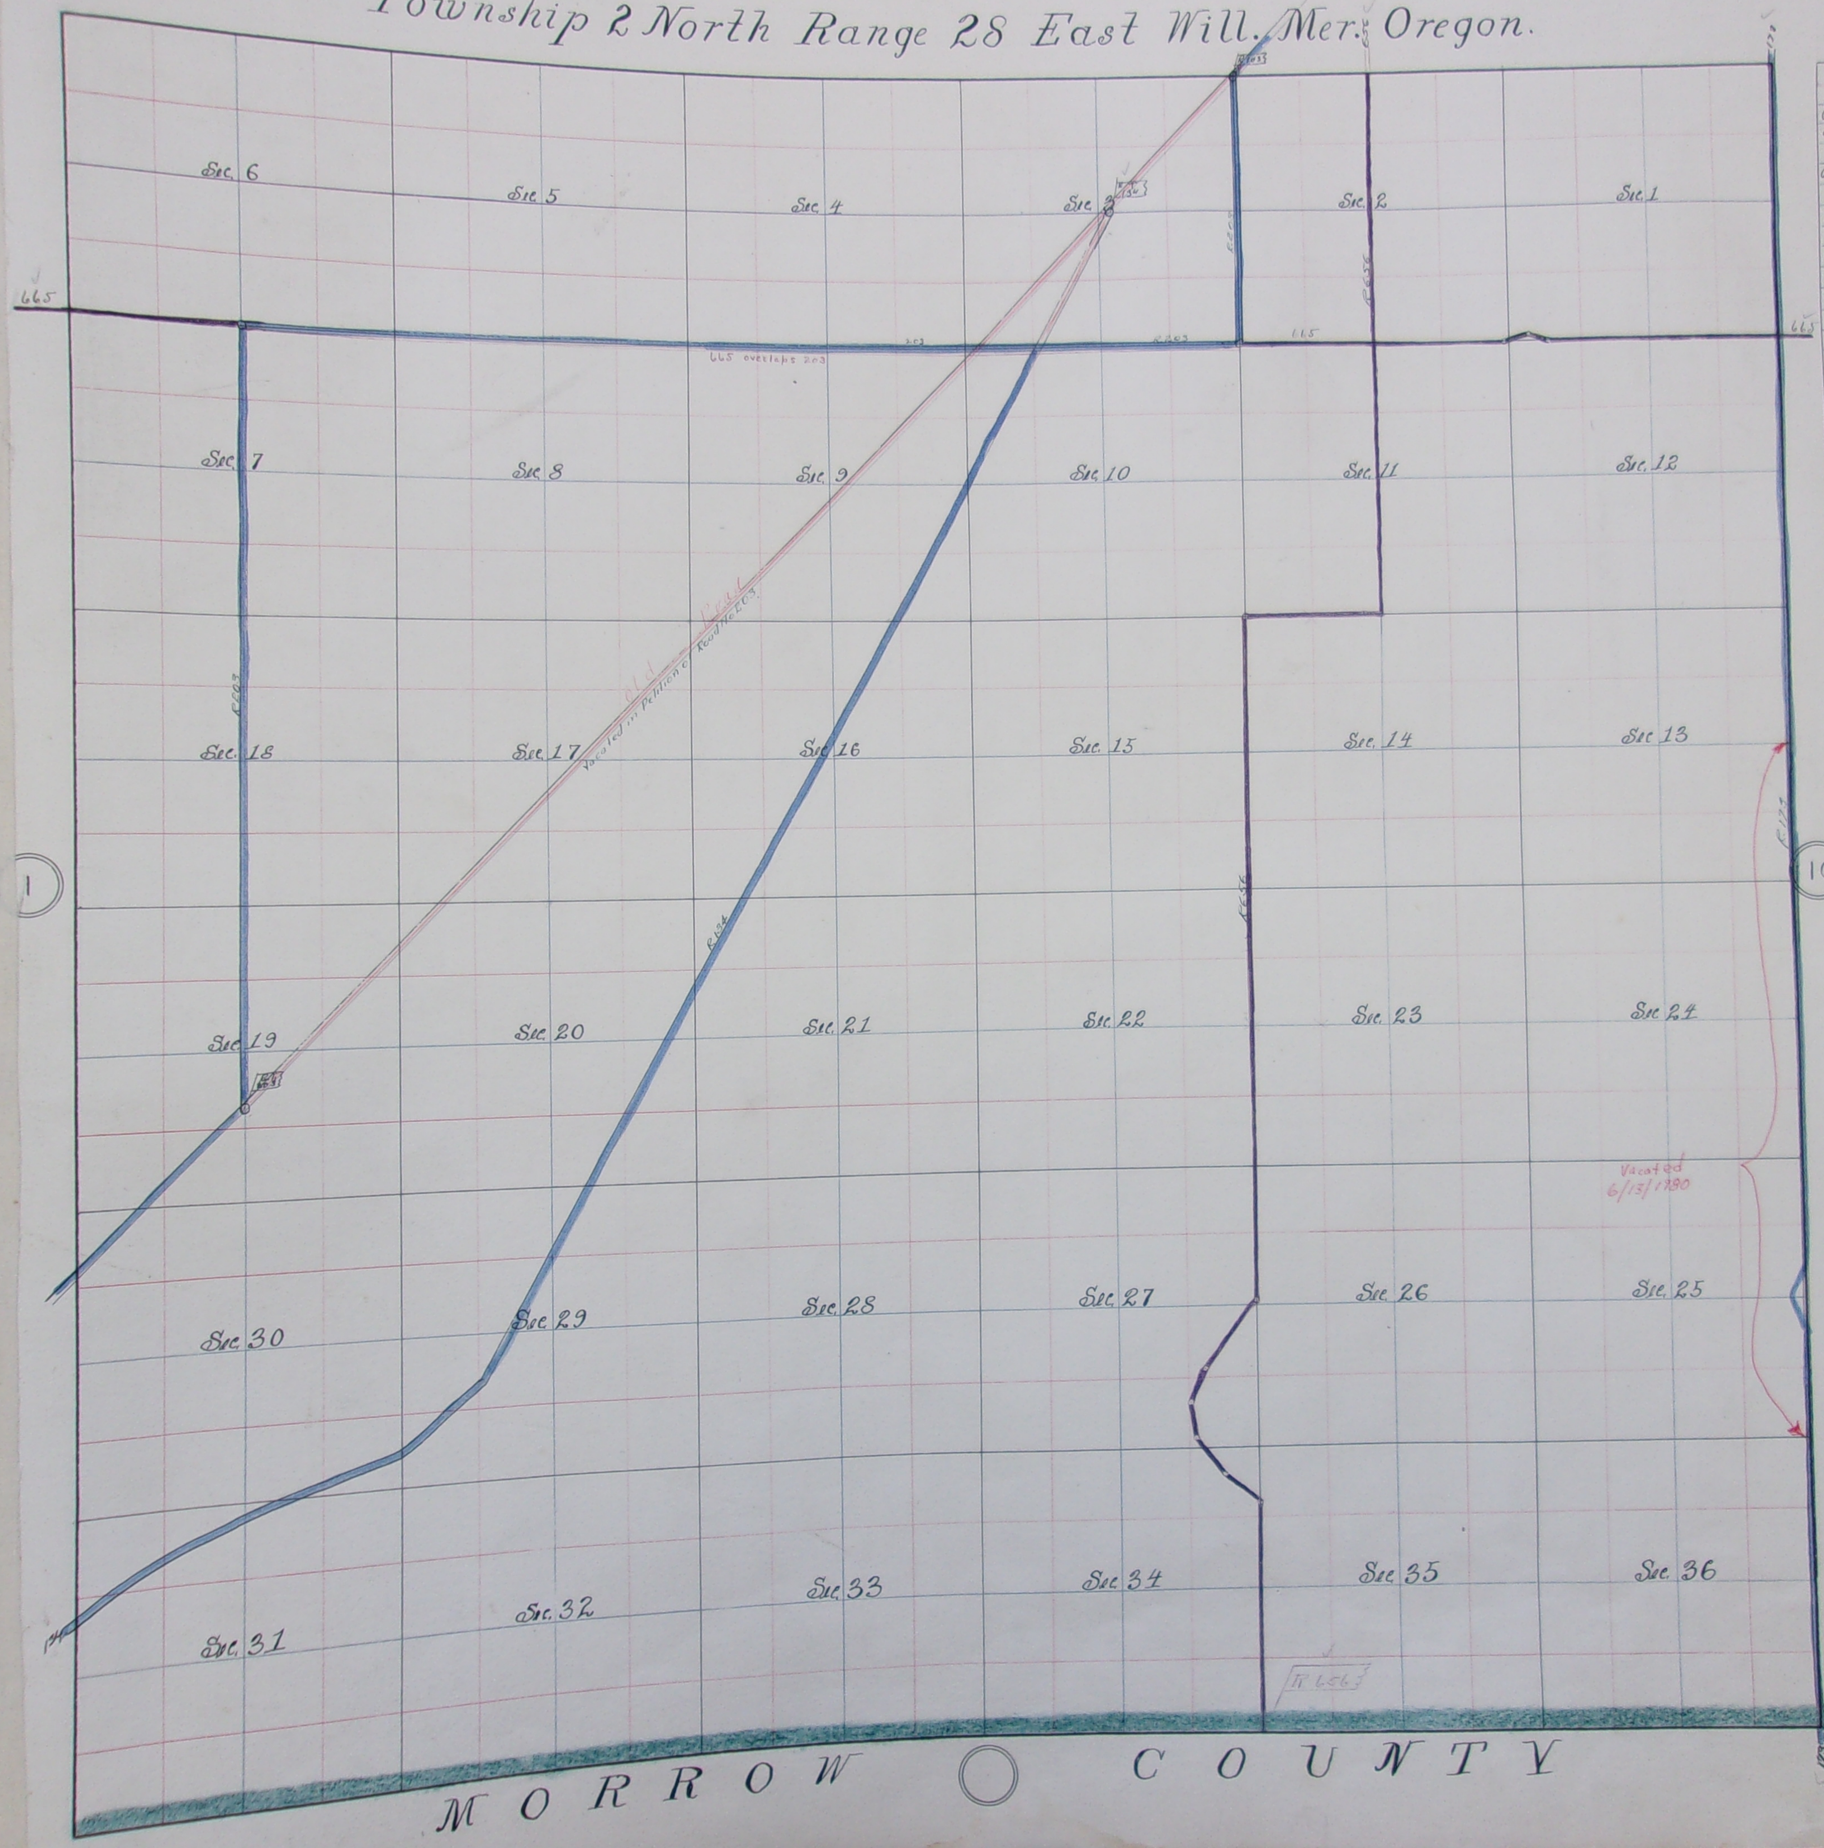

Date	No.	Box	Book	Page	Date	No.	Box	Book	Page
June 16 1884	173	15	F	236					
July 31 1884	203	16	F	448					
July 31 1884	203	16	F	445					
June 17 1883	134	14	E	529					
July 31 1884	134	16	F	148					
June 6 1908	656	233	M	289					
June 8, 1909	665		M	370					
Vacated 6/13/1980	173								

True Meridian
Var. 21° East

Scale 25 Chains to 1 inch