


Township 3 North Range 28 East Will. Mer. Oregon.

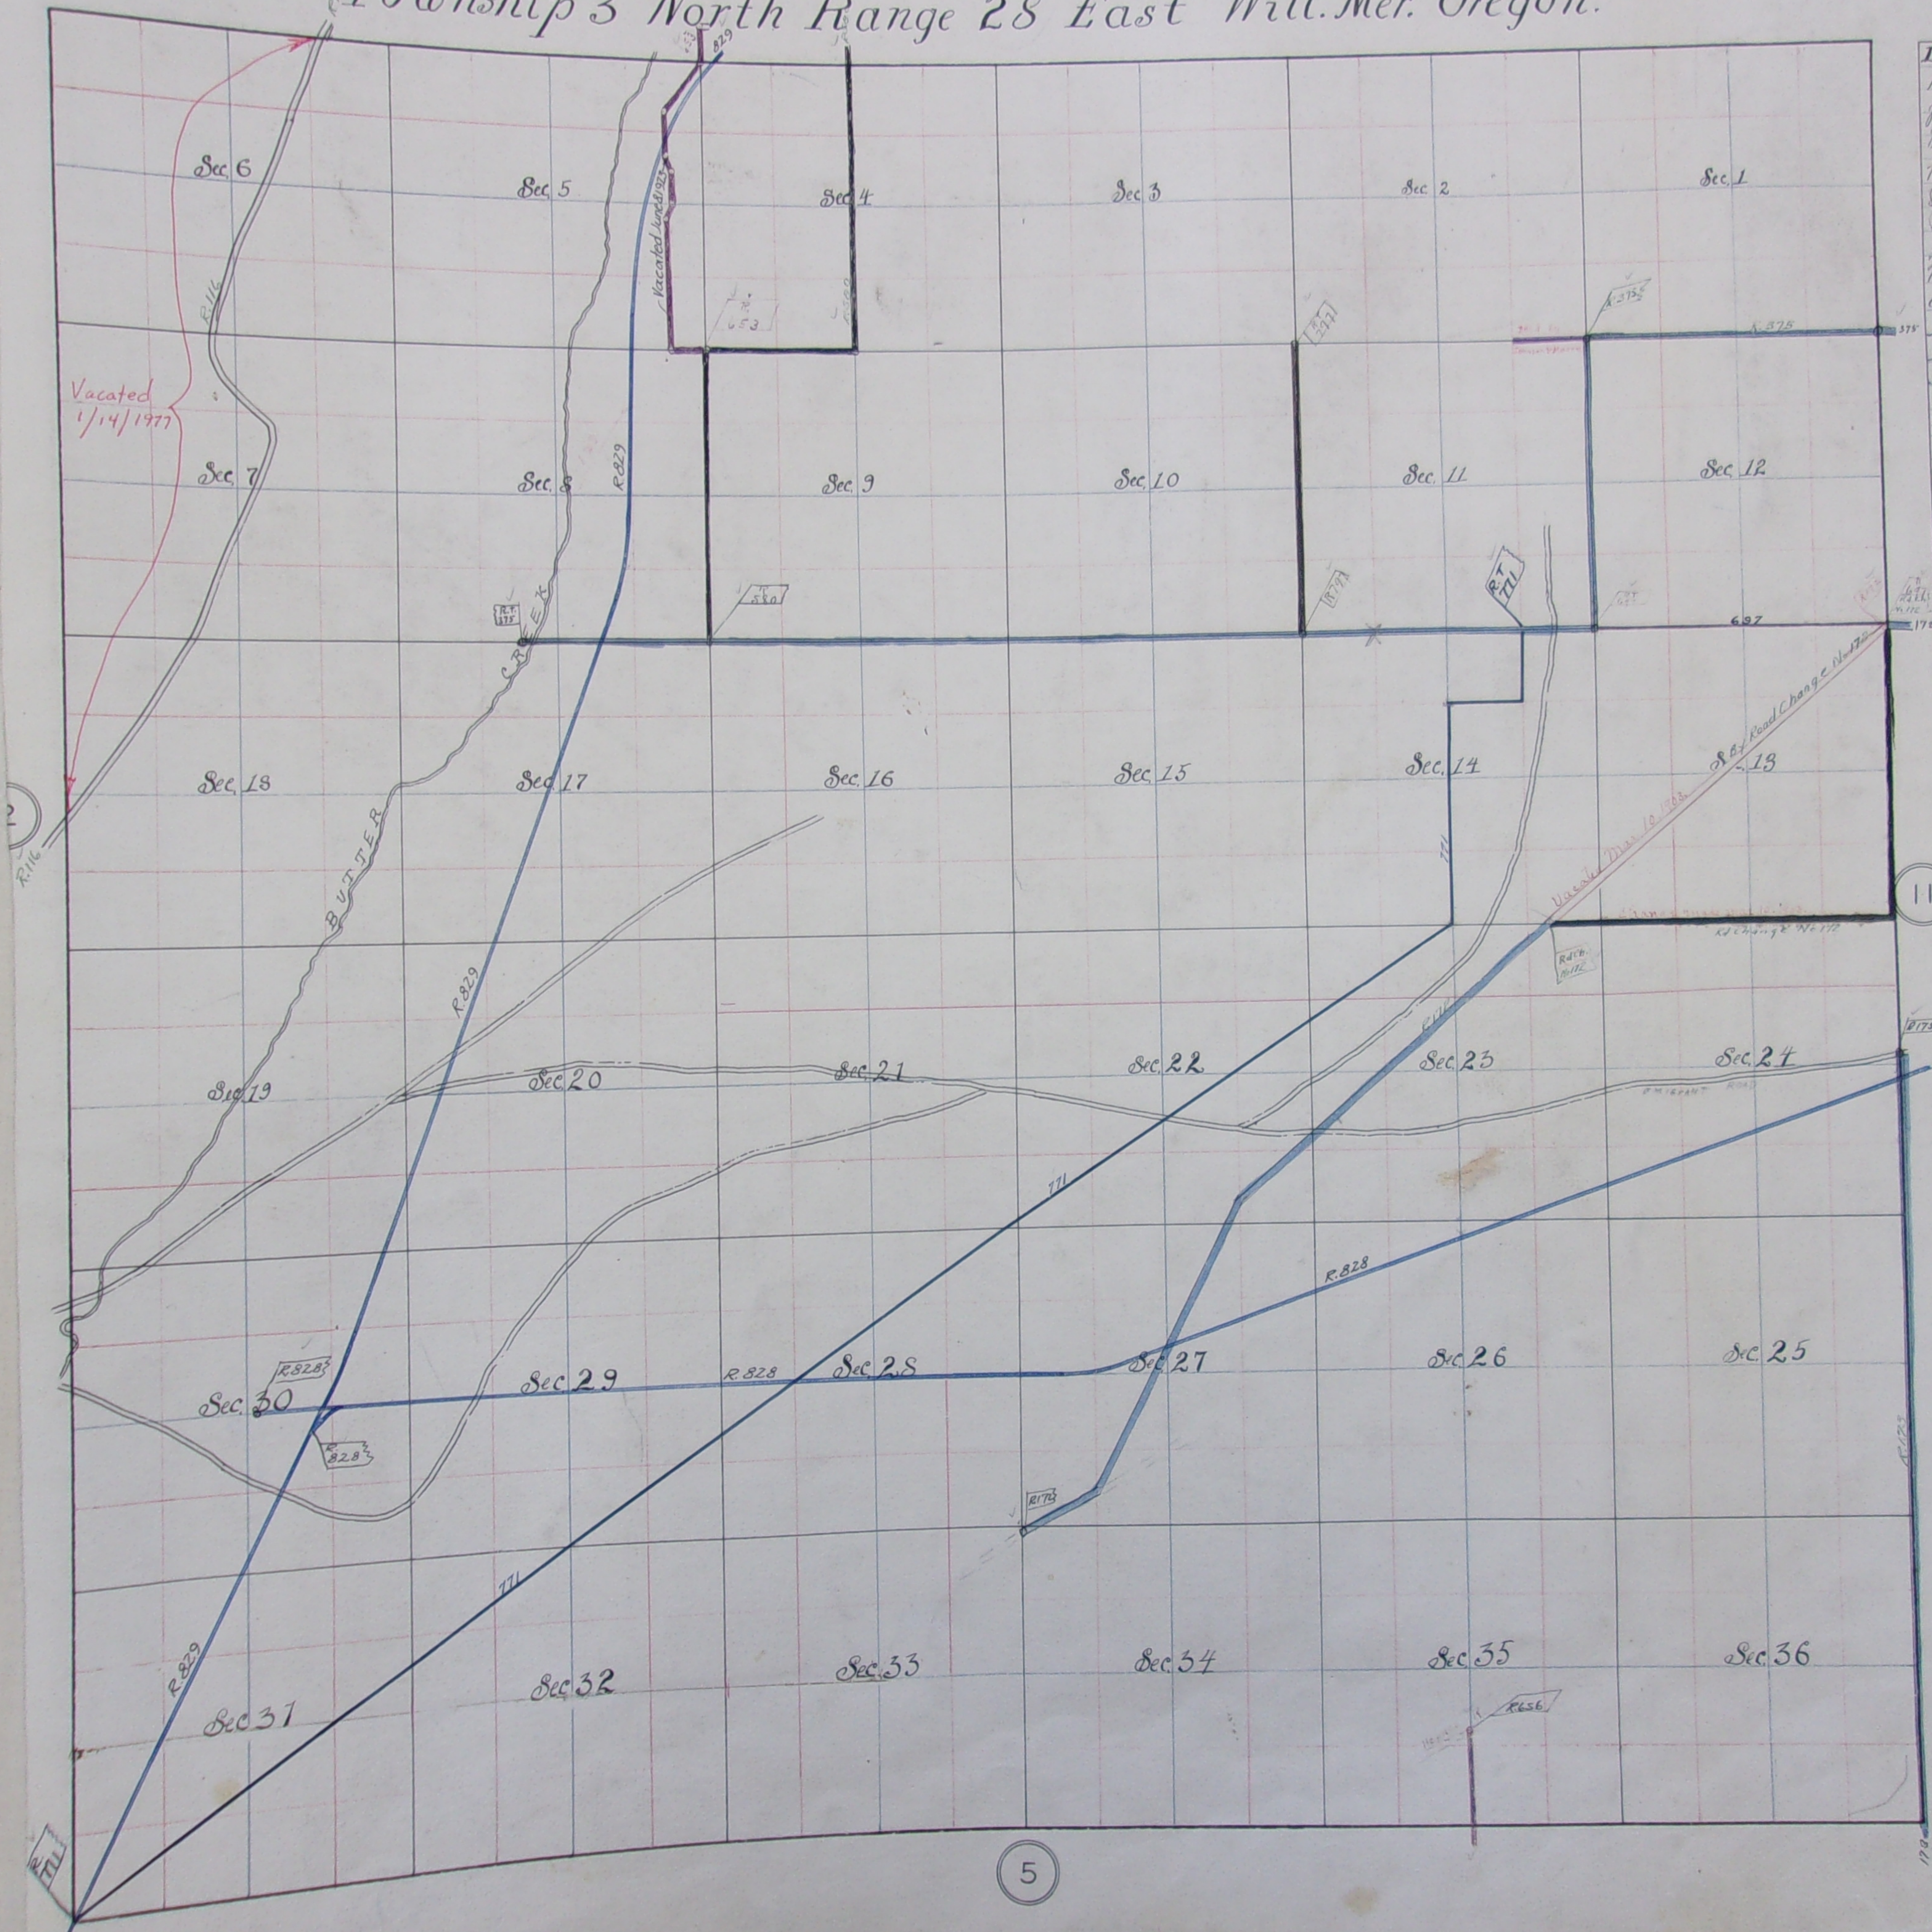

| Date | No. | Box | Book | Page | Date | No. | Box | Book | Page |
|---------------|-----------|-----|------|------|------|-----|-----|------|------|
| Nov. 1891 | 575 | 129 | J | 75 | | | | | |
| Jan. 1894 | 172 | 15 | F | 237 | | | | | |
| Jan. 1894 | 173 | 15 | F | 236 | | | | | |
| May 4, 1894 | 580 | 925 | 777 | 11 | | | | | |
| May 9, 1908 | 153 | 233 | 711 | 280 | | | | | |
| June 6, 1908 | 656 | 233 | 711 | 280 | | | | | |
| Feb. 2, 1911 | 697 | | | 510 | | | | | |
| Dec. 1911 | | | | 606 | | | | | |
| Mar. 5, 1915 | 771 | | N | 186 | | | | | |
| Aug. 9, 1919 | 797 | | N | 471 | | | | | |
| June 8, 1923 | 828 | | O | 176 | | | | | |
| June 8, 1923 | 829 | | O | 176 | | | | | |
| June 24, 1932 | 116 | | | | | | | | |
| Vacated | 1/14/1977 | | | 116 | | | | | |

True Meridian
Var. 21° East

Scale 25 chains to inch