Township 4 North Range 28 East Will. Mer. Oregon.

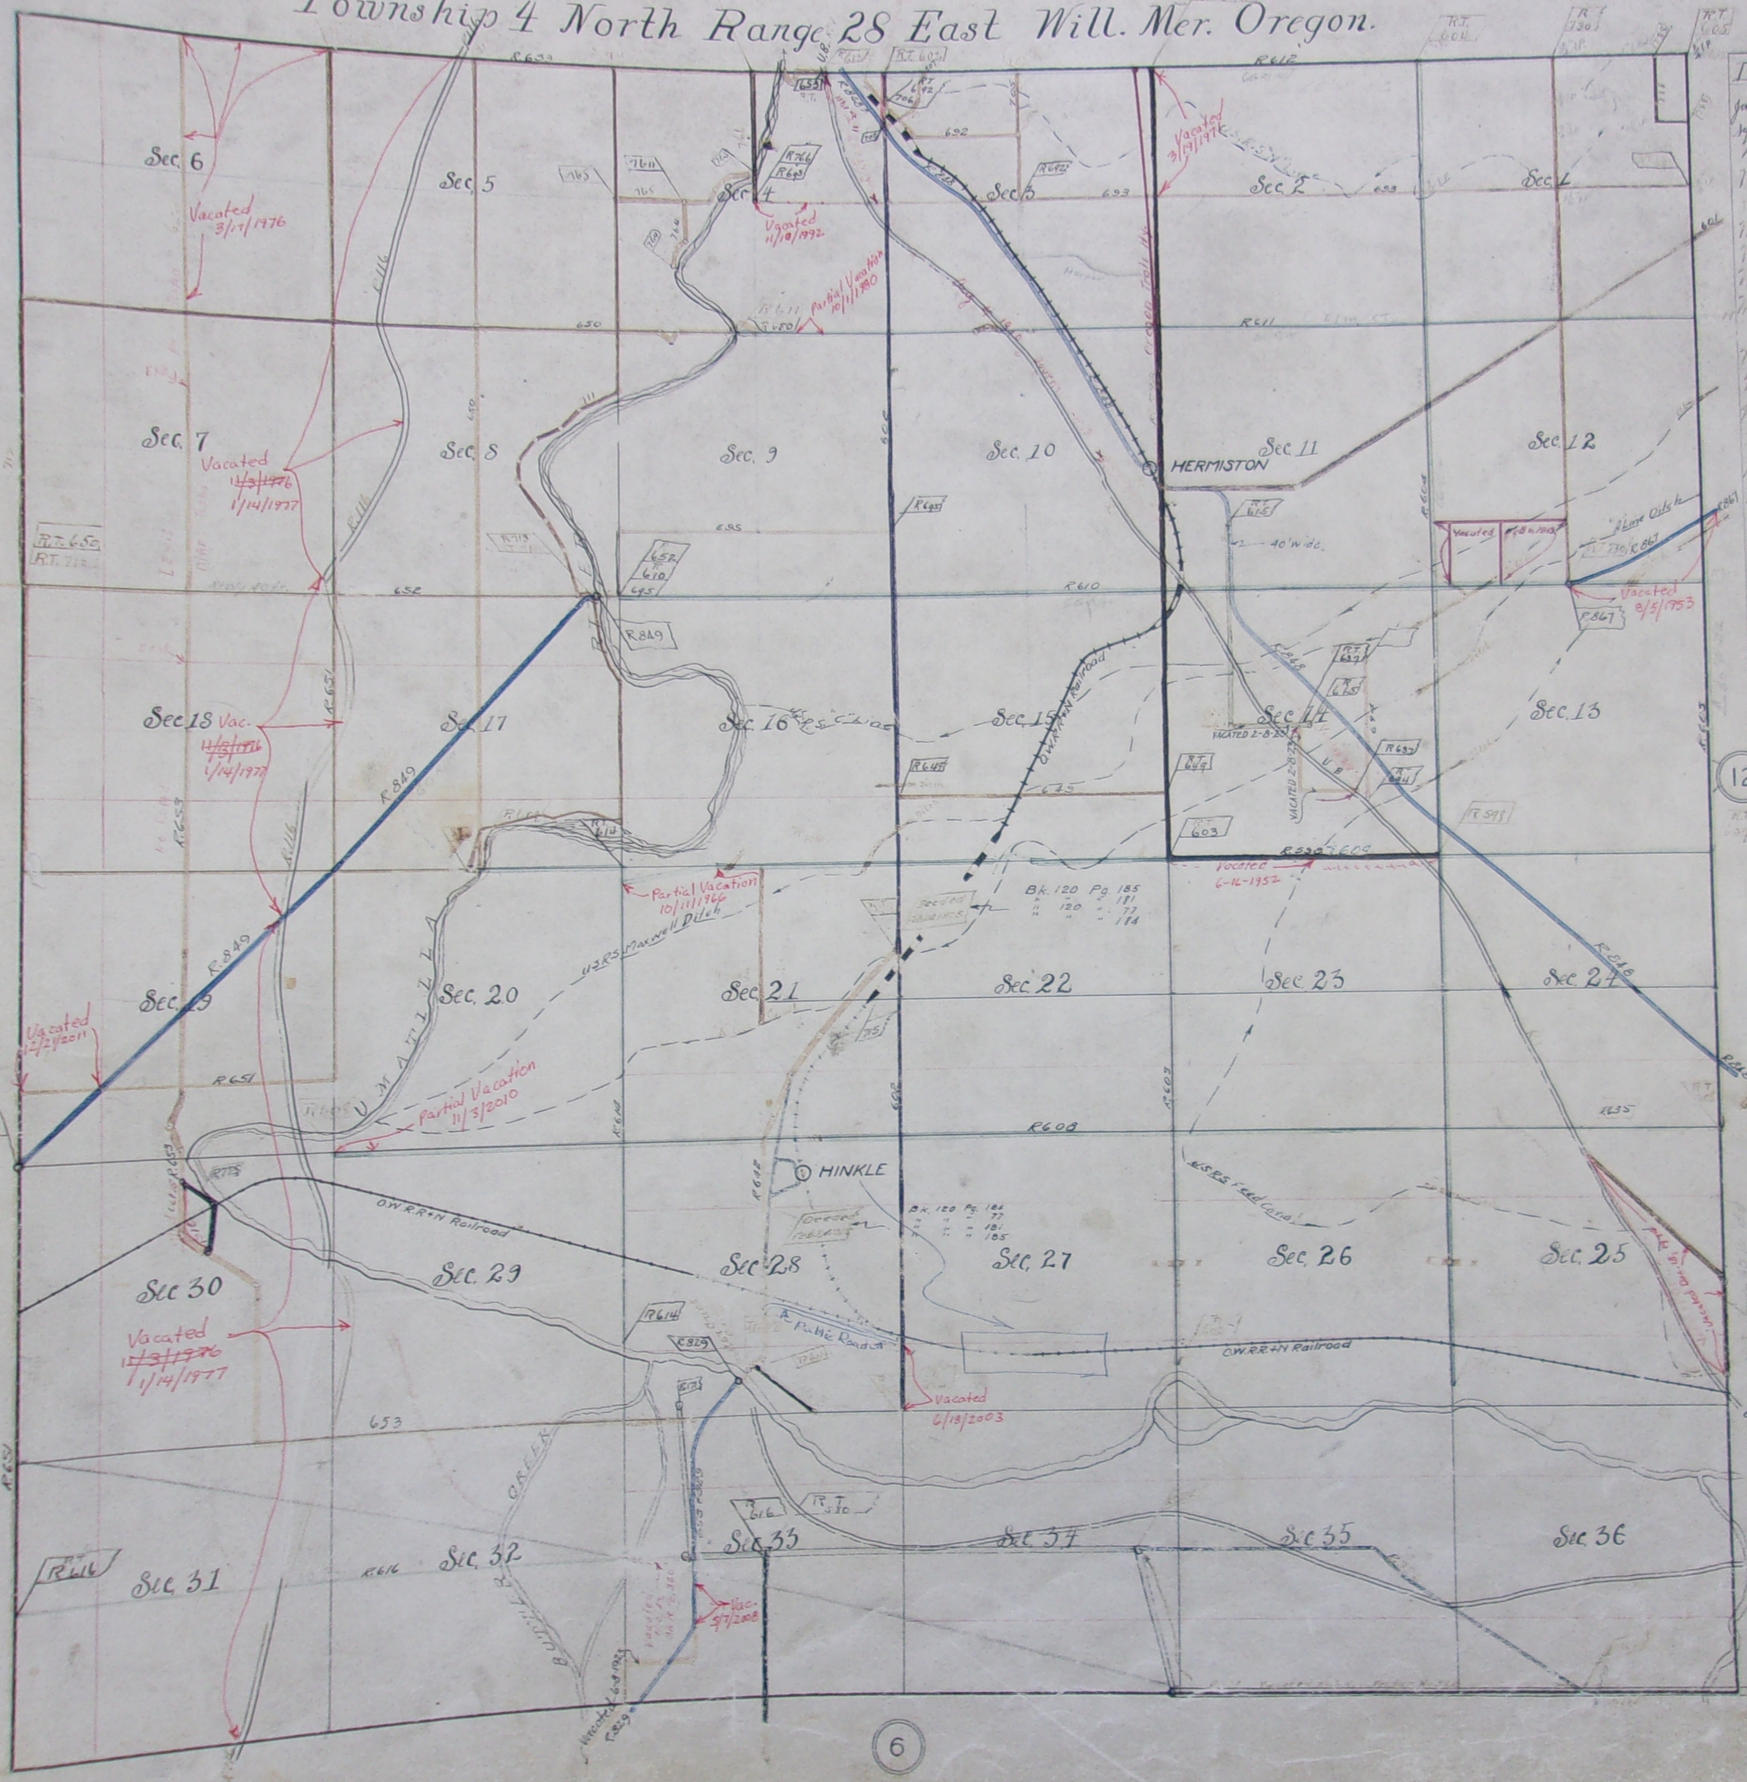

Date	No.	Box	Book	Page	Date	No.	Box	Book	Page
Jan 16 1884	171	15	F	237	June 8, 1923	829		0	176
Apr 6 1866	UB R.1		A	47	Aug. 6, 1926	867		0	
May 4, 1906	580	925	M	11	April 9, 1926	849		0	
Nov 10 1906	595	559	M	75	Dec. 3, 1926	848		0	
[illegible]					[illegible]	322			
March 8 1907	602	561	M	123	Jan 24 1882	116			
March 8 1907	603	561	M	123	Vacated Dec. 18, 1974	635			
March 8 1907	604	561	M	123	Vacated 8/5/1953	867			
March 8 1907	605	561	M	124	Vacated 12/21/2011	651			
	606	561	M	124	Vacated 5/6/1907	615			
March 8 1907	607	561	M	124	Partial Vacation 10/11/1966	609			
March 8 1907	608	561	M	125	Vacated 6-16-1952	598			
March 8 1907	609	561	M	125	Vacated 6/16/1952	609			
March 8 1907	610	561	M	125	Vacated 3/17/1976	653			
March 8 1907	611	561	M	126	Partial Vacation 10/1/1980	611			
March 8 1907	612	561	M	126	Partial Vacation 11/3/2010	608			
March 8 1907	614	561	M	127	Vacated 11/10/1992	693			
May 6 1907	615	561	M	149	Vacated 3/19/1971	598			
May 6 1907		561	M	149	Vacated 6/18/2003	602			
May 6 1907	616	561	M	149	Vacated 5/7/2008	653			
June 6 1907	679		M	167	Vacated 5/7/2008	829			
Oct 3 1907	635	679	M	212	Vacated 1/14/1977	116			
Oct 3 1907	[illegible]								
Feb 8 1908	637	233	M	245					
Feb 8 1908		233	M	246					
Feb 8 1908	642	233	M	247					
May 7 1908	649	233	M	279					
May 7 1908	650	233	M	279					
May 7 1908	651	233	M	279					
[illegible]	[illegible]	233	M	280					
[illegible]	[illegible]	233	M	280					
Aug. 4 1910	692		M	473					
Aug. 4 1910	694		M	474					
Sept. 3, 1910	693		M	483					
Dec. 10 1910	695		M	500					
June 1911	713		M	540					
June 1911	711		M	539					
" "	705		M	538					
" "	712		M	539					
" "	704		M	538					
Oct 6	707			592					
Nov 2	730			597					
May 7 1914	4		M	145					
" 7 1914	765			145					
" 7 1914	766			145					
Dec 2 1915	775			217					
Oct 2 1916	768			398					

Scale 25 Chains to 1 inch