


(11)

Township 2 North Range 29 East Will. Mer. Oregon.

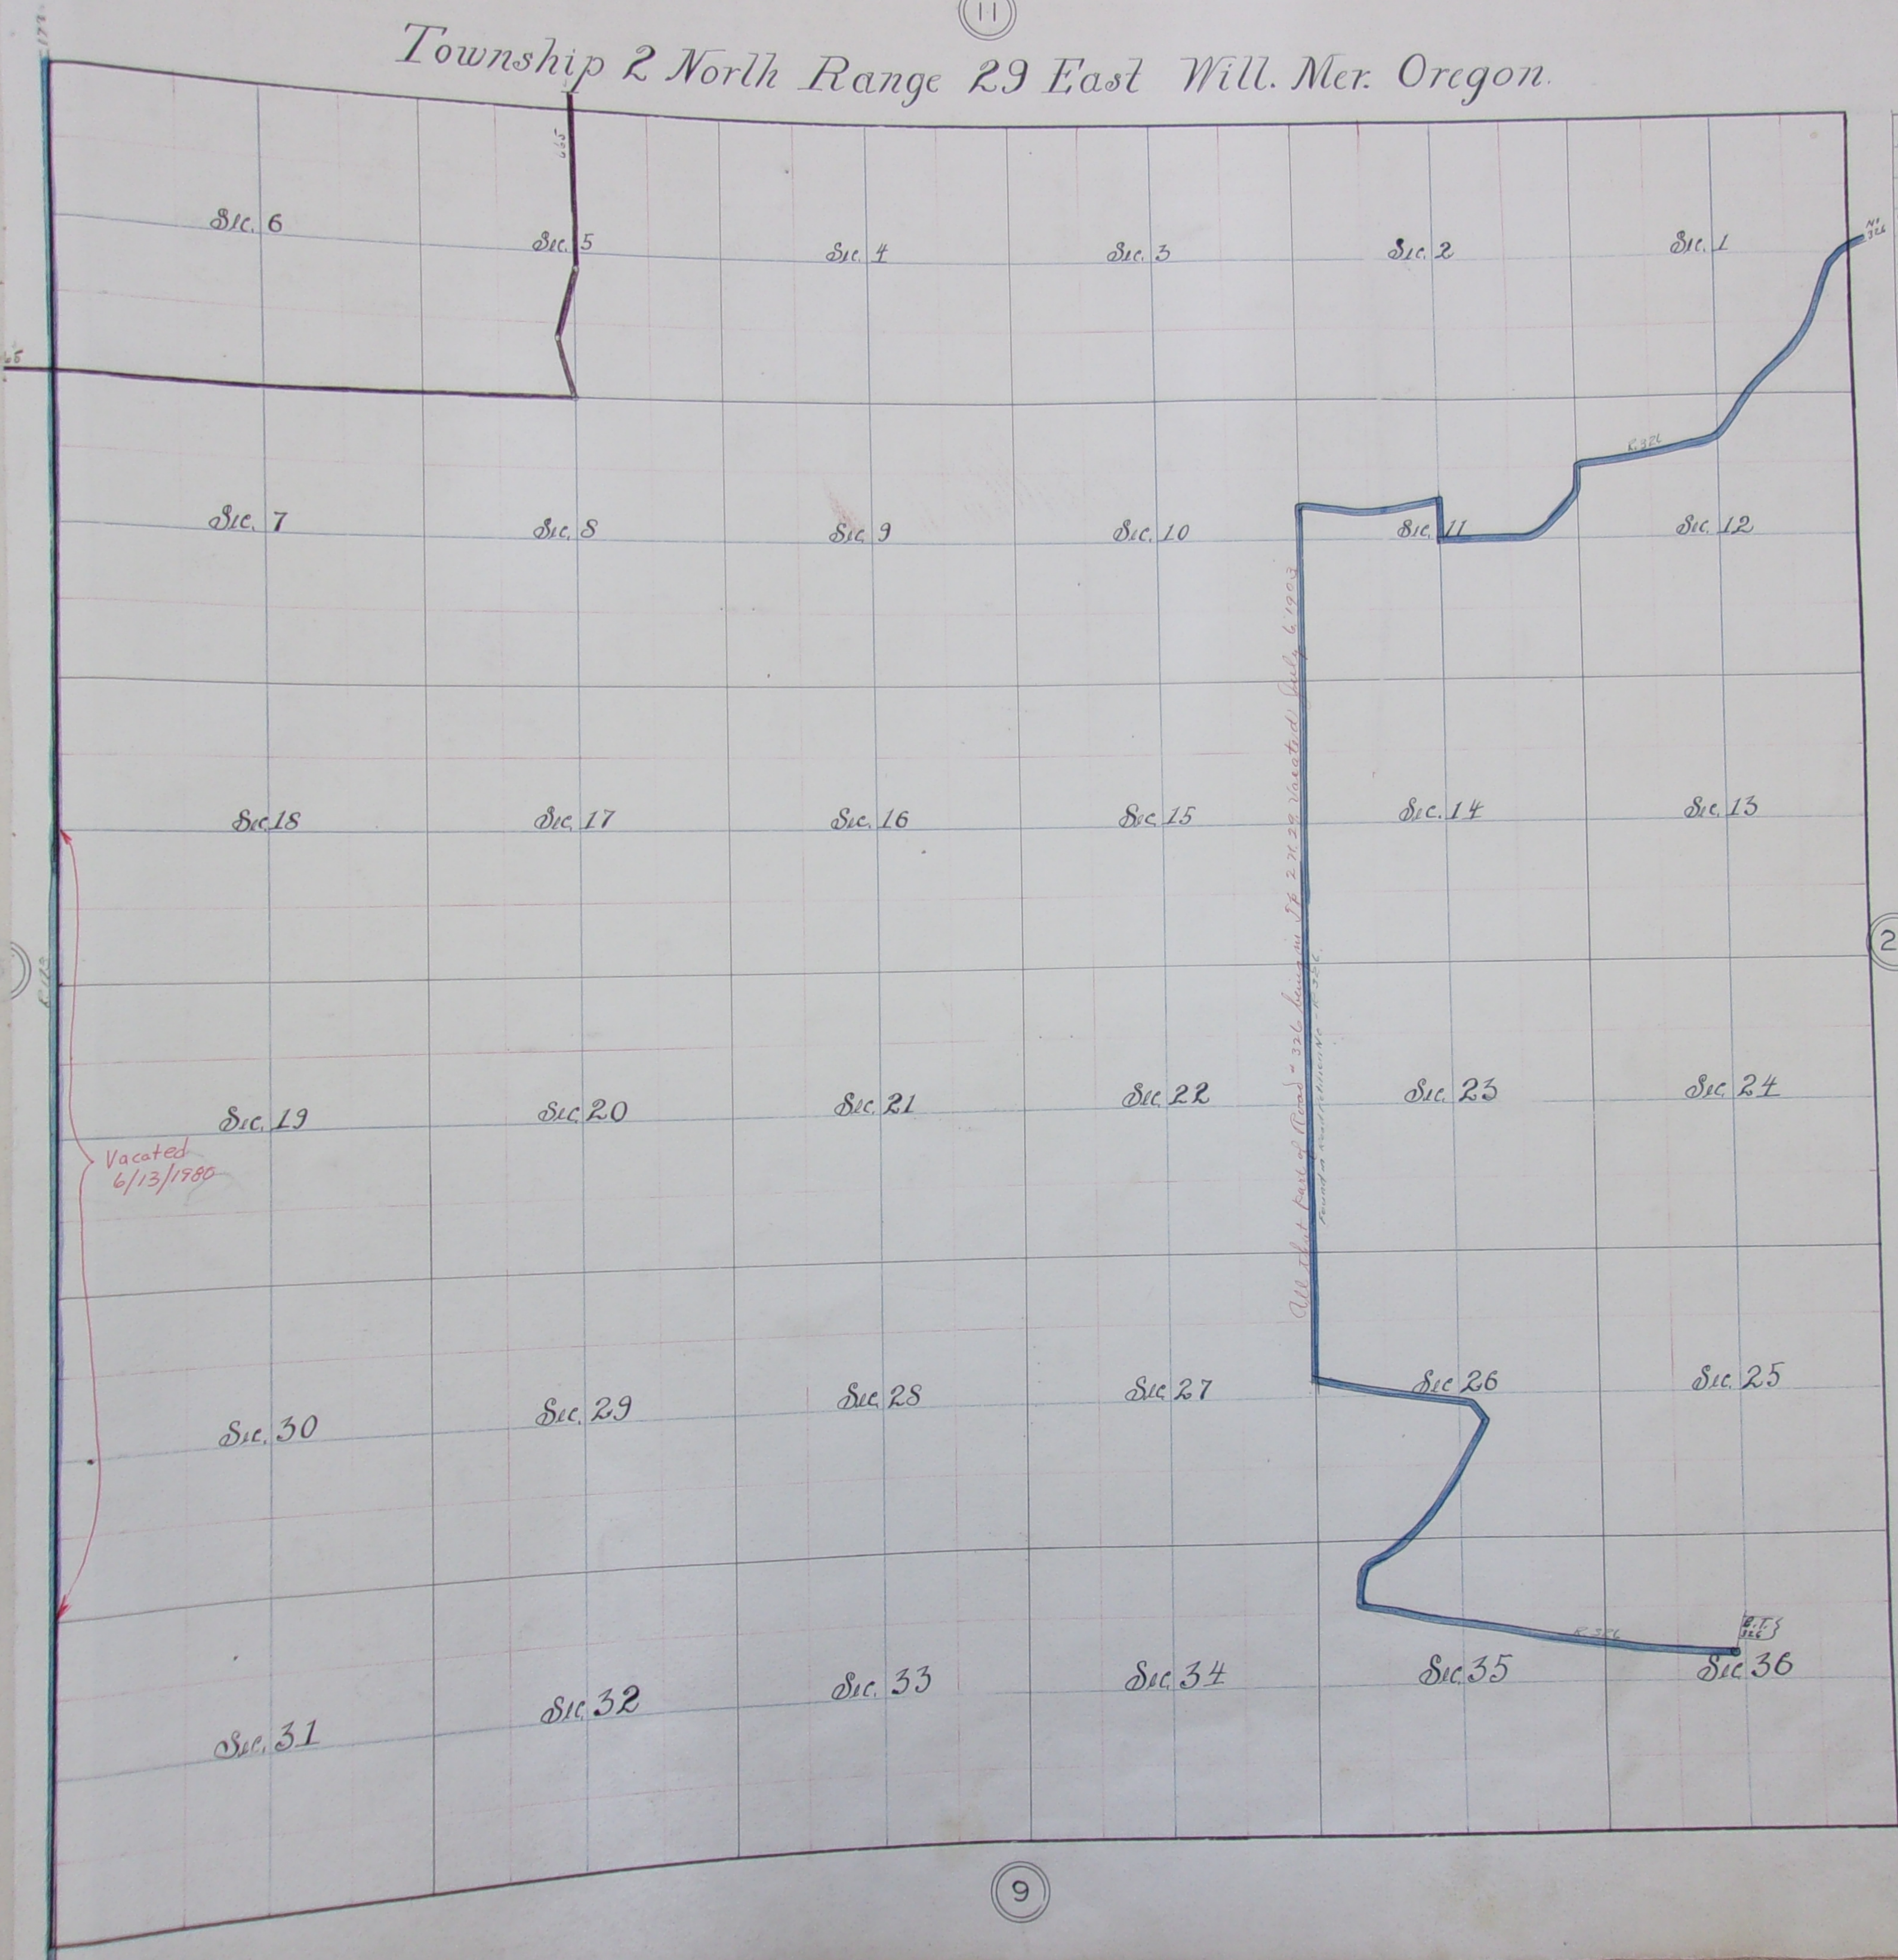

Date	No.	Box	Book	Page	Date	No.	Box	Book	Page
May 10 1889	326	18	H	339					
Jan 16 1884	173	15	F	236					
June 8 1909	665		771	270					
Vacated	173								

(21)

True Meridian  
Var. 21° East

Scale 25 chains to 2 inch

(9)