(12)

Township 3 North Range 29 East Will. Mer. Oregon.

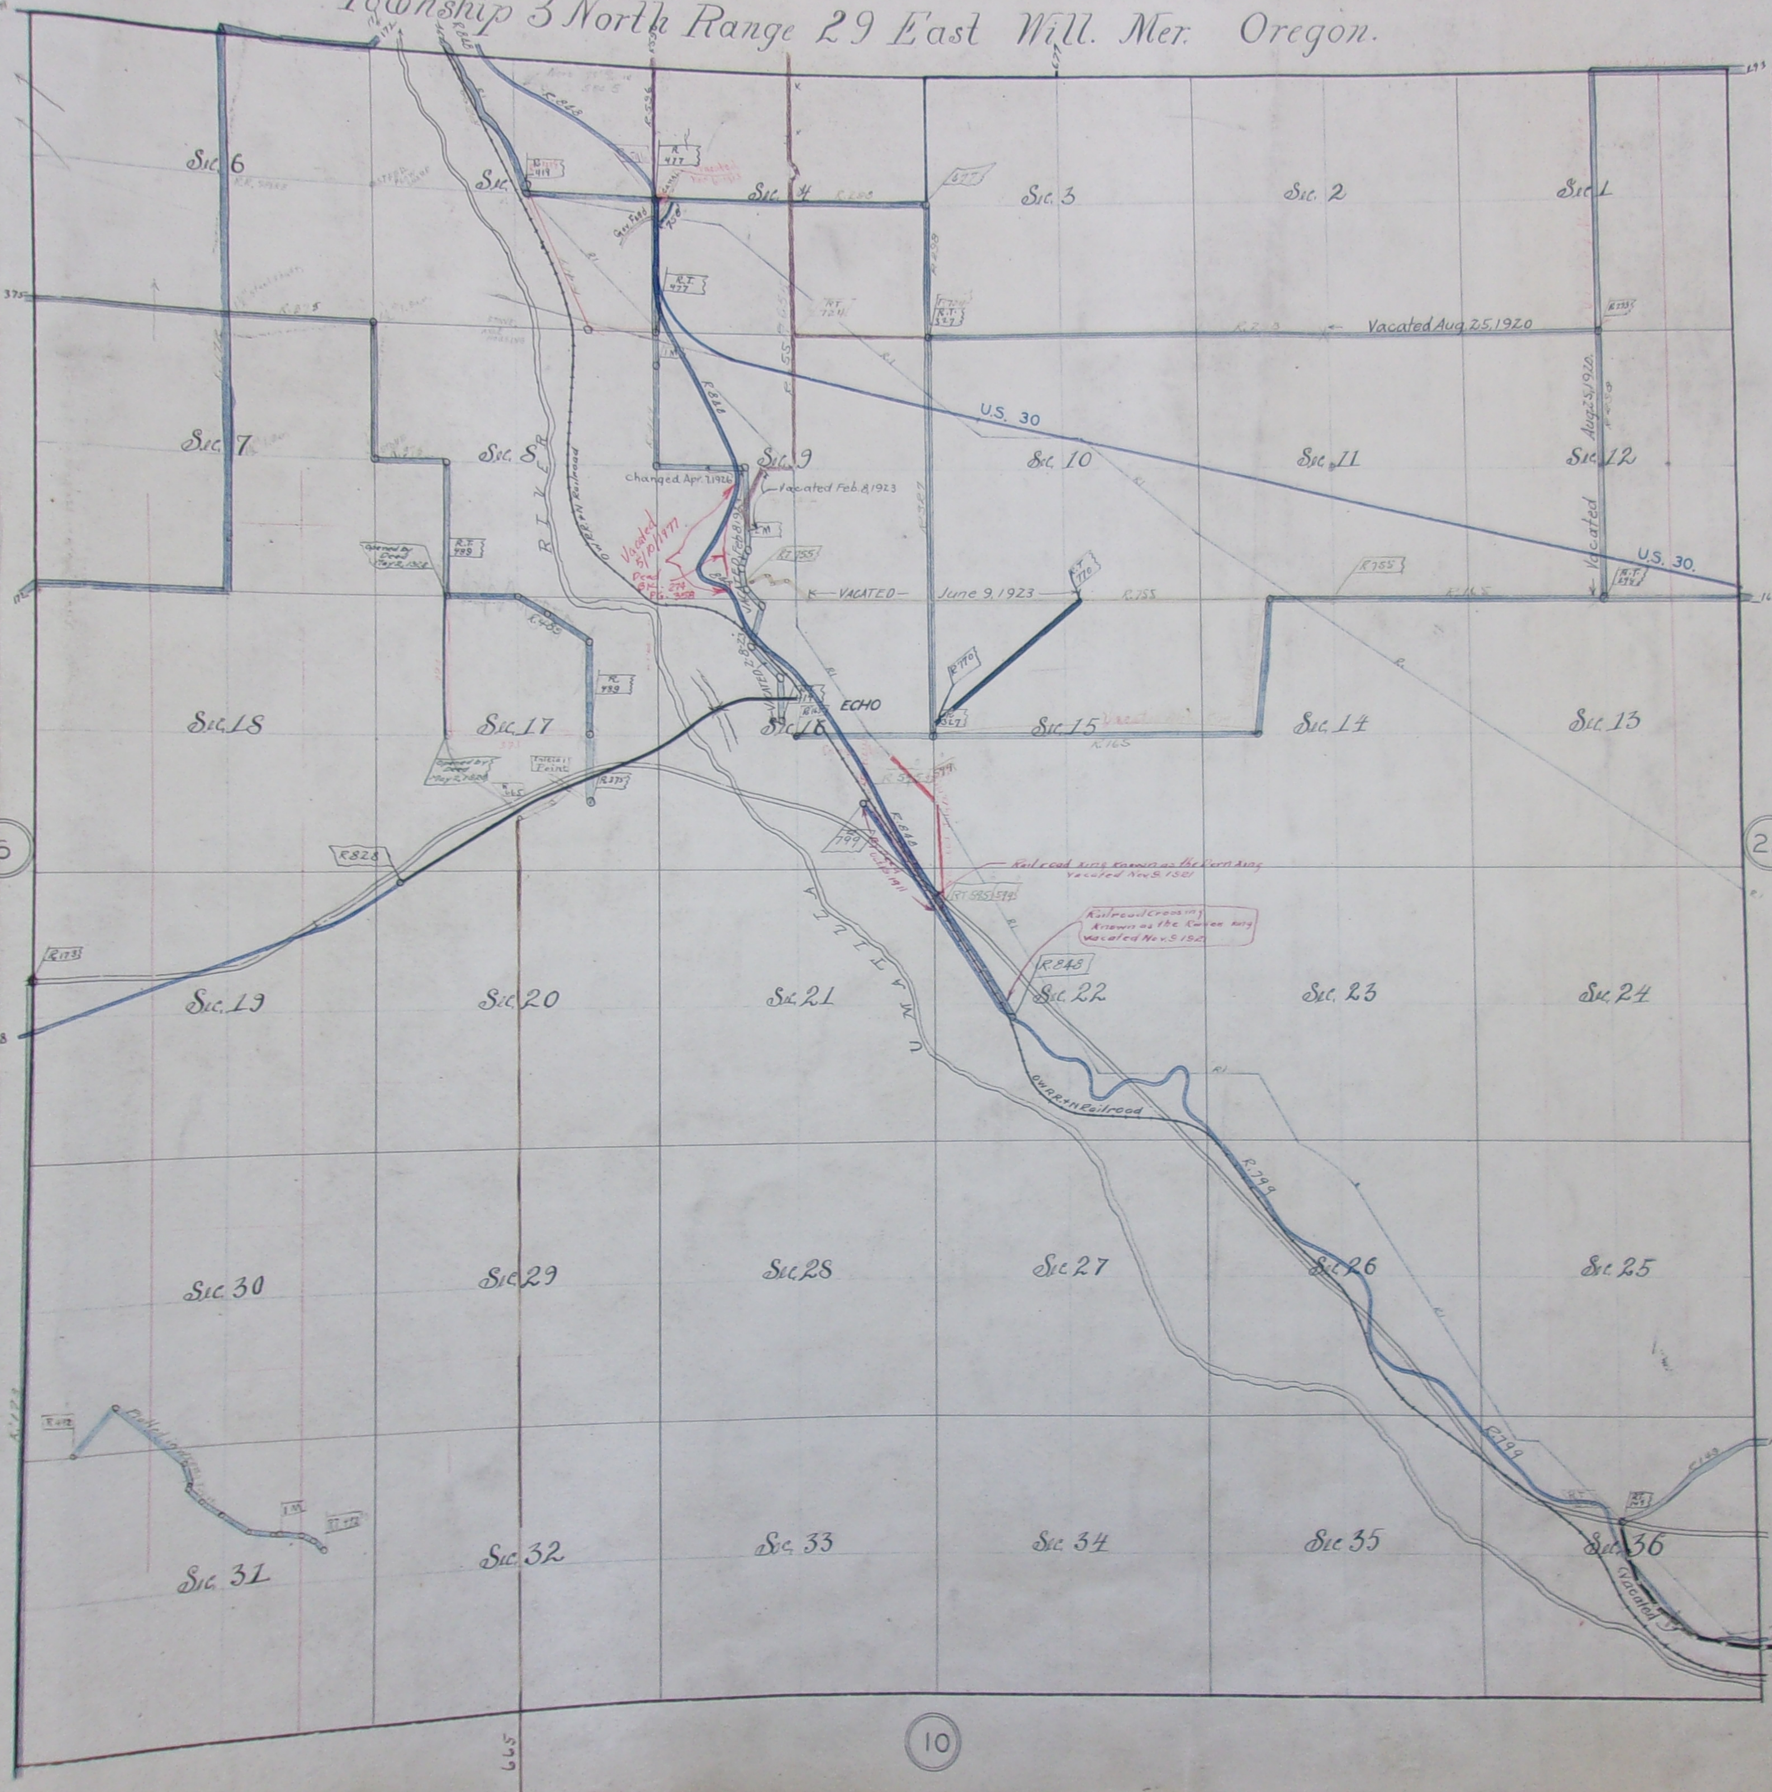

Date	No.	Box	Book	Page	Date	No.	Box	Book	Page
Mar 6th 1896	477	133	J	534					
Sept 9th 1897	489	134	K	155					
May 5th 1893	419	131	J	489					
Mar 6 1896	419	133	J	534					
Sept 9th 1897	375	134	K	155					
Nov. 6 1891	375	129	J	75					
July 5 1889	327	18	H	384					
Sept 26 1887	298	19	G	681					
Sept 26 1887	293	20	G	629					
Jan 16 1884	172	15	F	237					
Jan 16 1884	165	15	F	238					
Jan 16 1884	173	15	F	236					
July 10 1883	149	14	F	51					
Mar. 11 1898	492		K	258					
	595								
	975								
	Red Mountain		M	62					
Sept 10 1906	591	918	M	13					
Aug 10 1906	590	918	M	56					
Nov. 9, 1906	599								
June 6 1908	655	233	M	289					
June 8 1909	665		M	370					
Feb 4, 1910	677								
Aug 3 1911	724		M	569					
Sept 5 1913	755		N	103					
Nov 6 1913	758		N						
Mar 5 1915	770		N	186					
June 8 1923	828		O	176					
Jan. 9 1920	799		N						
Dec. 3 1926	848		O						
Dec. 31 1884	171								
Sept 6 1866	1								
Vacated 5/10/1977	848								

(22)

(10)