


Township 1 South Range 30 East Will. Mer Oregon

T. 1 S. R. 30 E. W. M.

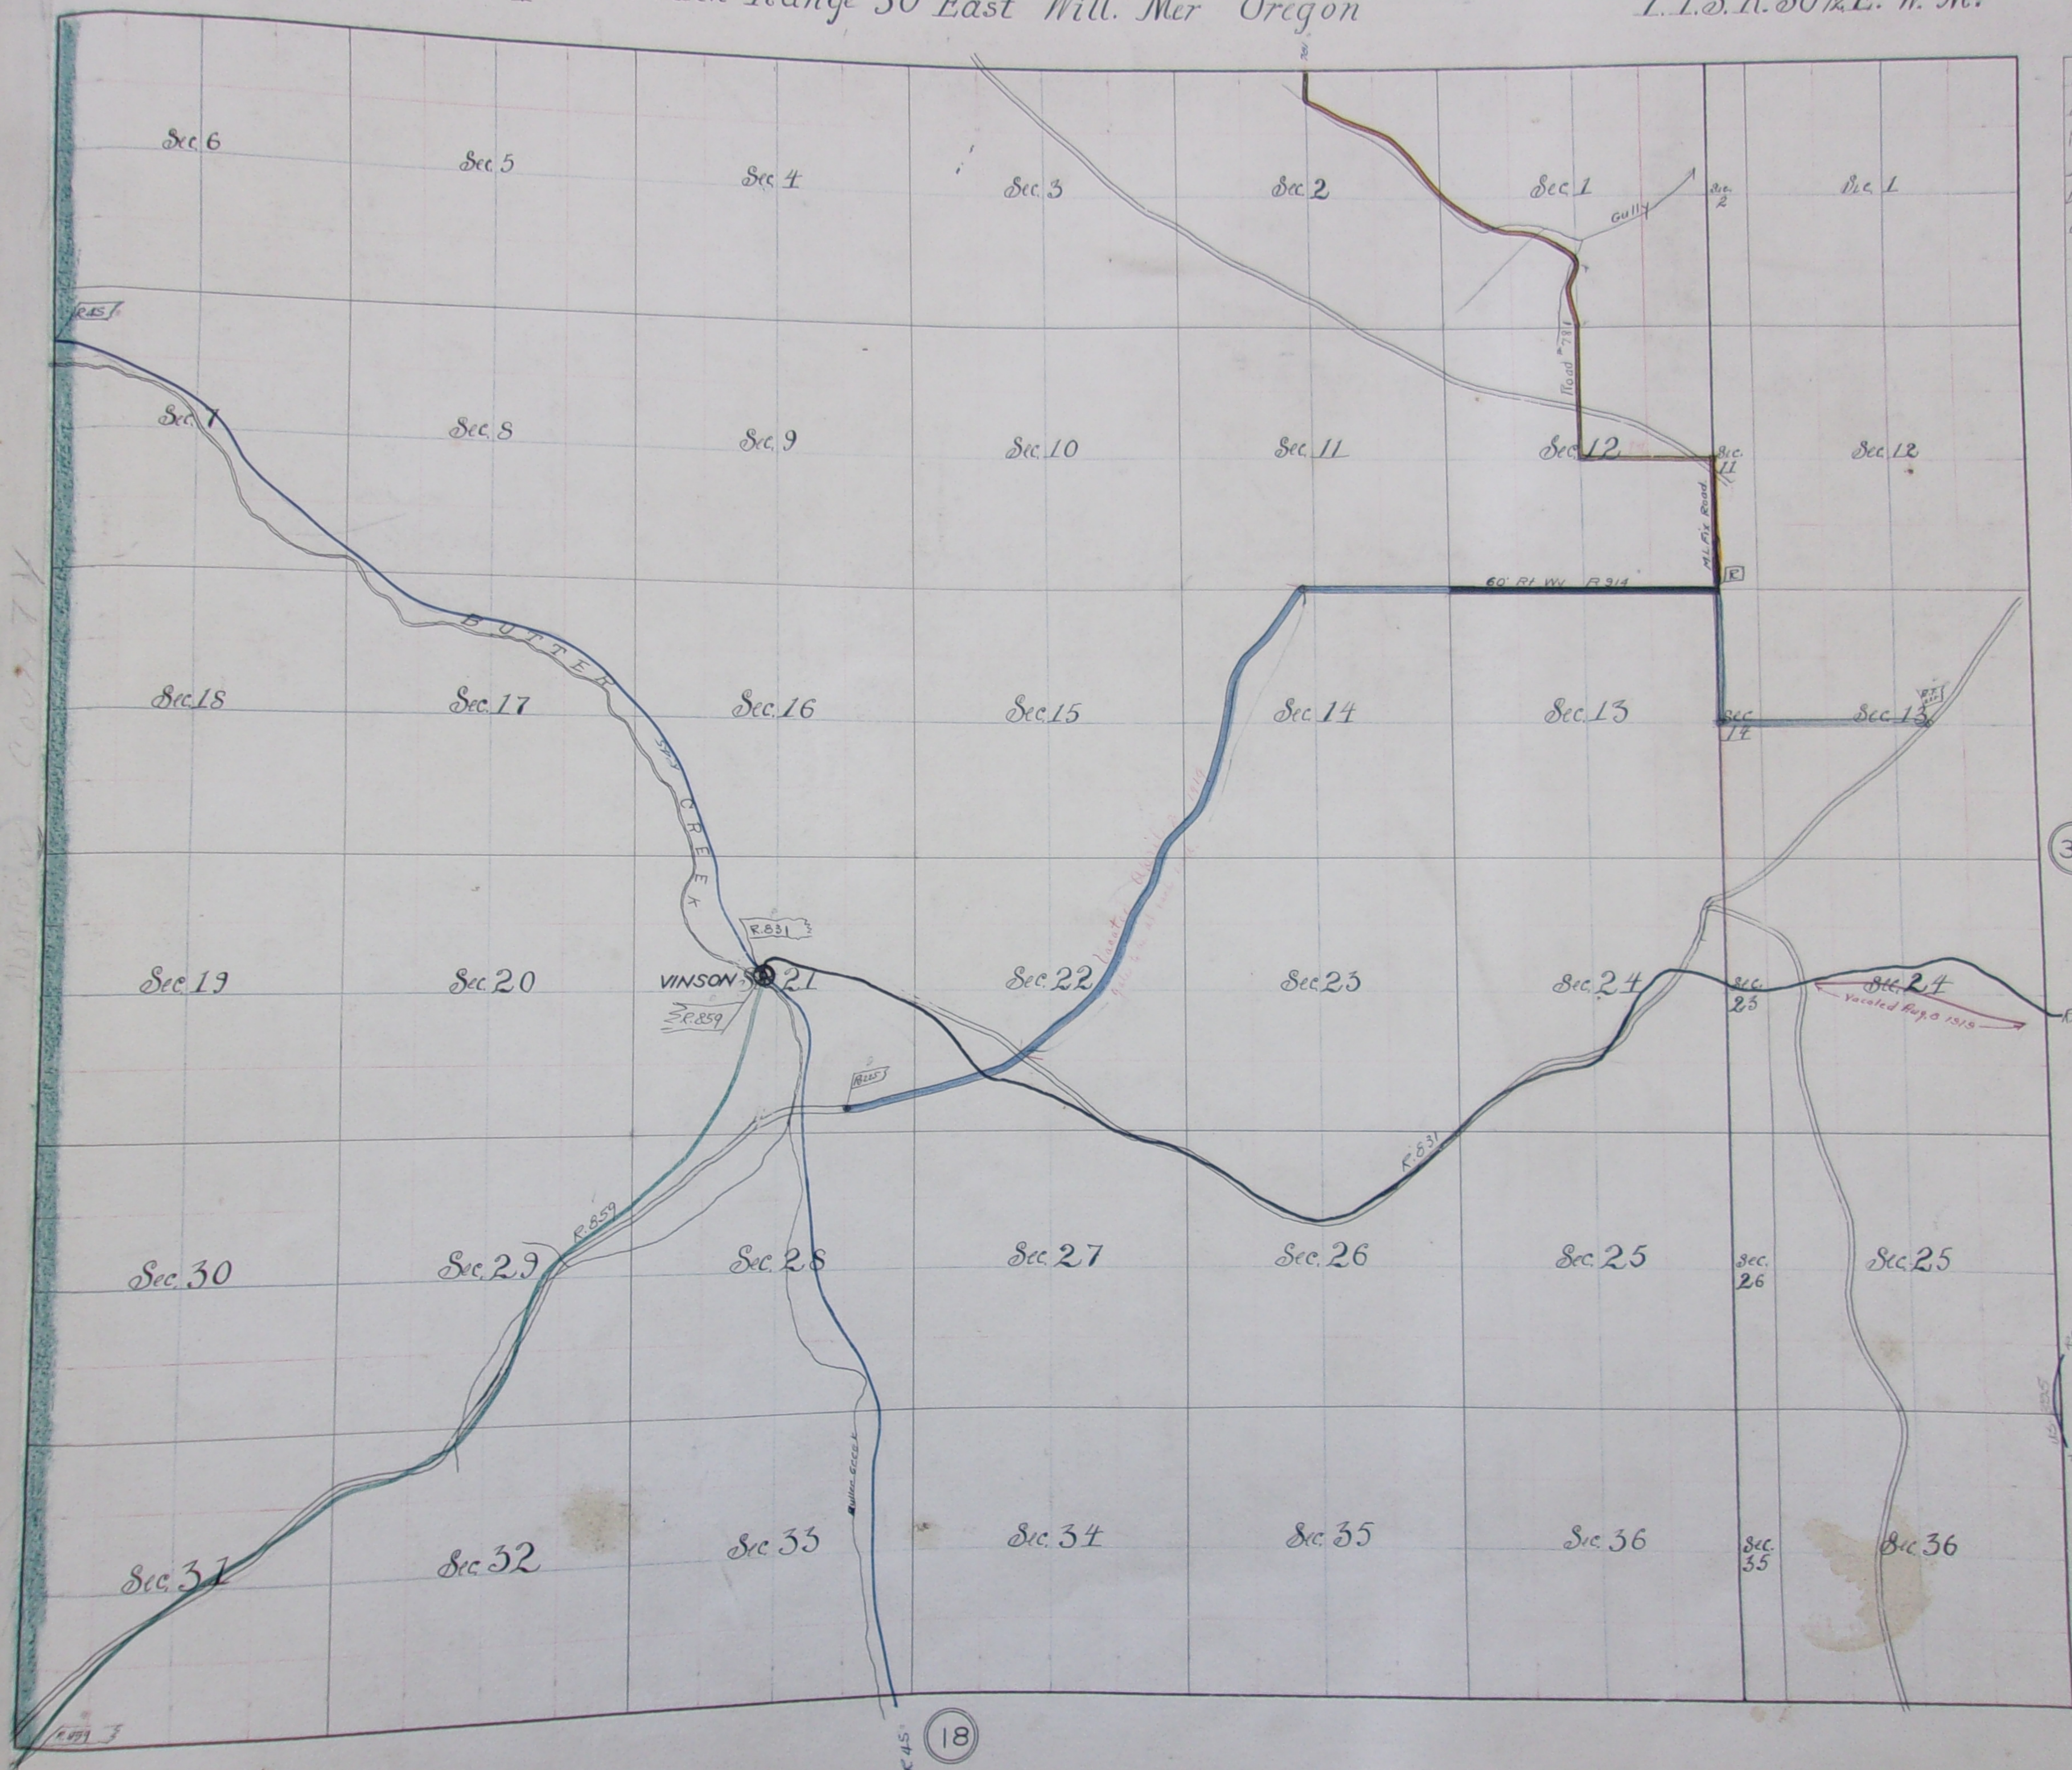

Date	No	Book	Page
Apr 10 1884	225	F	574
Nov. 2, 1916	781	N	289
July 11, 1923	831		
Dec 23, 1925	859		
Oct 15, 1923	834		


30

18

True Meridian  
True from point 21 to 24

Scale as shown on 21 & 24