


Township 2 North Range 30 East Will. Mer. Oregon.

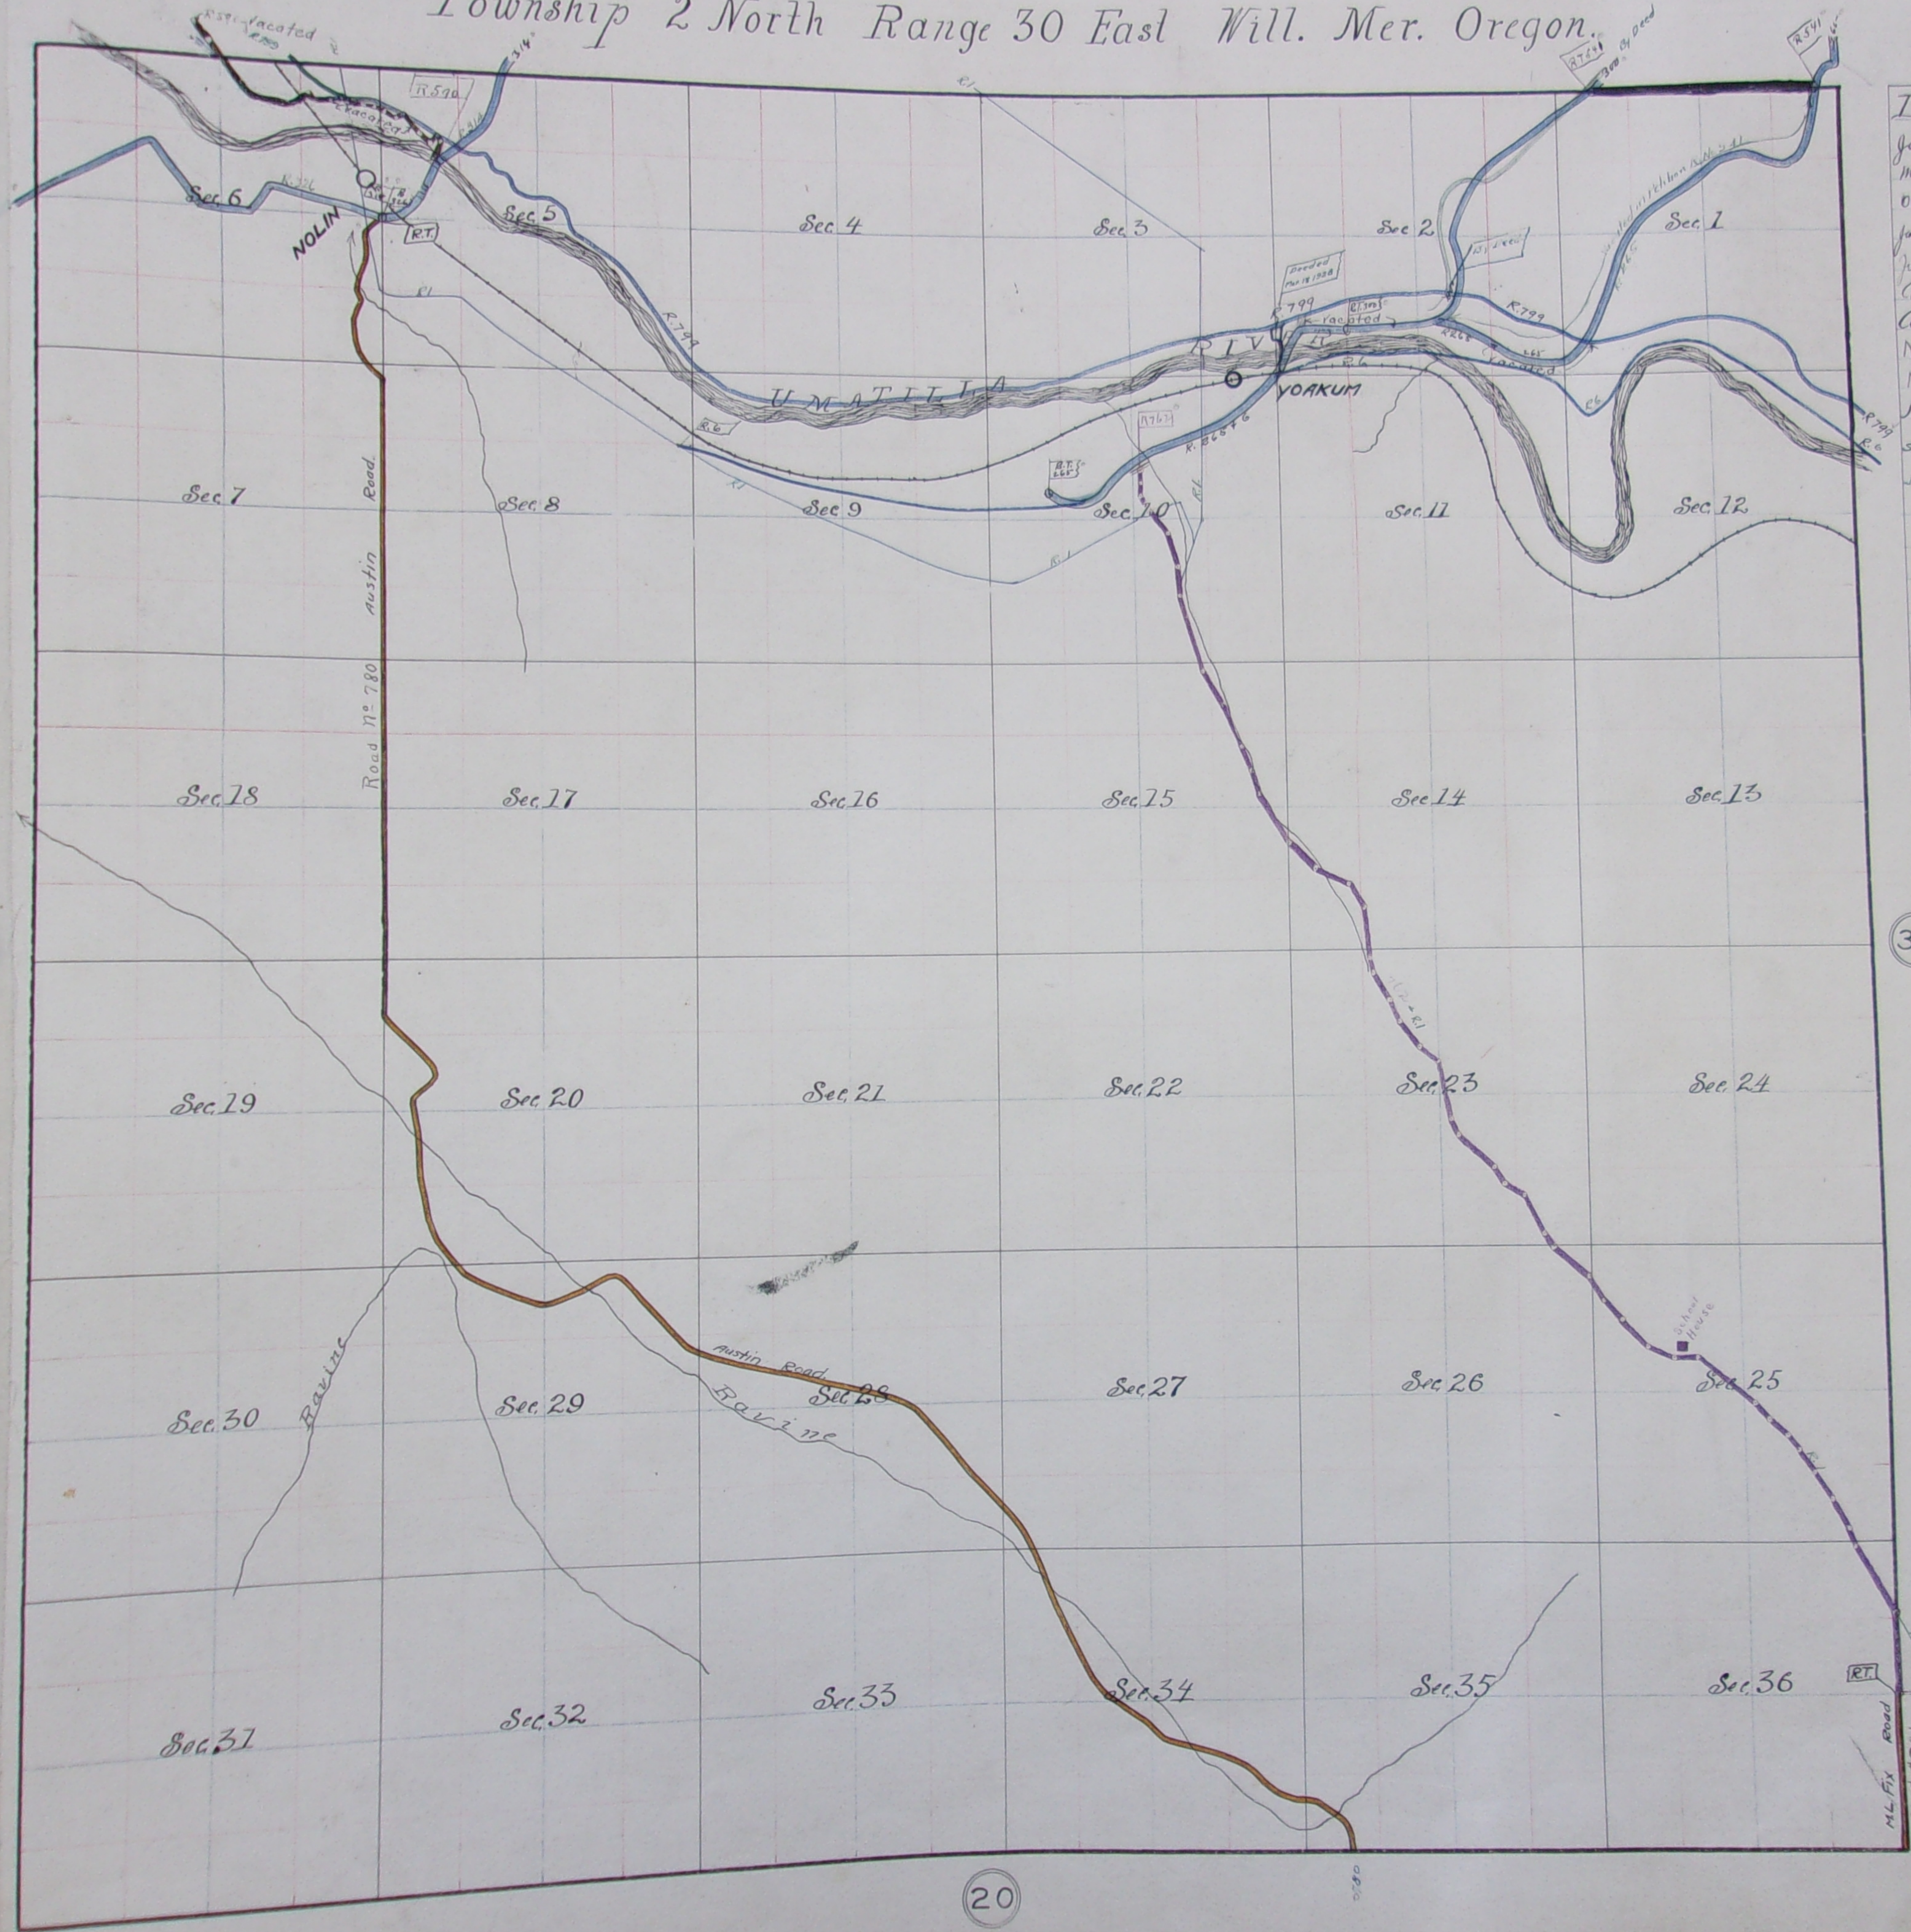

Date	No.	Box	Book	Page	Date	No.	Box	Book	Page
Jan 9 1888	302	129	G	275					
May 10 1887	326	78	H	339					
Oct 6 1886	265	78	G	398					
Jan 15 1889	314	124	H	224					
July 10 1902	541		L	241					
Aug 10 1901	590	918	711	56					
Apr 6 1914	762		N						
Nov 2 1916	780		N	289					
Nov "	781		N	289					
Jan 9 1920	799		N						
Sept 1 1886	1								
July 1870	6								

Scale 25 chs. to 1 inch