


Township 5 North Range 30 East Will. Mer. Oregon.

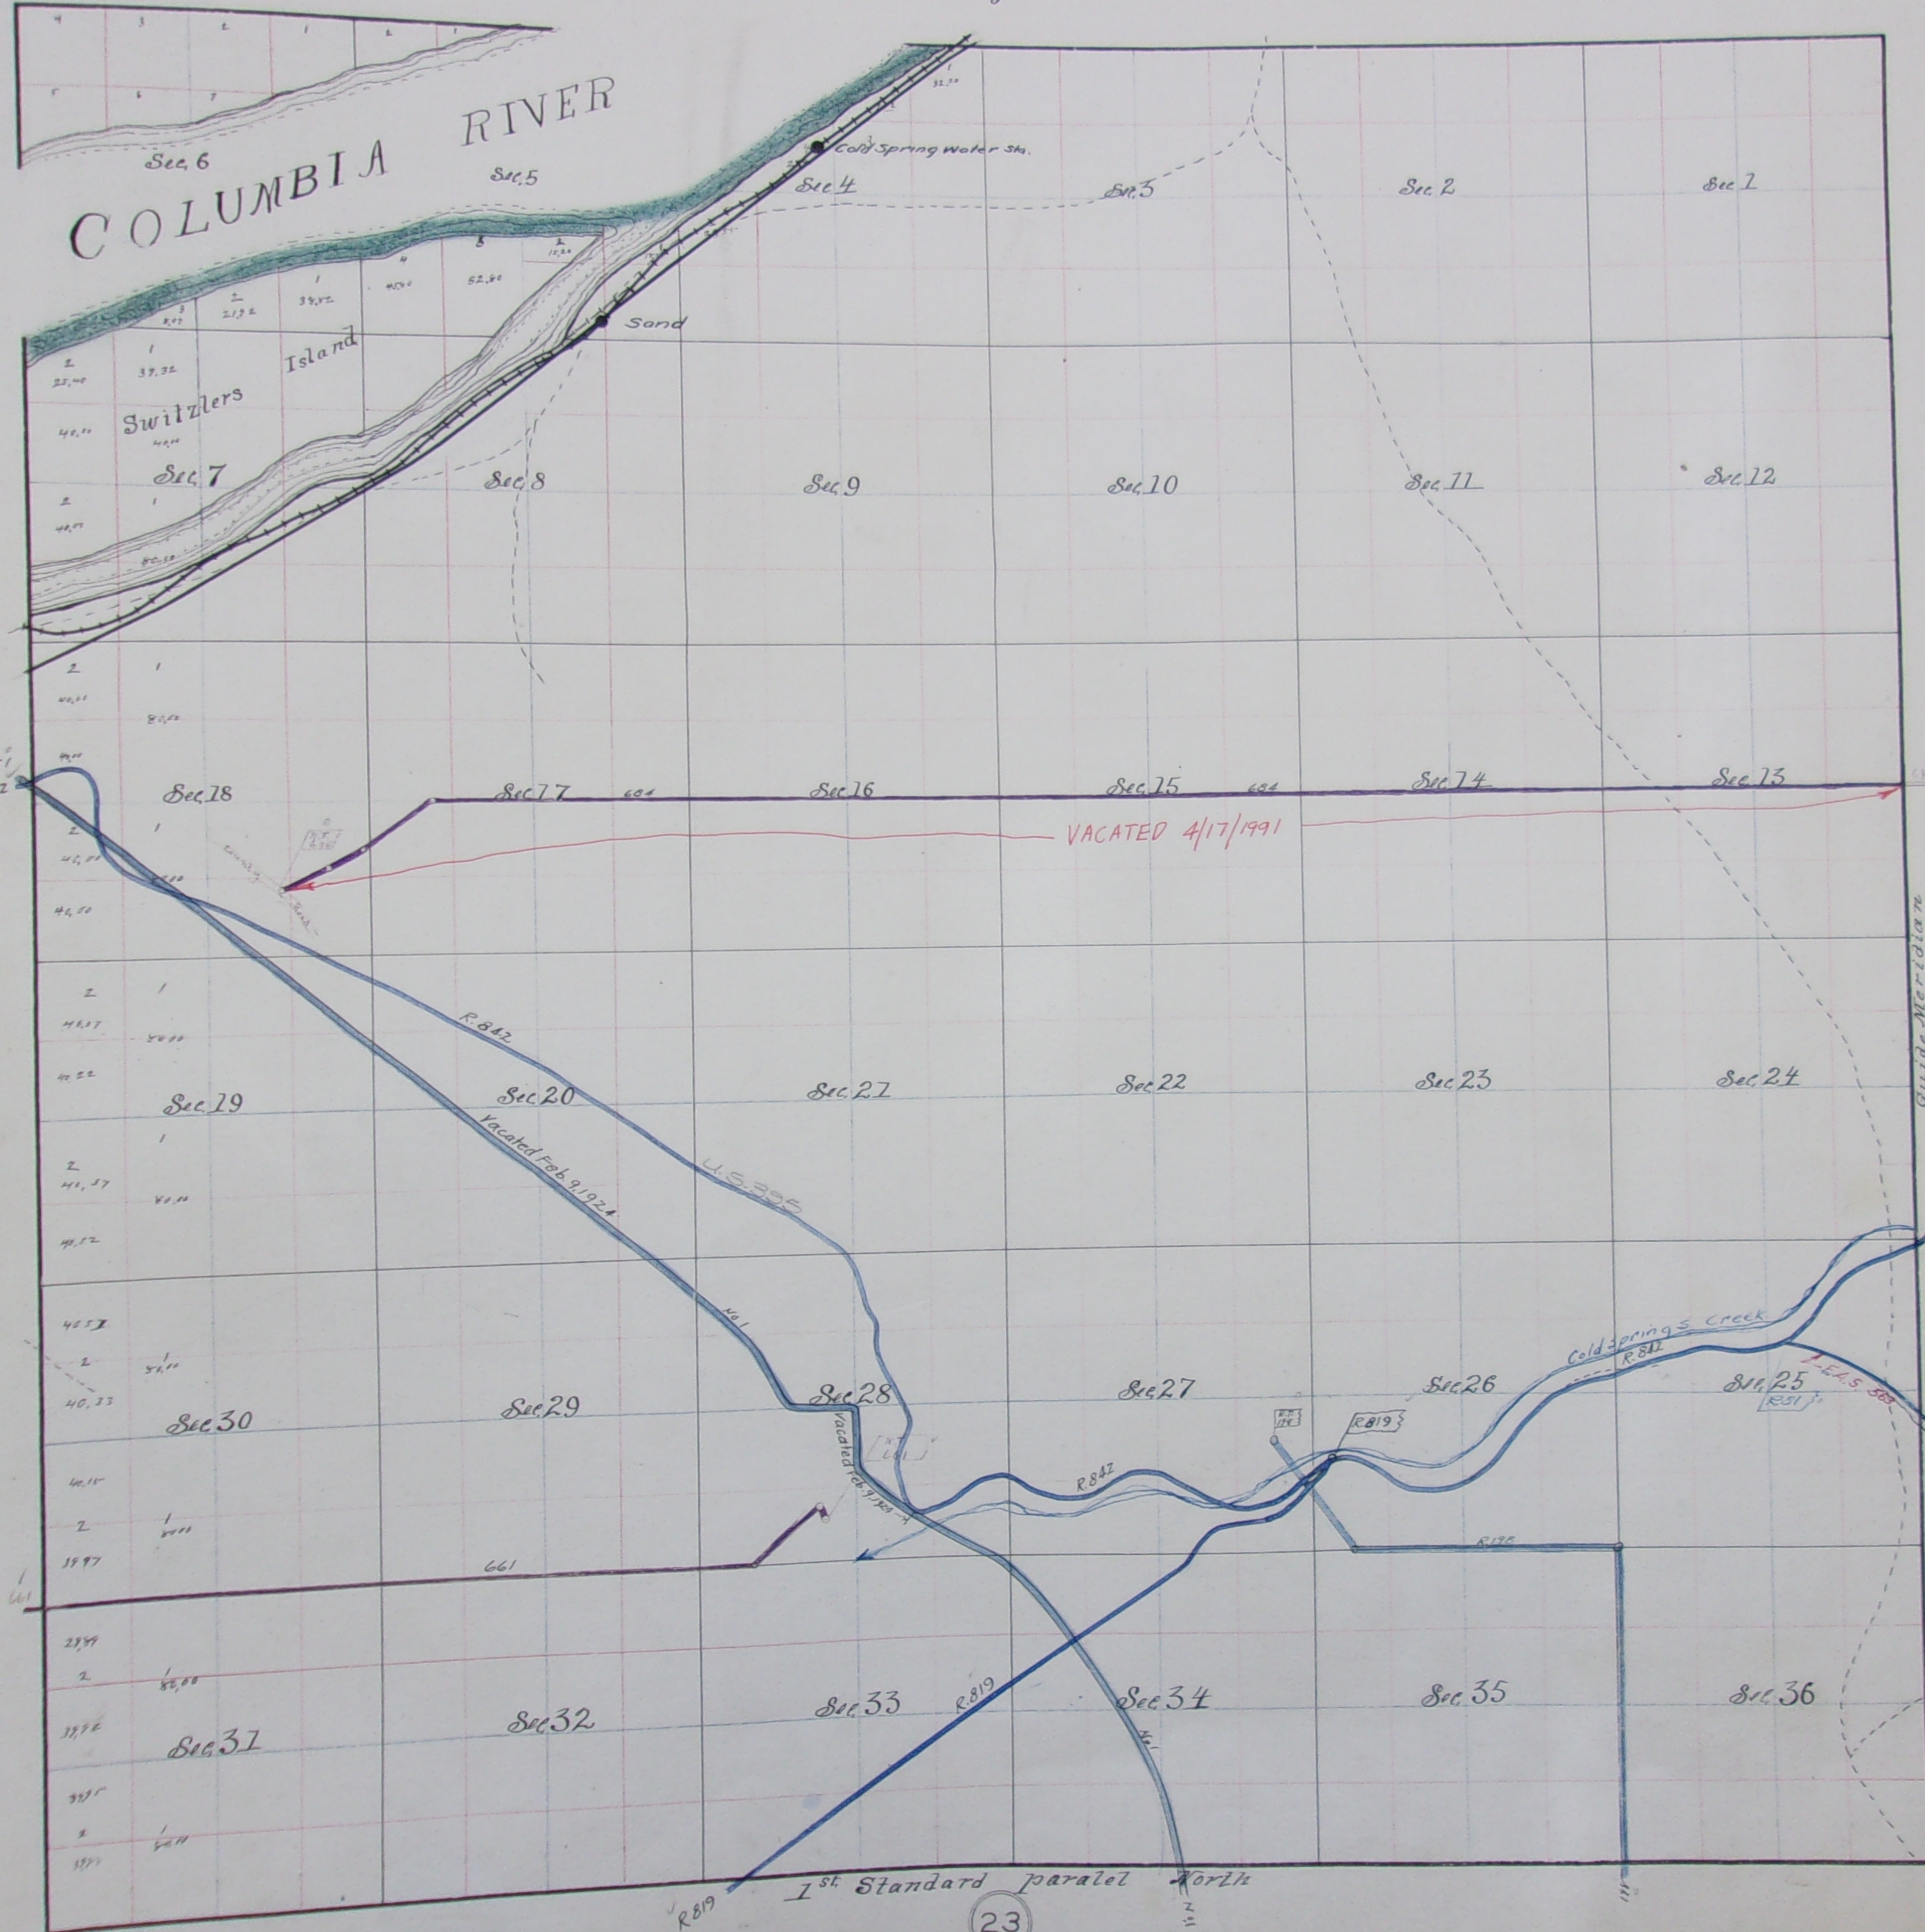

| Date | No. | Box | Book | Page | Date | No. | Box | Book | Page |
|---------------|-----|-----|------|------|------|-----|-----|------|------|
| July 31, 1884 | 178 | 16 | F | 458 | | | | | |
| Jan. 1880 | | | d | 588 | | | | | |
| Nov. 7, 1905 | 661 | | M | 326 | | | | | |
| Apr. 8, 1910 | 684 | | M | | | | | | |
| Feb. 3, 1922 | 819 | | O | 61 | | | | | |
| Feb. 9, 1924 | 842 | | O | | | | | | |
| Sept. 1880 | 81 | | | | | | | | |
| Sept. 1880 | 79 | | | | | | | | |
| VACATE | | | | | | | | | |
| 4/17/1991 | | | | | | | | | |
| | | | | | | | | | |

Scale 25 Chains to 1 inch