


Township 6 North Range 31 East Will, Mer Oregon.

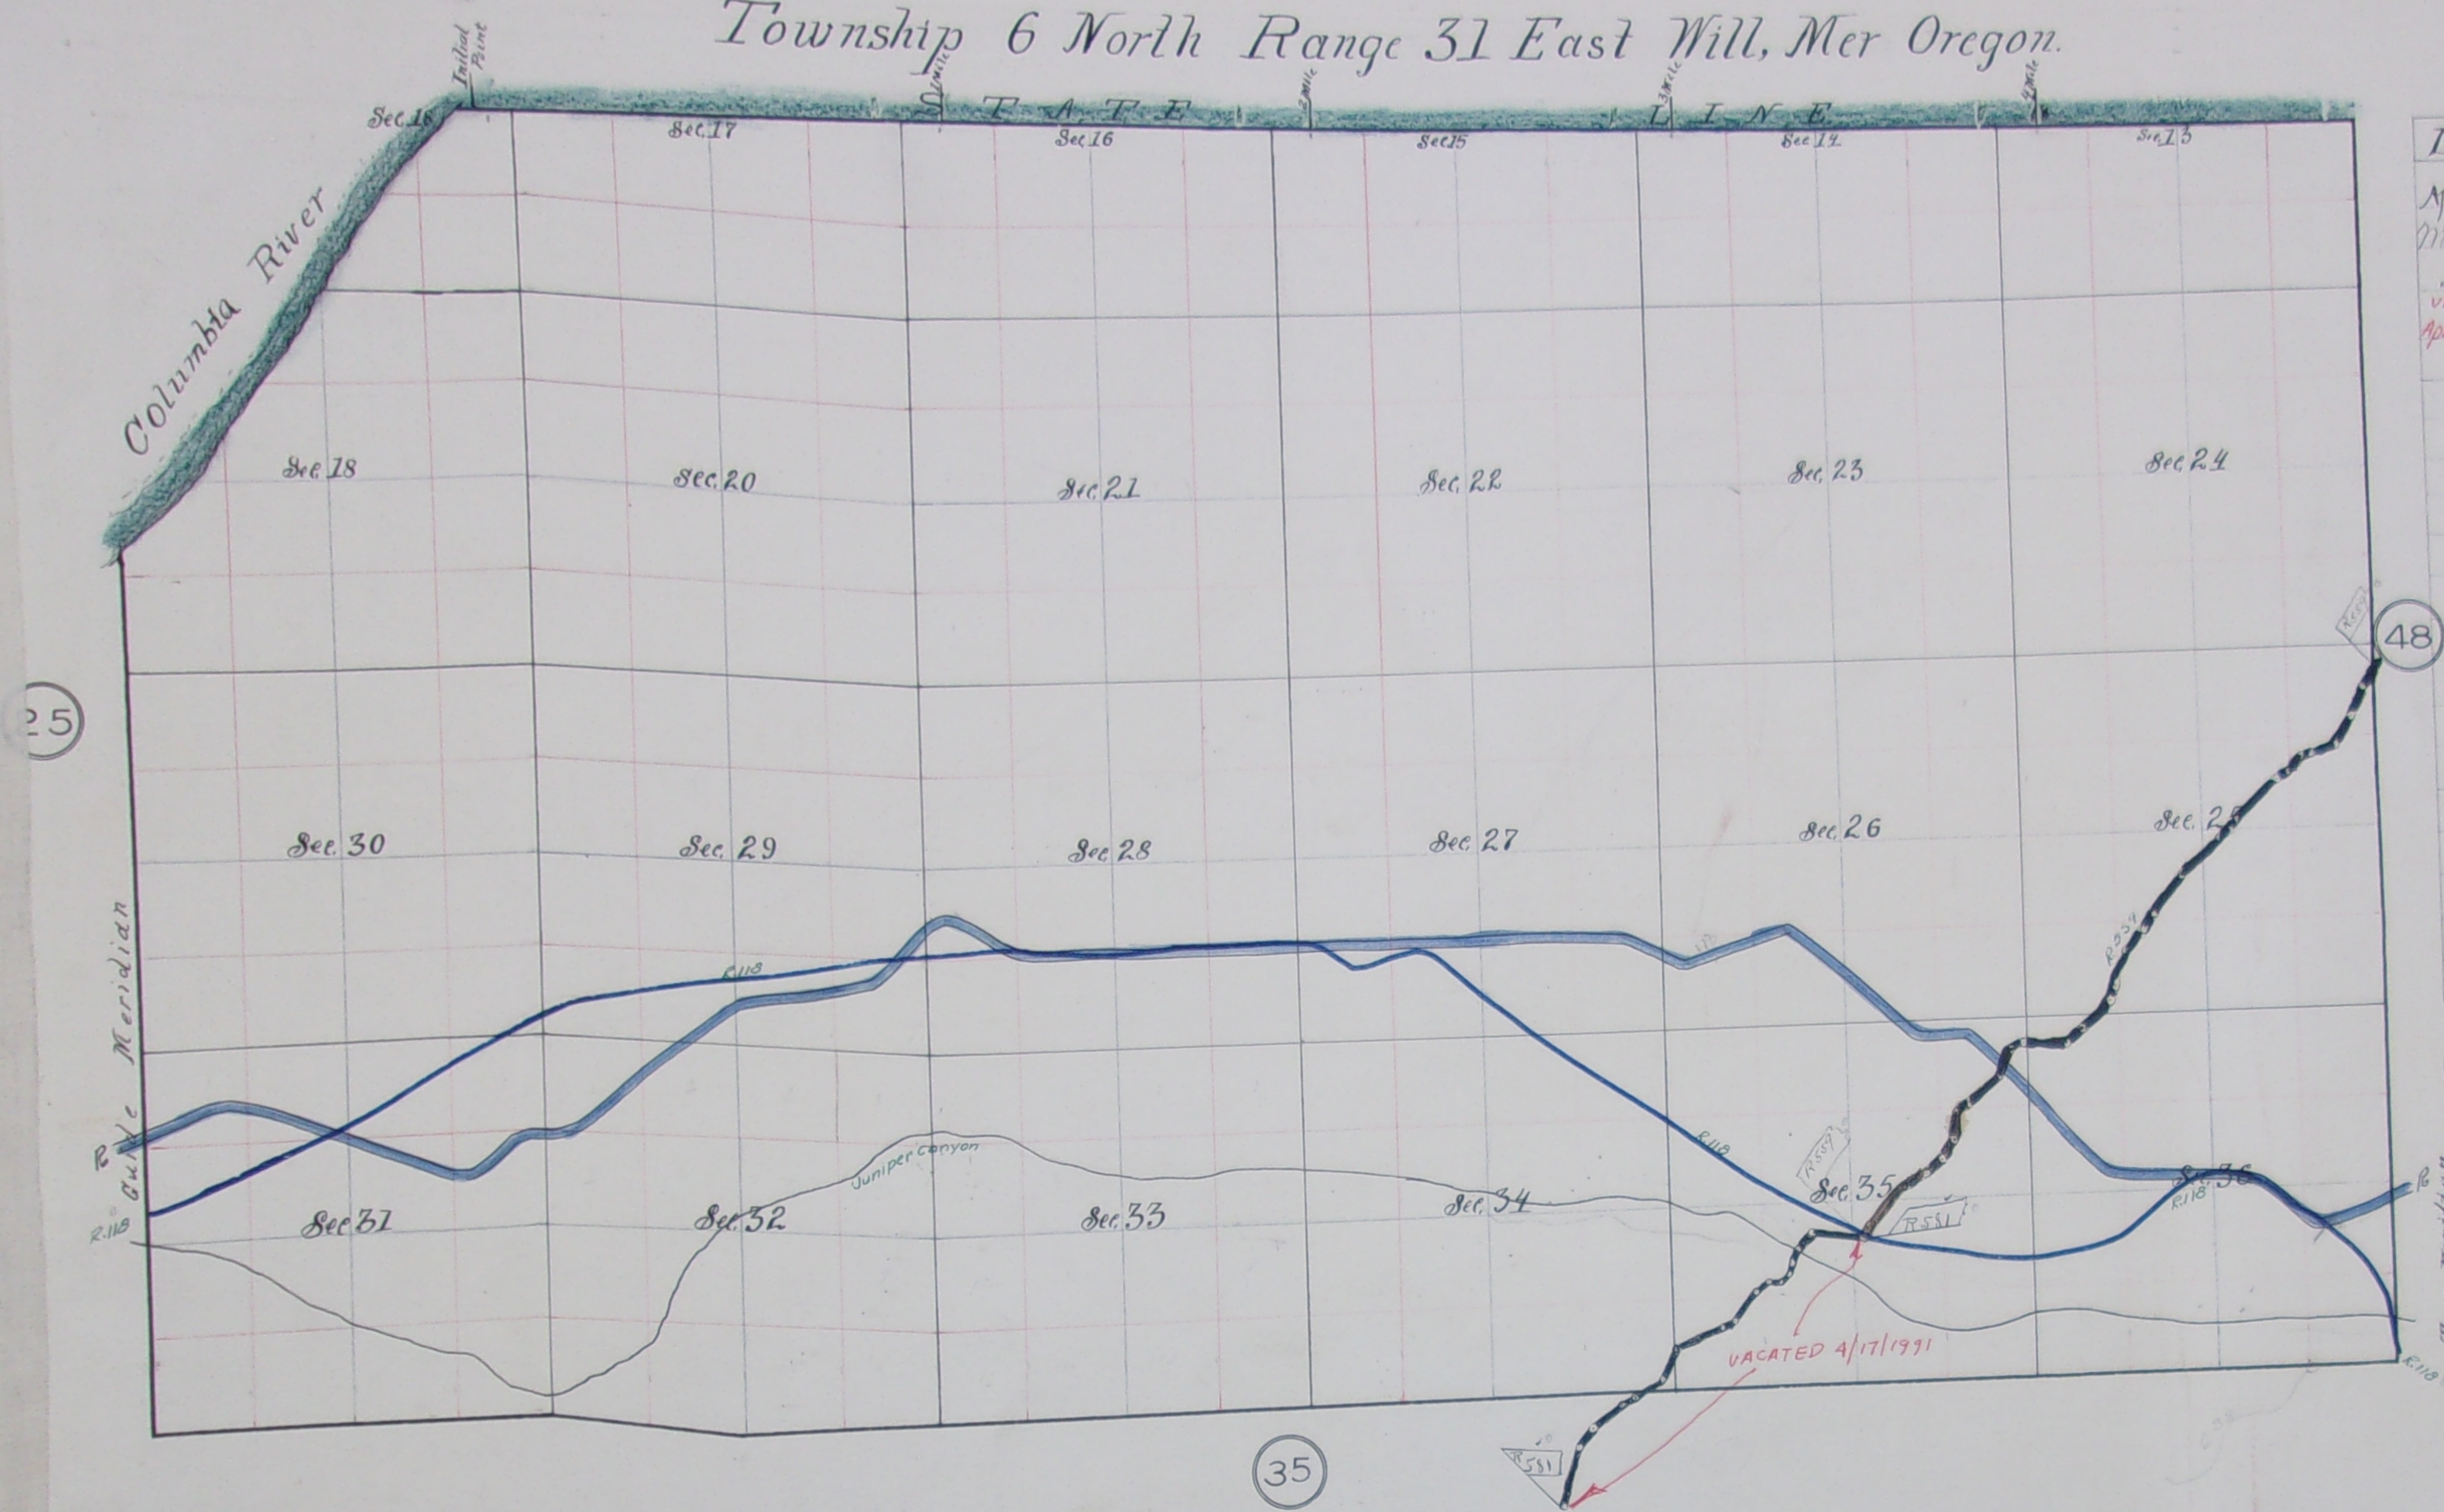

Date	No.	Box	Book	Page	Date	No.	Box	Book	Page
April 12, 1882	110	13	E	432					
May 6, 1884	339		S.	397					
7, 1906	581	925	M	14					
VACATE									
April 17, 1991	581								

scale 25 chains to 1 inch

Township 7 South Range 32 East Will. Mer. Oregon.



Date	No.	Box	Book	Page	Date	No.	Box	Book	Page

scale 25 chains to 1 inch