


Township 5 South, Range 32 East, Will. Mer. Oregon.

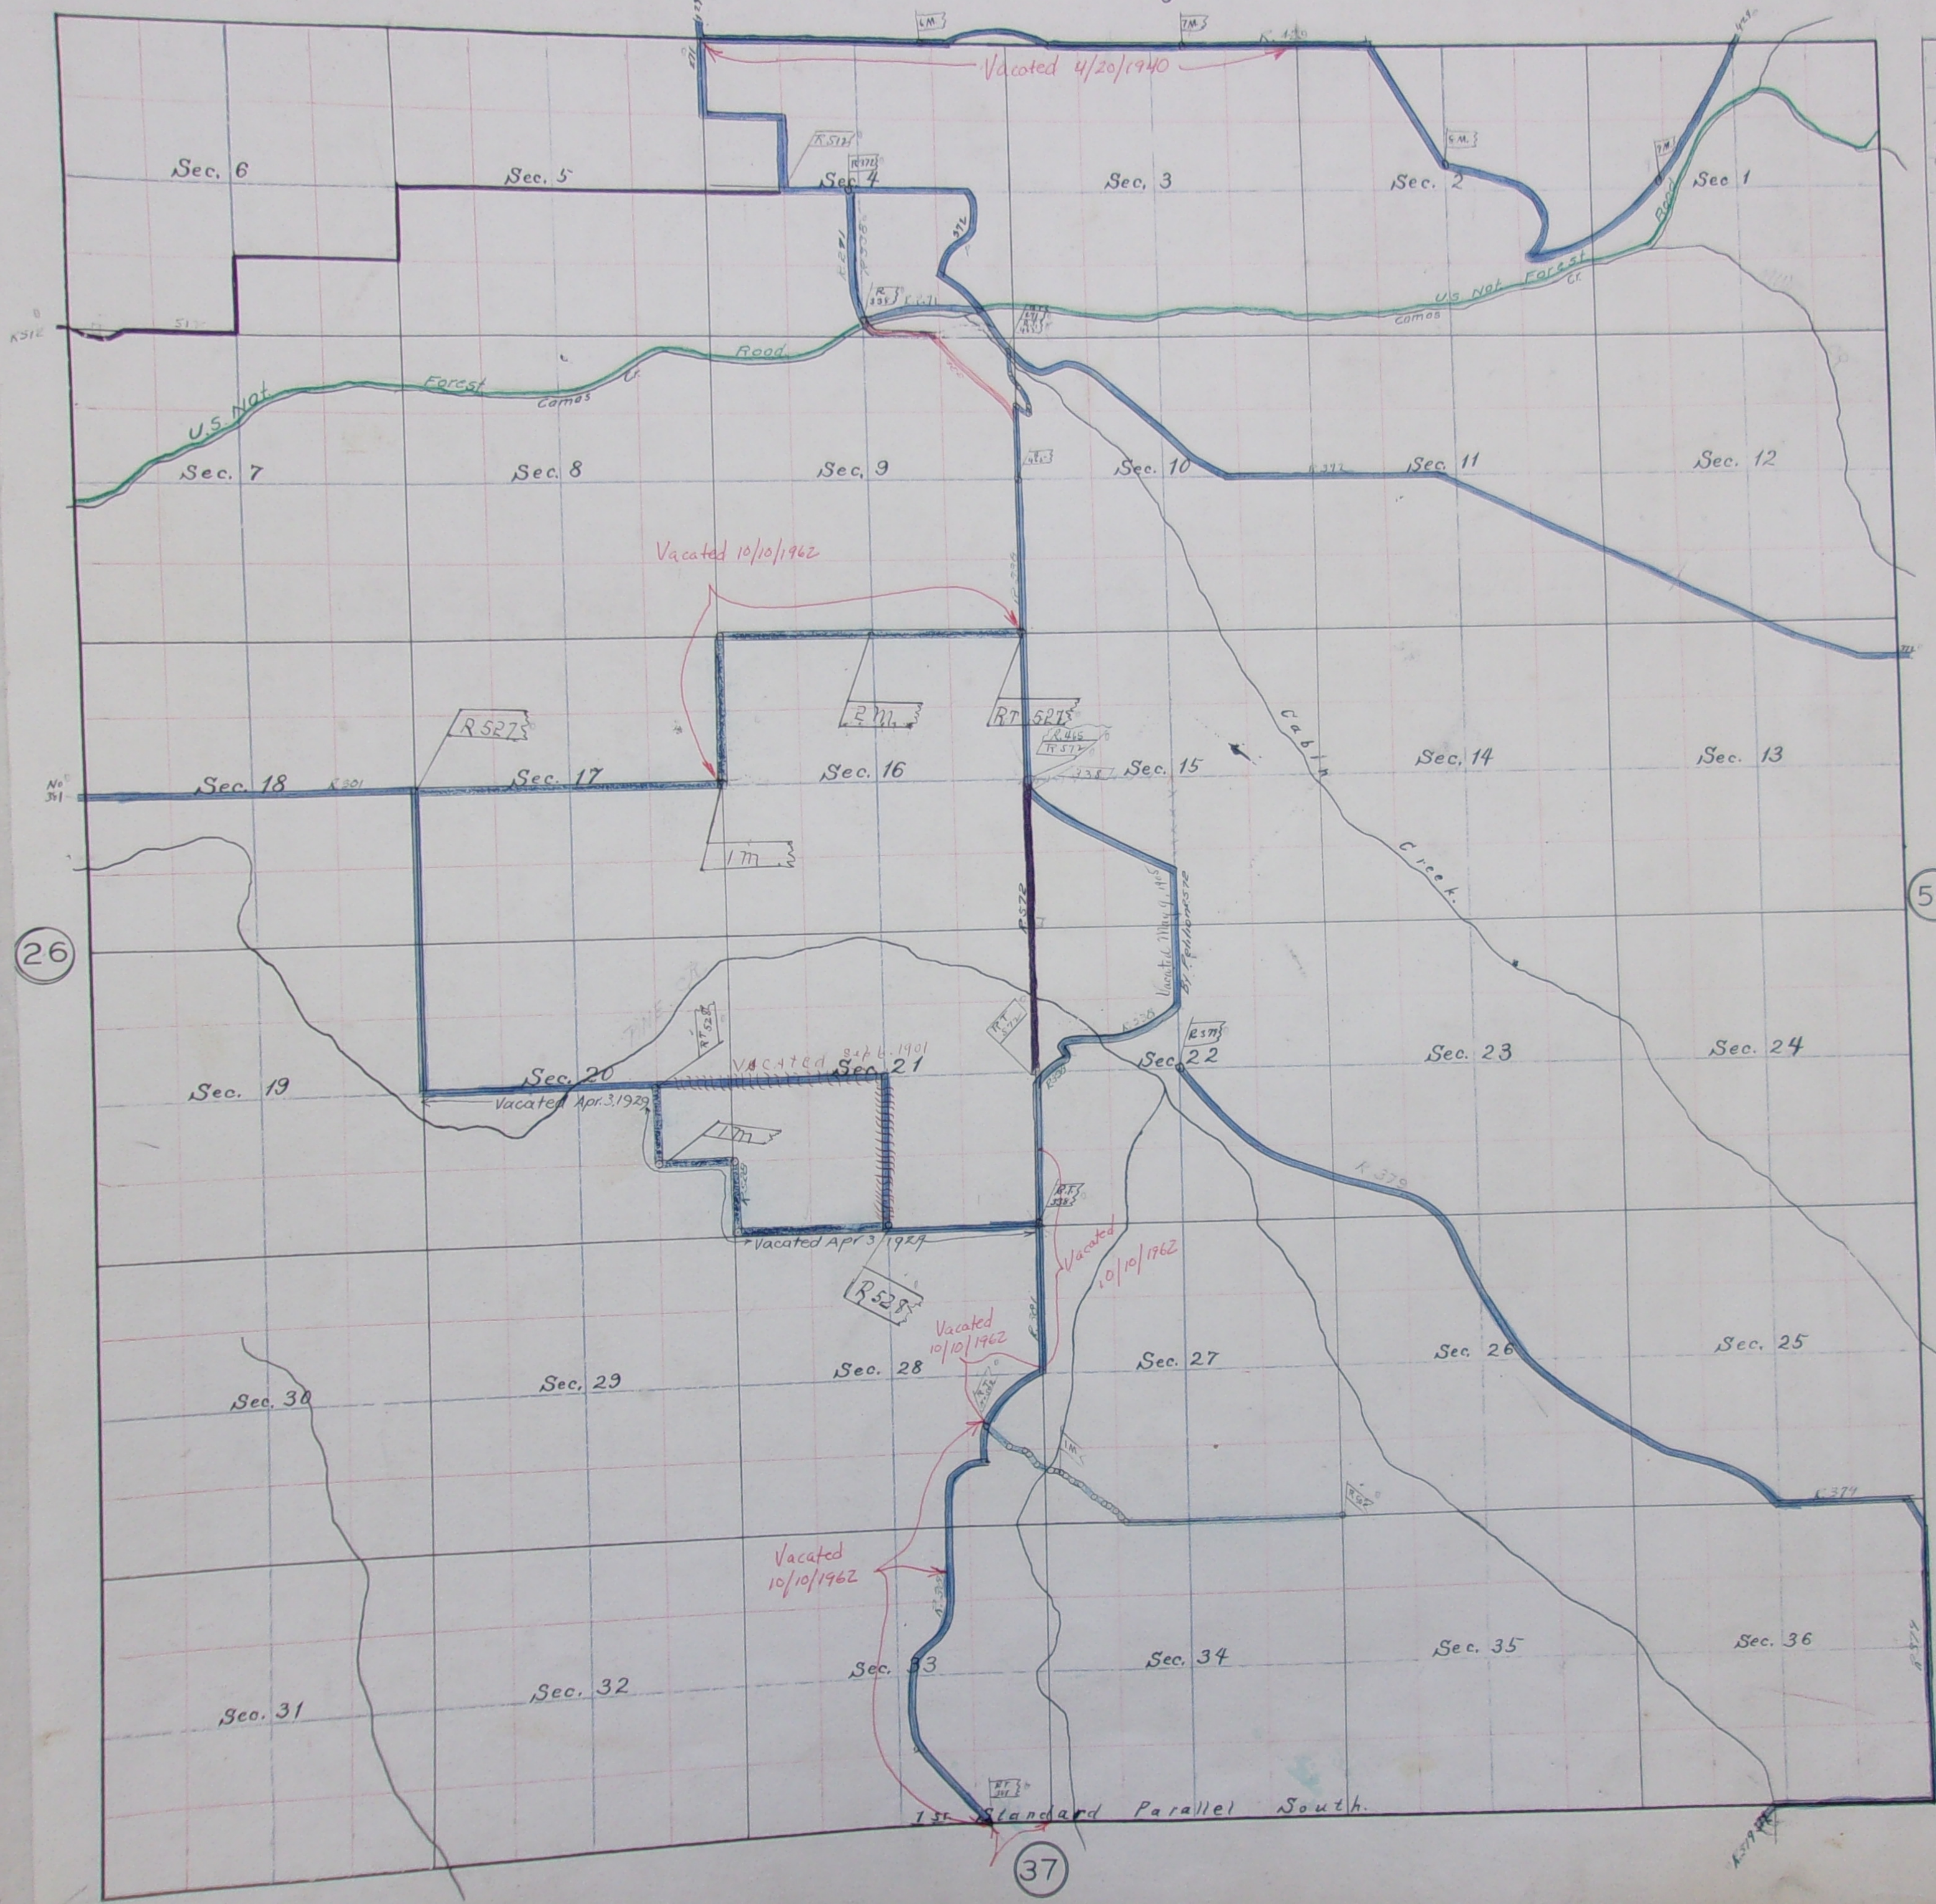

Date	No. Box	Book	Page	Date	No. Box	Book	Page
Apr 1895	465	132	J 415				
July 1893	419	131	J 539				
July 13/1872	372	130	J 196				
Nov. 11 1892	381	130	J 299				
Nov. 6 1891	579	121	J 77				
Apr 1885	120	112	J 415				
Oct 6 1886	271	118	G 402				
Jan 8 1899	502		B 487				
Feb 6 1901	528	512	I 150				
Nov 8 1901	527		" 167				
Jan 1900	512		K 557				
May 9 1906	572		"				
Vacated							
4/20/1940	429						
Vacated							
10/10/1962	381						
Vacated							
10/10/1962	527						
Vacated							
10/10/1962	338						

True Meridian
 10° 10' 10" N

Scale 25 chains to 1 inch