


44
Township 1 North, Range 32 East Will. Mer. Oregon.

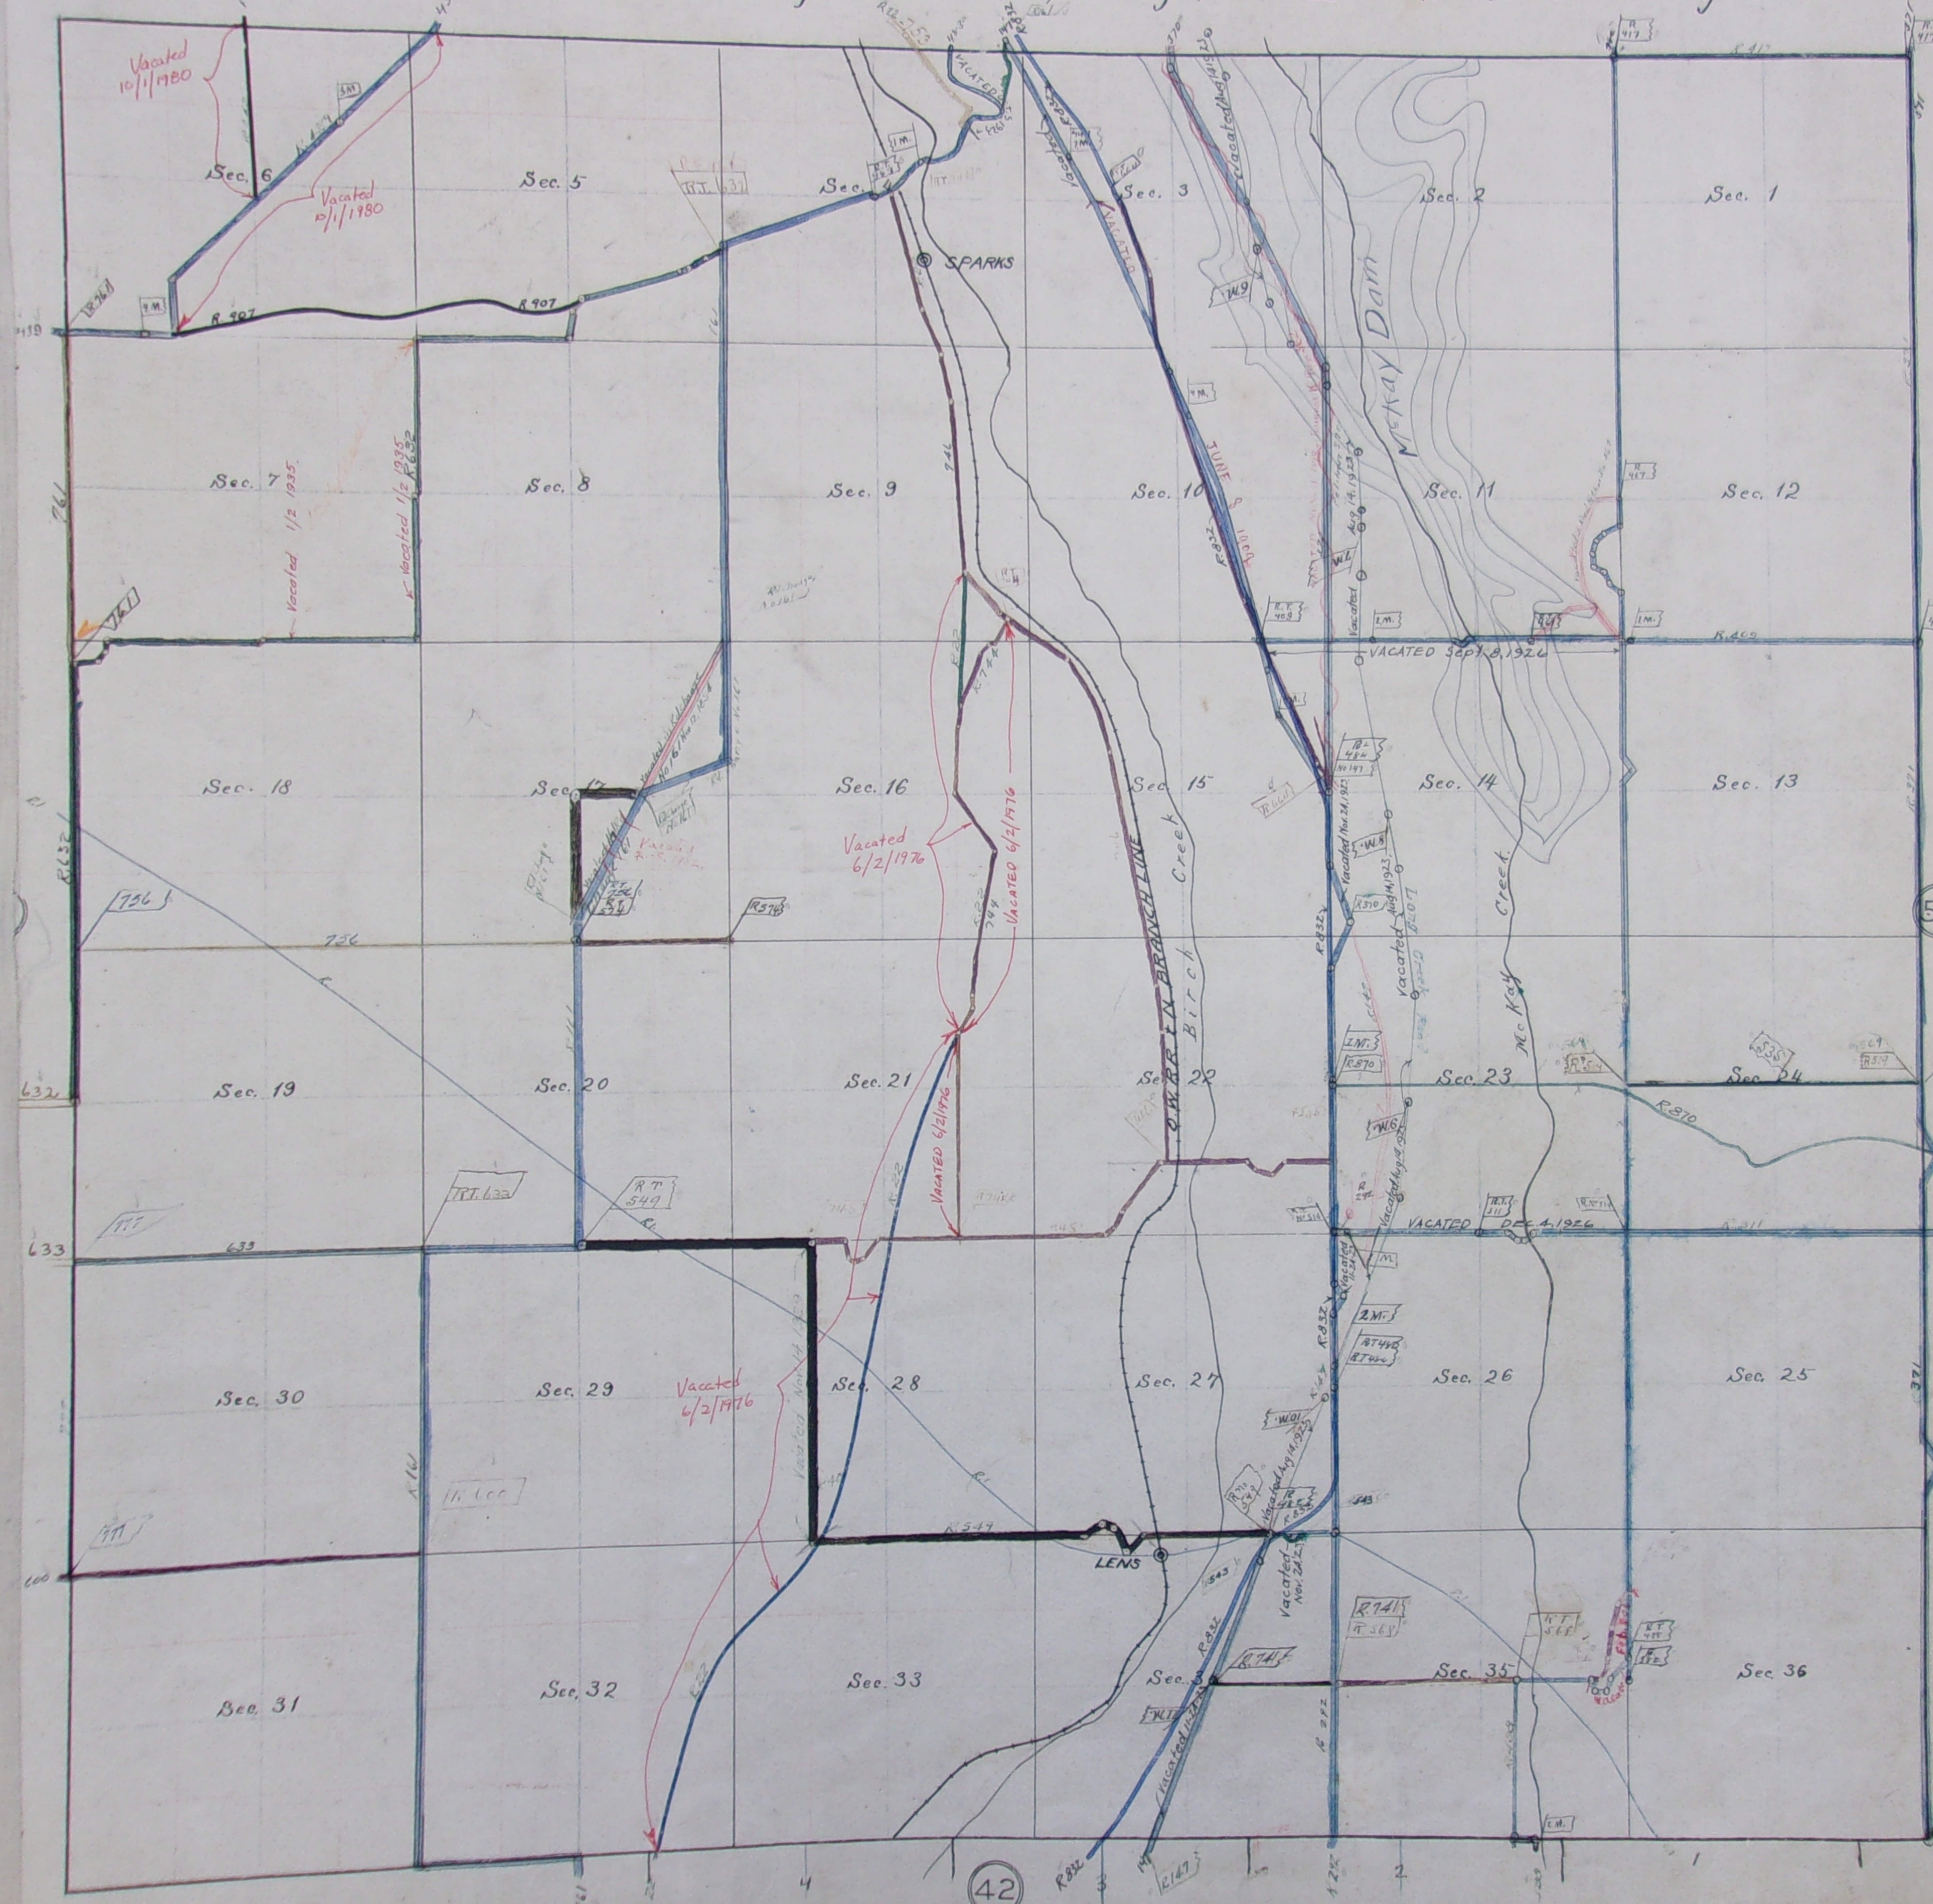

Date	No. Box	Book	Page	Date	No. Box	Book	Page
Sept 6 1875	467	132	J 415	Jan 25 1874	907		
Nov 12 1872	352	130	J 227		VACATE		342
Nov 6 1896	442	134	J 626	June 2 1976	744		
May 5 1877	444	134	J 106		Vacated		
July 1874	438	132	J 181	10/1/1980	439		
Nov 6 1876	453	134	J 629		Vacated		
				10/1/1980	342		
					Vacated		
				6/2/1976	22		
Jan 7 1893	409	181	J 399				
Mar 18 1873	417	131	J 447				
May 16 1883	147	131	E 717				
July 10 1887	129		G 223				
July 11 1888	311		H 95				
July 1 1883	161	15	F 129				
Nov 2 1874							
Apr 2 1878	439	138	B 475				
May 9 1904	569						
July 4 1900	574		B 495				
May 3 1905	568						
Dec 2 1905	519	133	L 59				
July 10 1905	545						
July 10 1905	545						
Jan 11 1907	632	50	M 178				
	632	50	M 178				
Feb 5 1908	641	233	M 244				
	641	233	M 244				
	233	M	243				
Mar 5 1909	664		M 347				
June 8 1909			M 373				
May 5 1913	744		N 72				
" " " "	745		N 72				
" " " "	746		N 72				
Oct 2 1913	756		N 108				
Sept 4 1913	753		N 107				
" " " "	741		N 31				
Mar 5 1914	741		N				
Nov 24 1923	832		O 221				
July 8 1927	870		O 554				
Mar 5 1916	777						
Sept 1916							
July 1916	22						
June 9 1903	549						

55

Scale 25 chains to 1 inch.