


Township 2 South, Range 33 East, Will. Mer. Oregon.

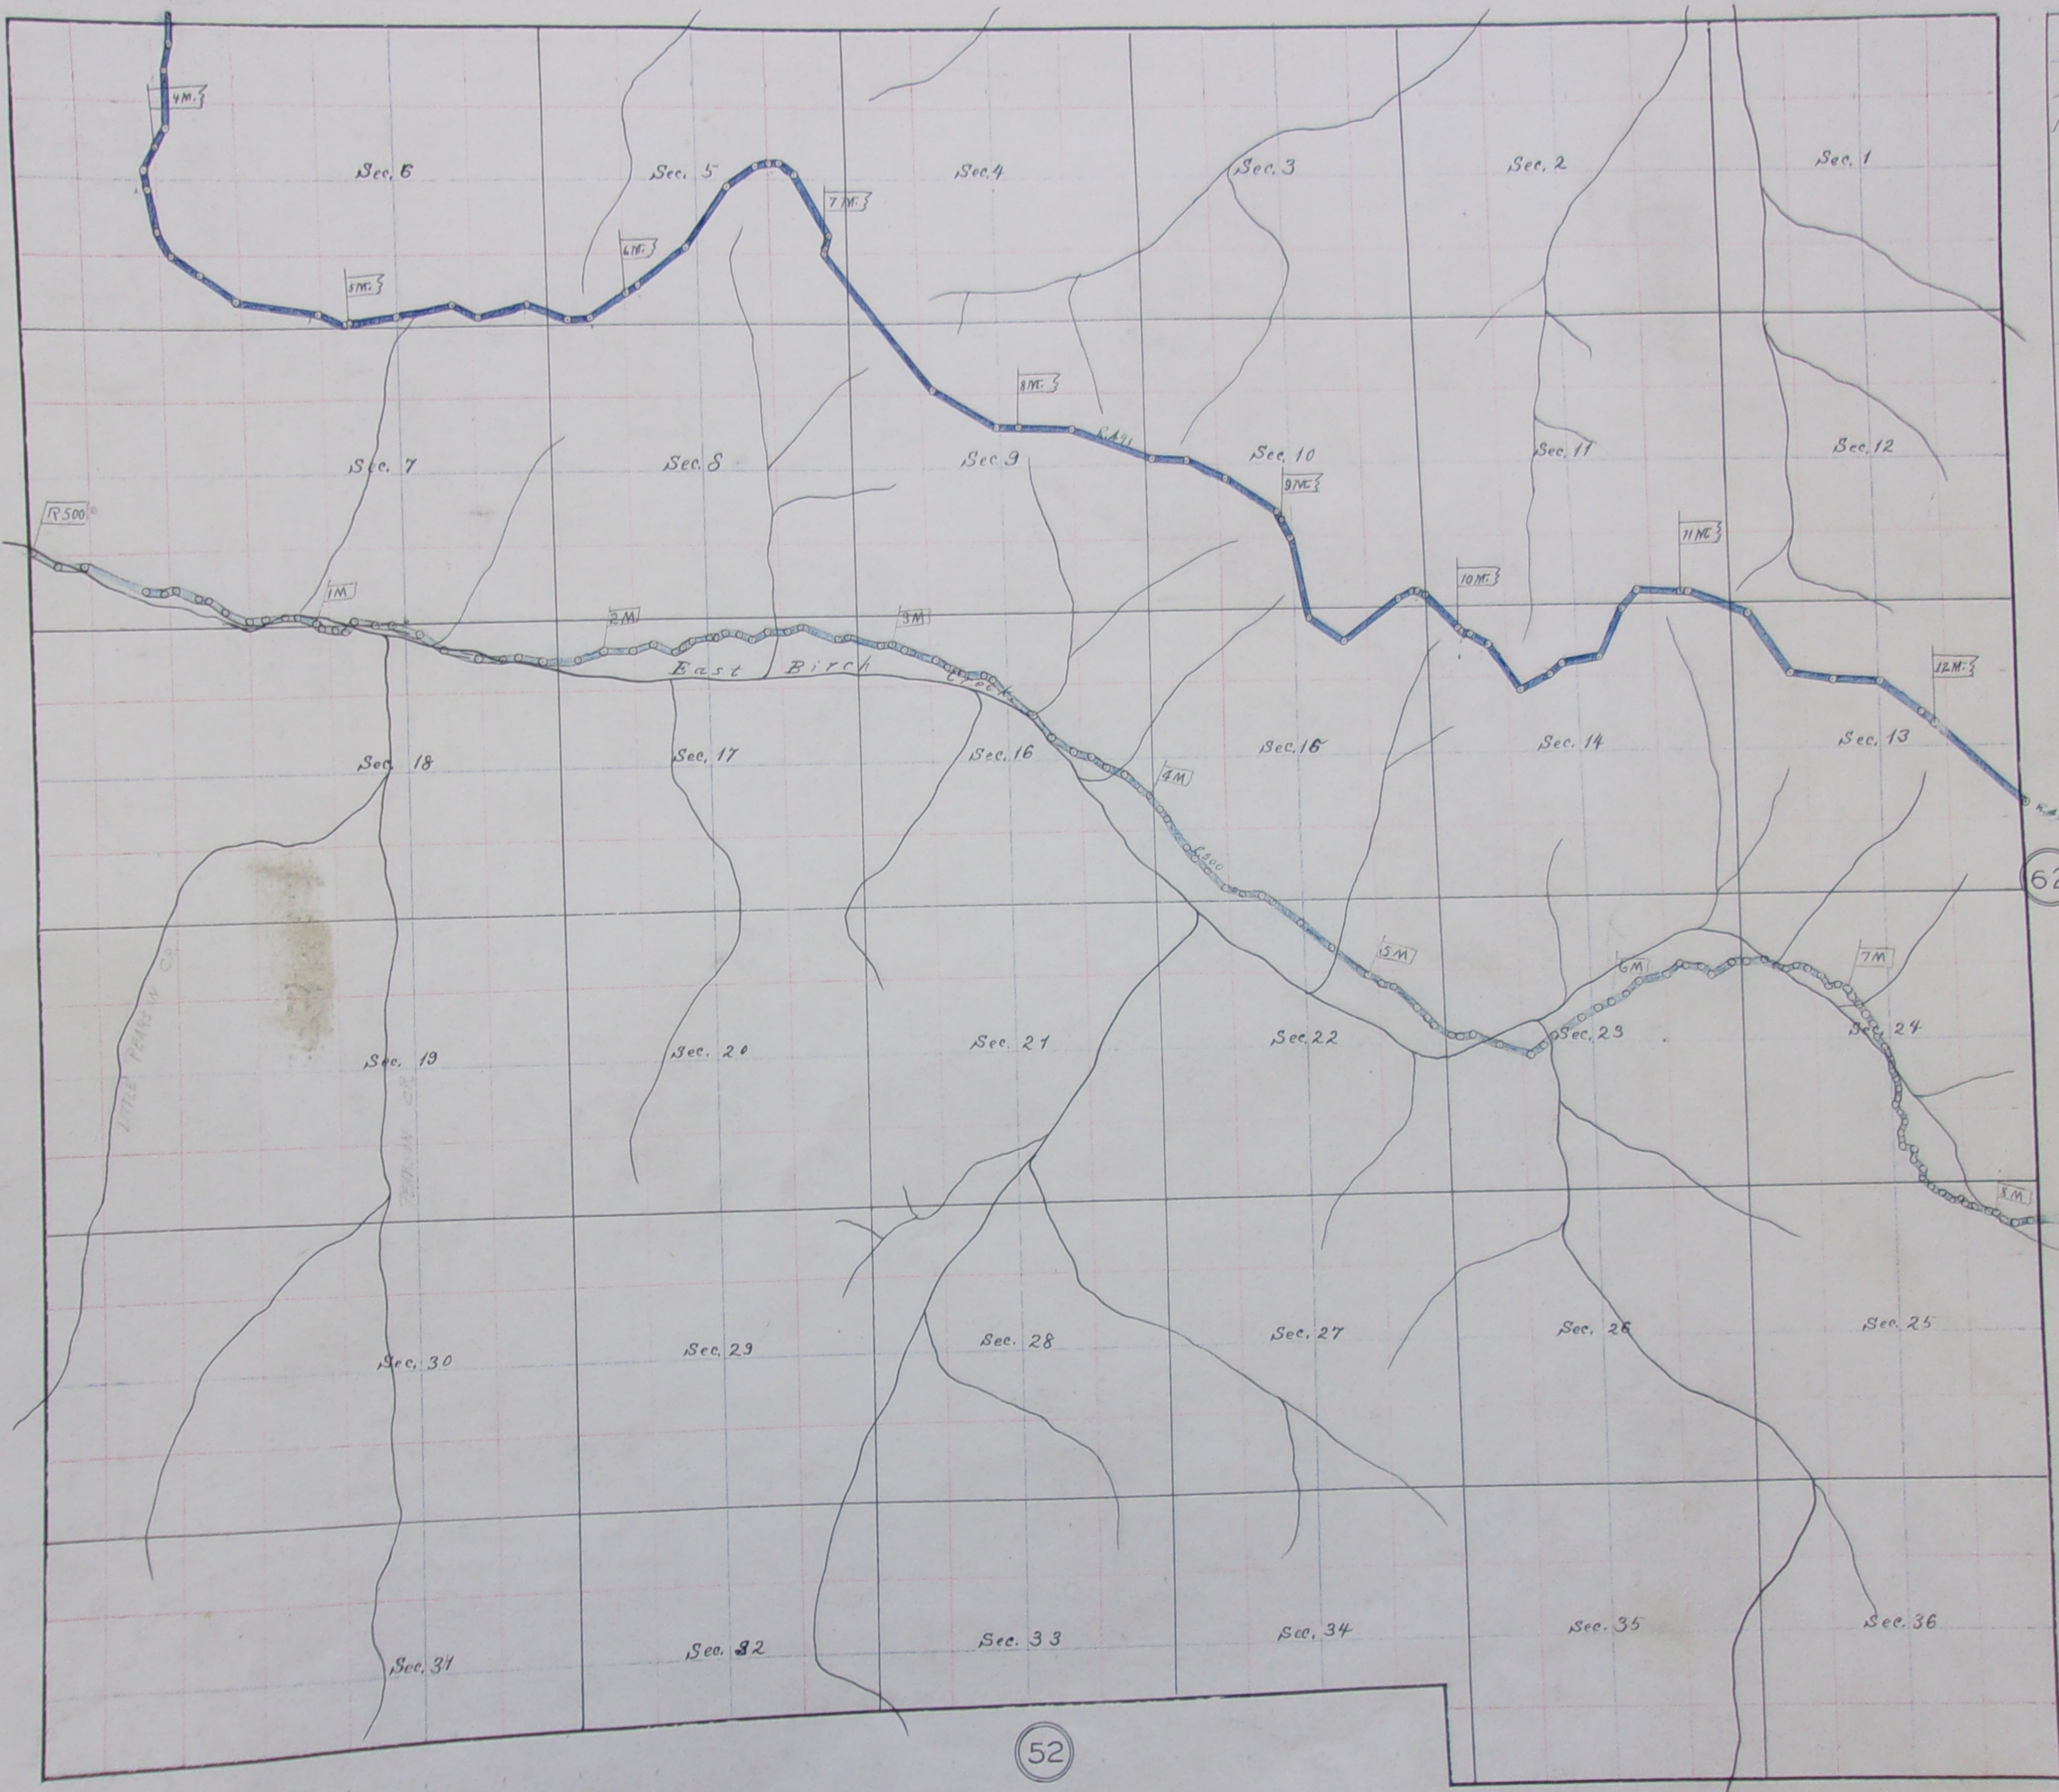

Date	No.	Book	Page
Sept. 7 <sup>th</sup> 1877	411	134	K 166
Nov. 11 <sup>th</sup> 1878	500	K	361

41

62

52

True Meridian  
 True Dip. 41°  
 South 25 chains to E. 1000.