56

Township 1 North, Range 33 East, Will. Mer. Oregon.

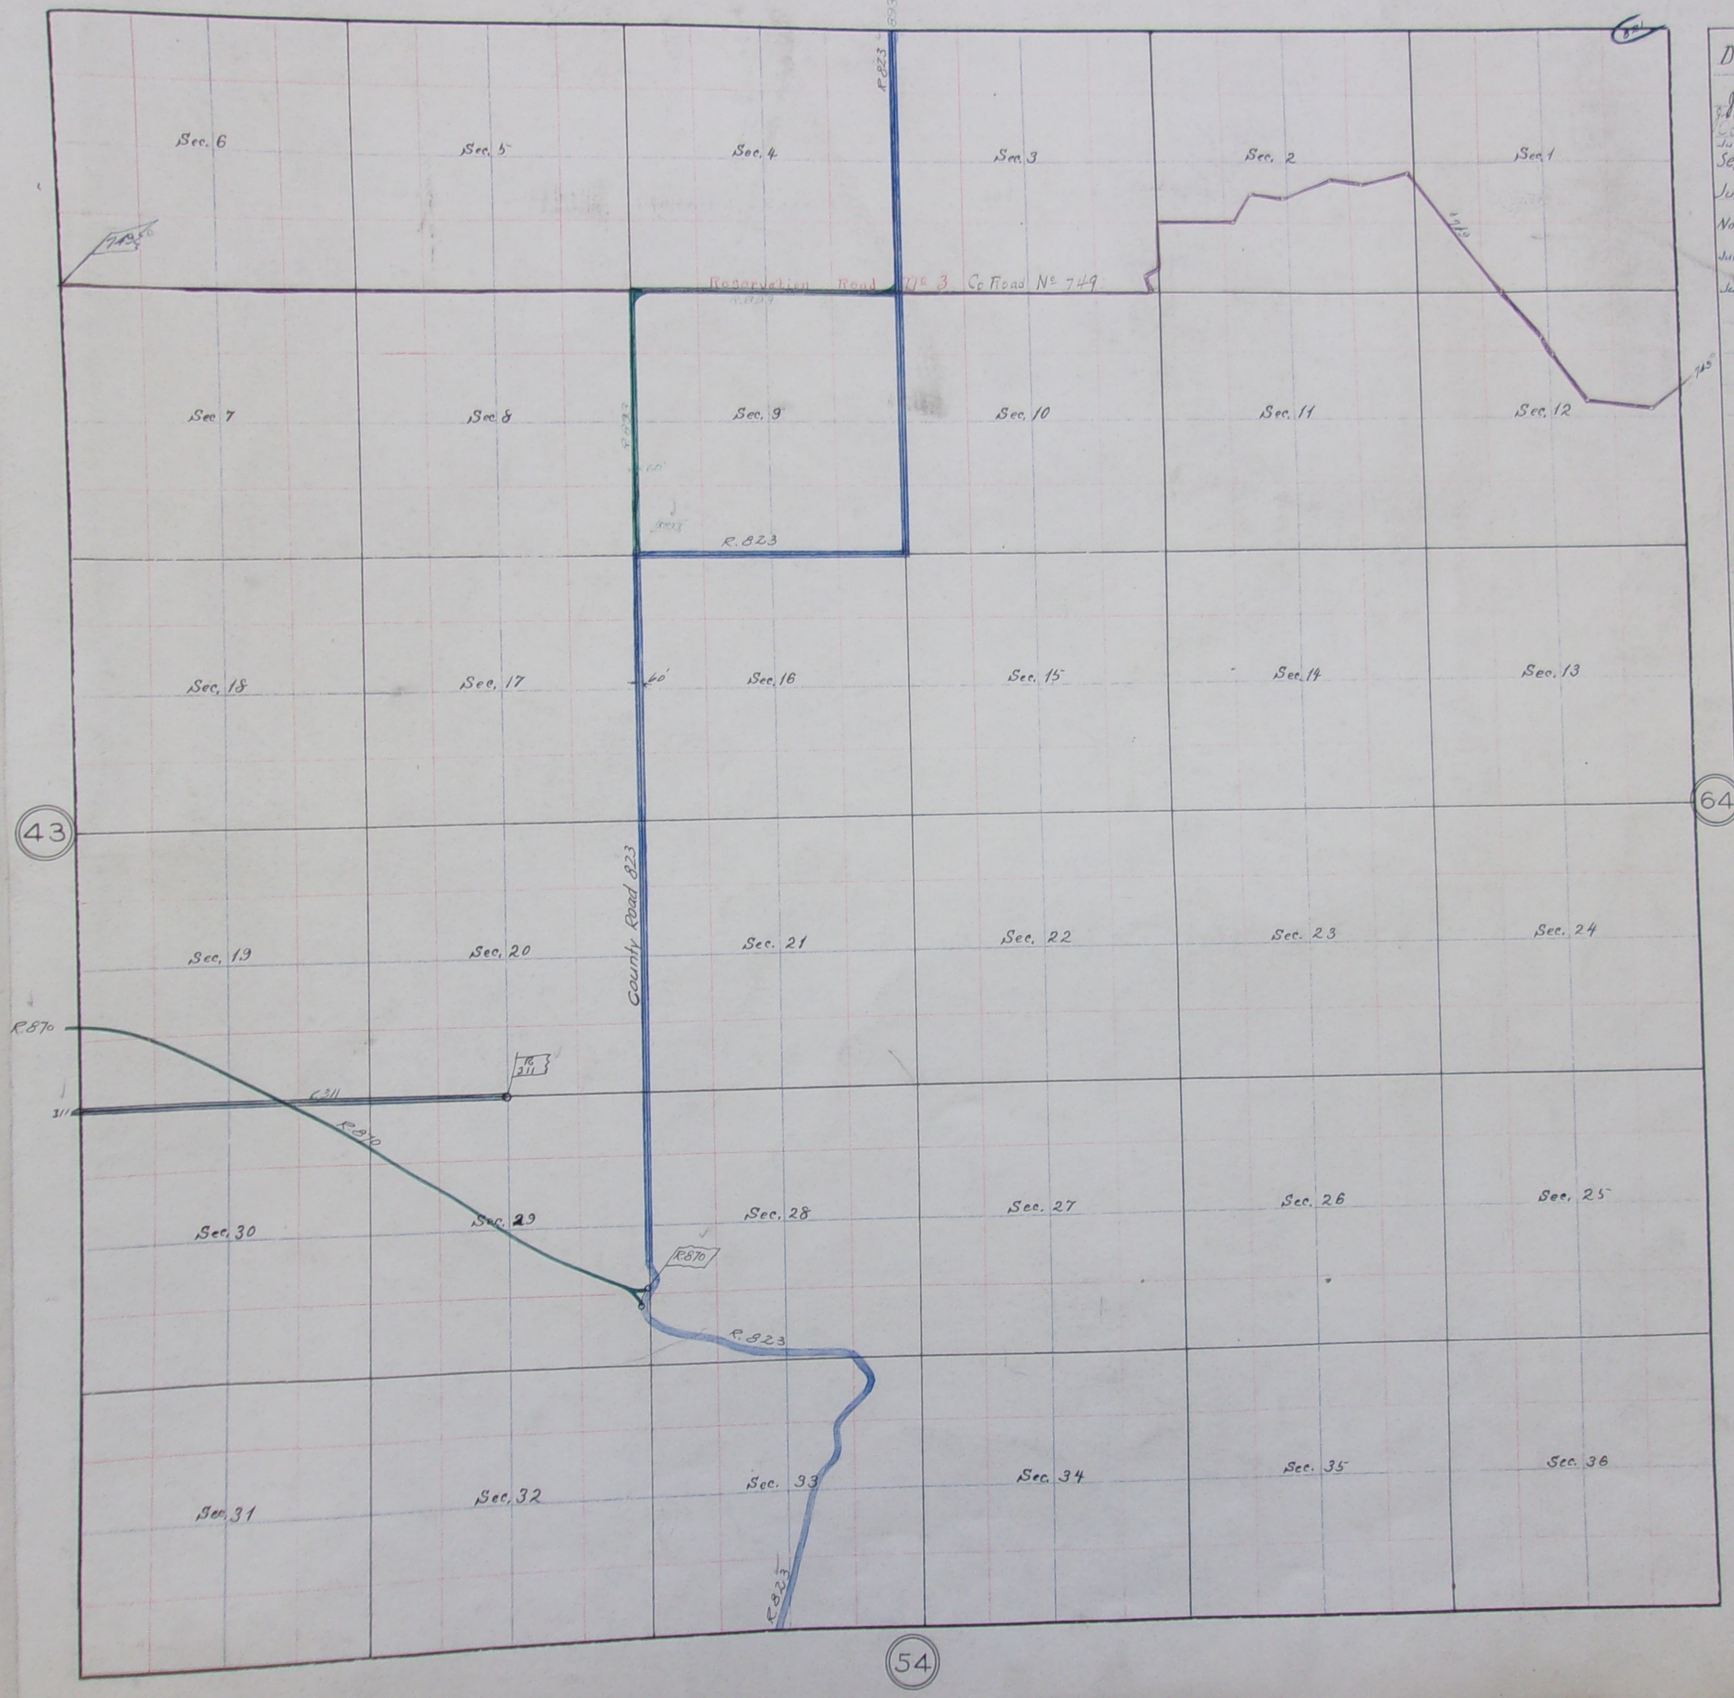

Date	No. Box	Book	Page	Date	No. Box	Book	Page
Jul 11 1888	311	H	95				
June 5, 1913	Reserve	N	79				
Oct 5, 1910 No 3		M	487				
June 9, 1913	749						
Sept 8, 1922	823	0	100				
July 8 1927	870	0	554				
Nov, 8, 1928	883						
June 8, 1922	821						
June 5							

True Meridian
Var. from 18°30' to 22° E.

Scale 25 chains to 1 inch.