


57
Township 2 North, Range 33 East, Will. Mer. Oregon.

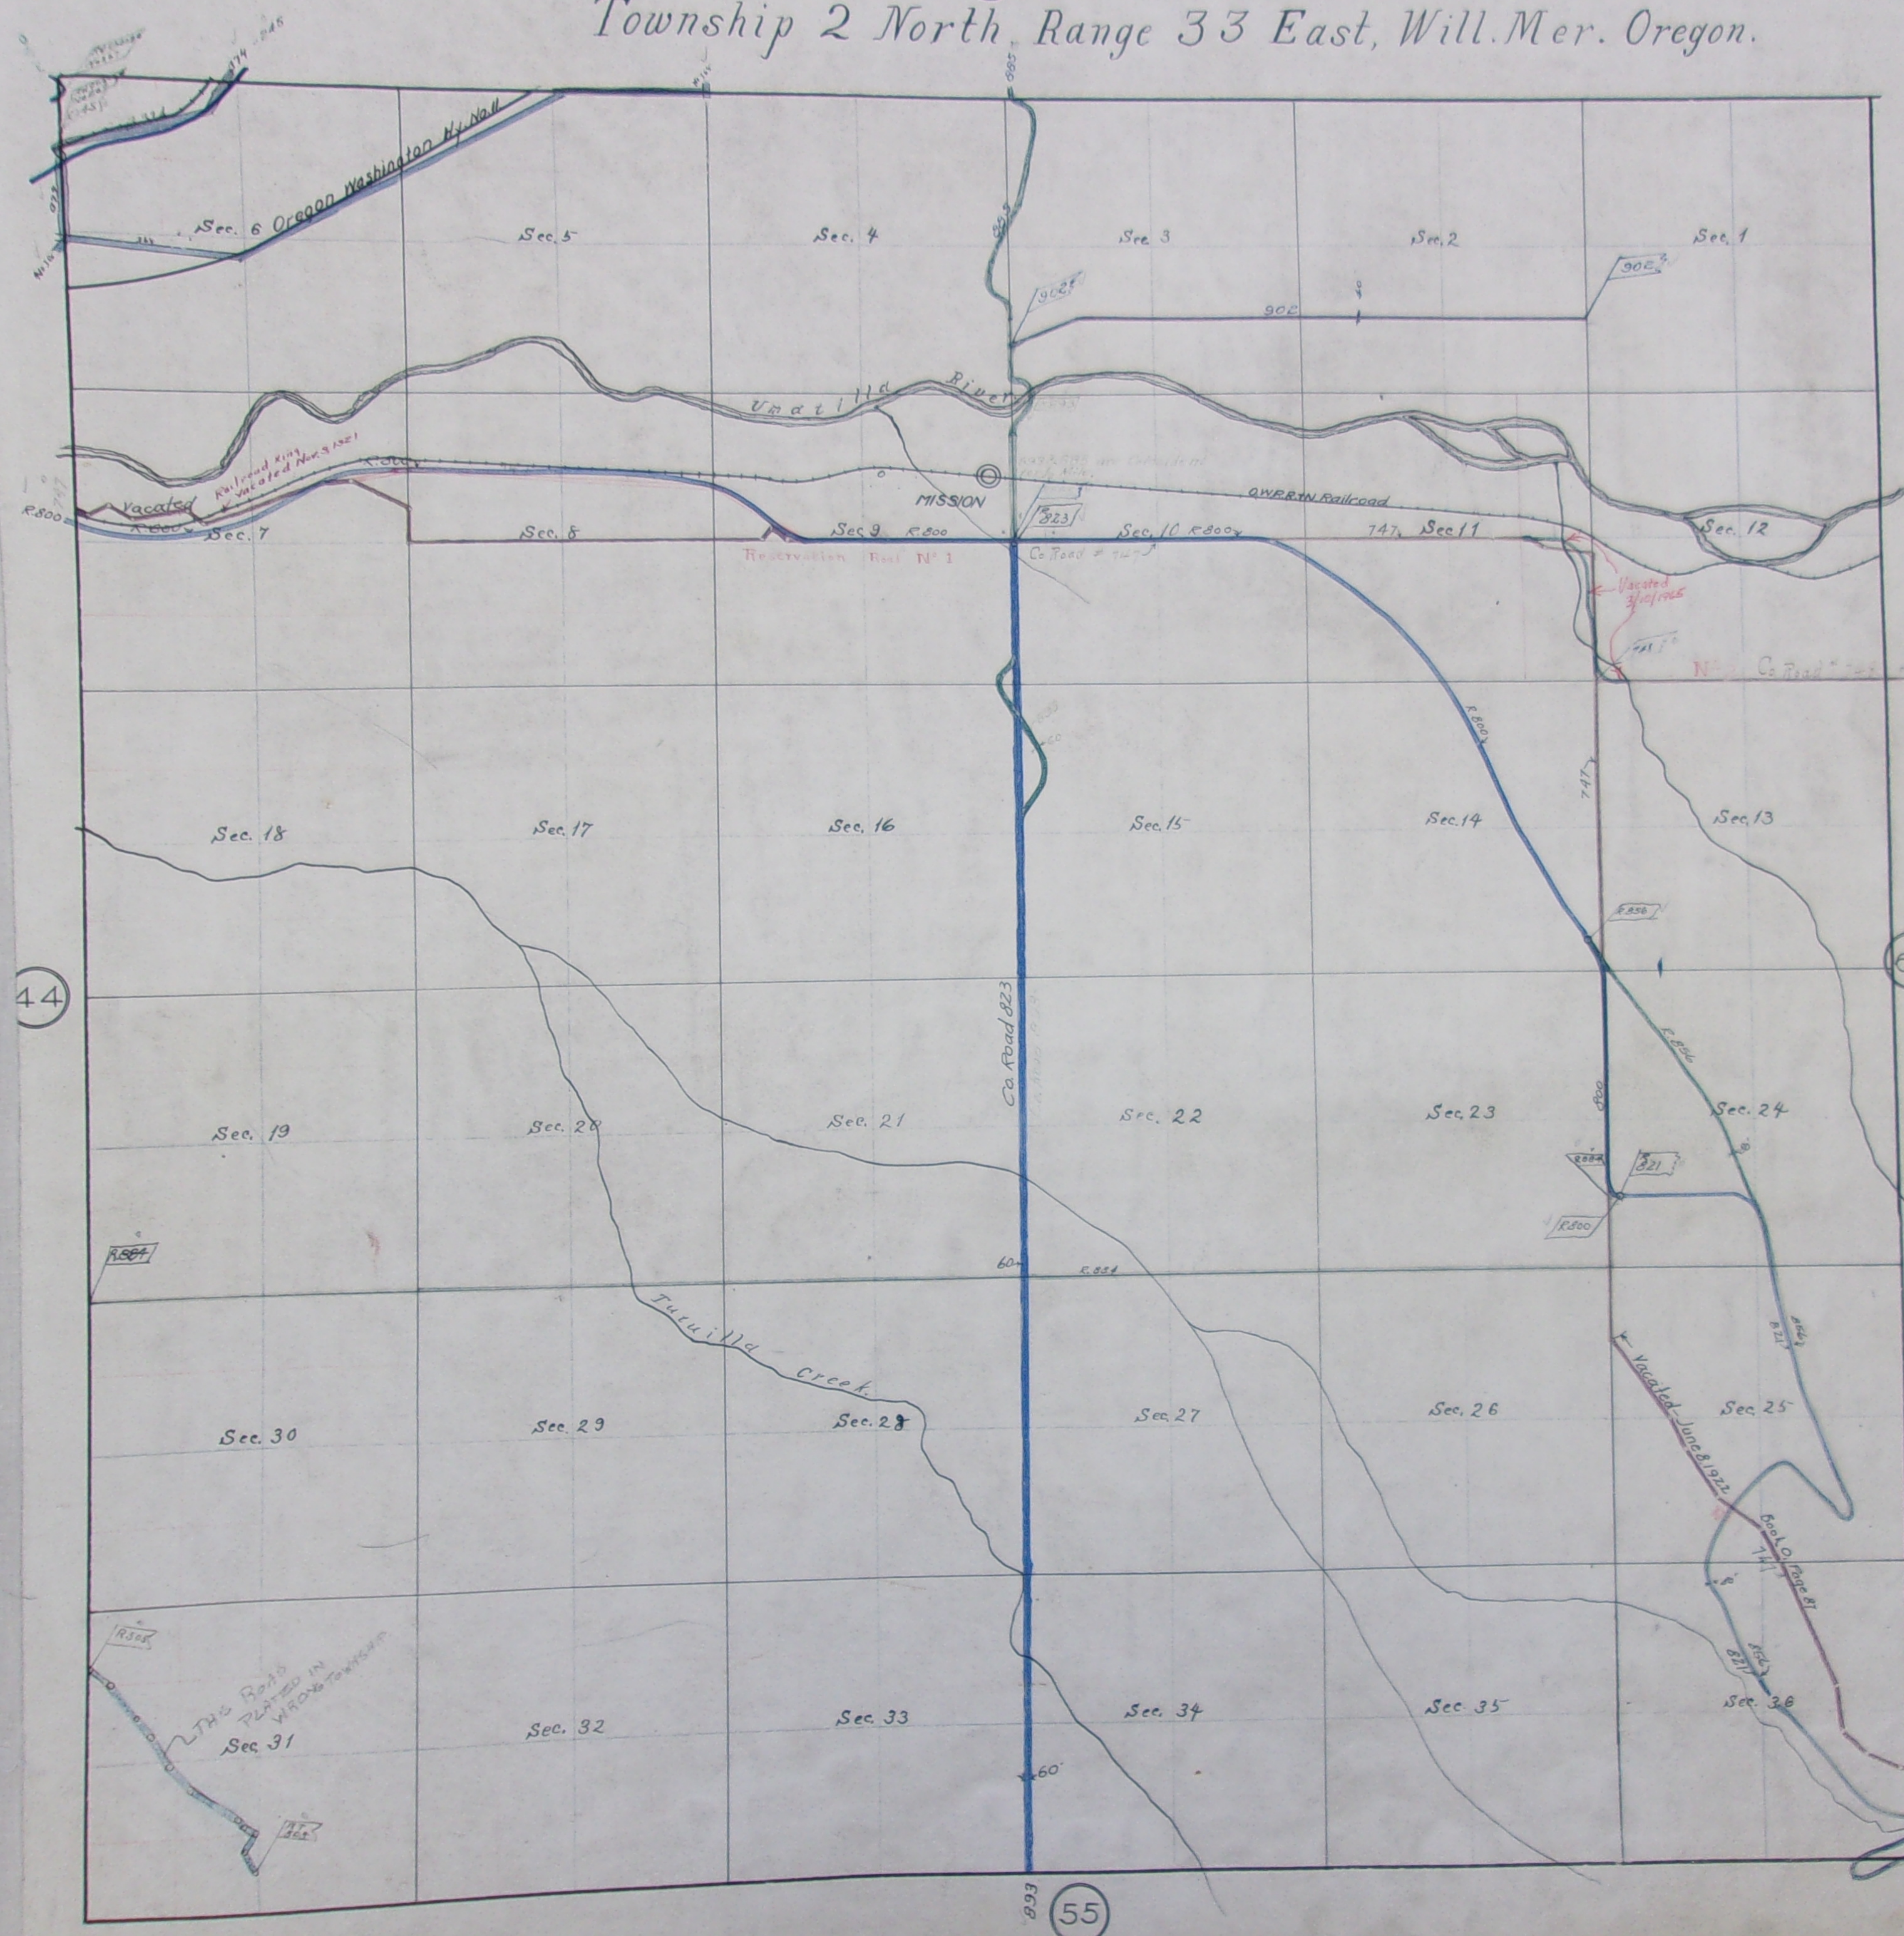

Date	No. Boy	Book	Page	Date	No. Boy	Book	Page
Nov. 7, 1891	368	131	11	765			
May 2, 1891							
Nov. 1, 71	374	129	II	74			
Sept. 8, 1922	823	0	100				
June 8, 1922	821	0	87				
Oct. 9, 1925	856	0					
Aug. 6, 1926	867	0					
MAR. 6, 1920	800						
July 6, 1929	884						
July 6, 1928	885						
Nov. 8, 1928	893						
June 5, 1931	902						
June 5, 1913	749						
Jan. 1, 1915	245						
Sept. 1, 1930	90						
July 31, 1884	207						
3/2/1925	747						

44

65

55

Scale 25 chains to 1 inch.