


Township 3 North Range 33 East Will. Mer. Oregon.

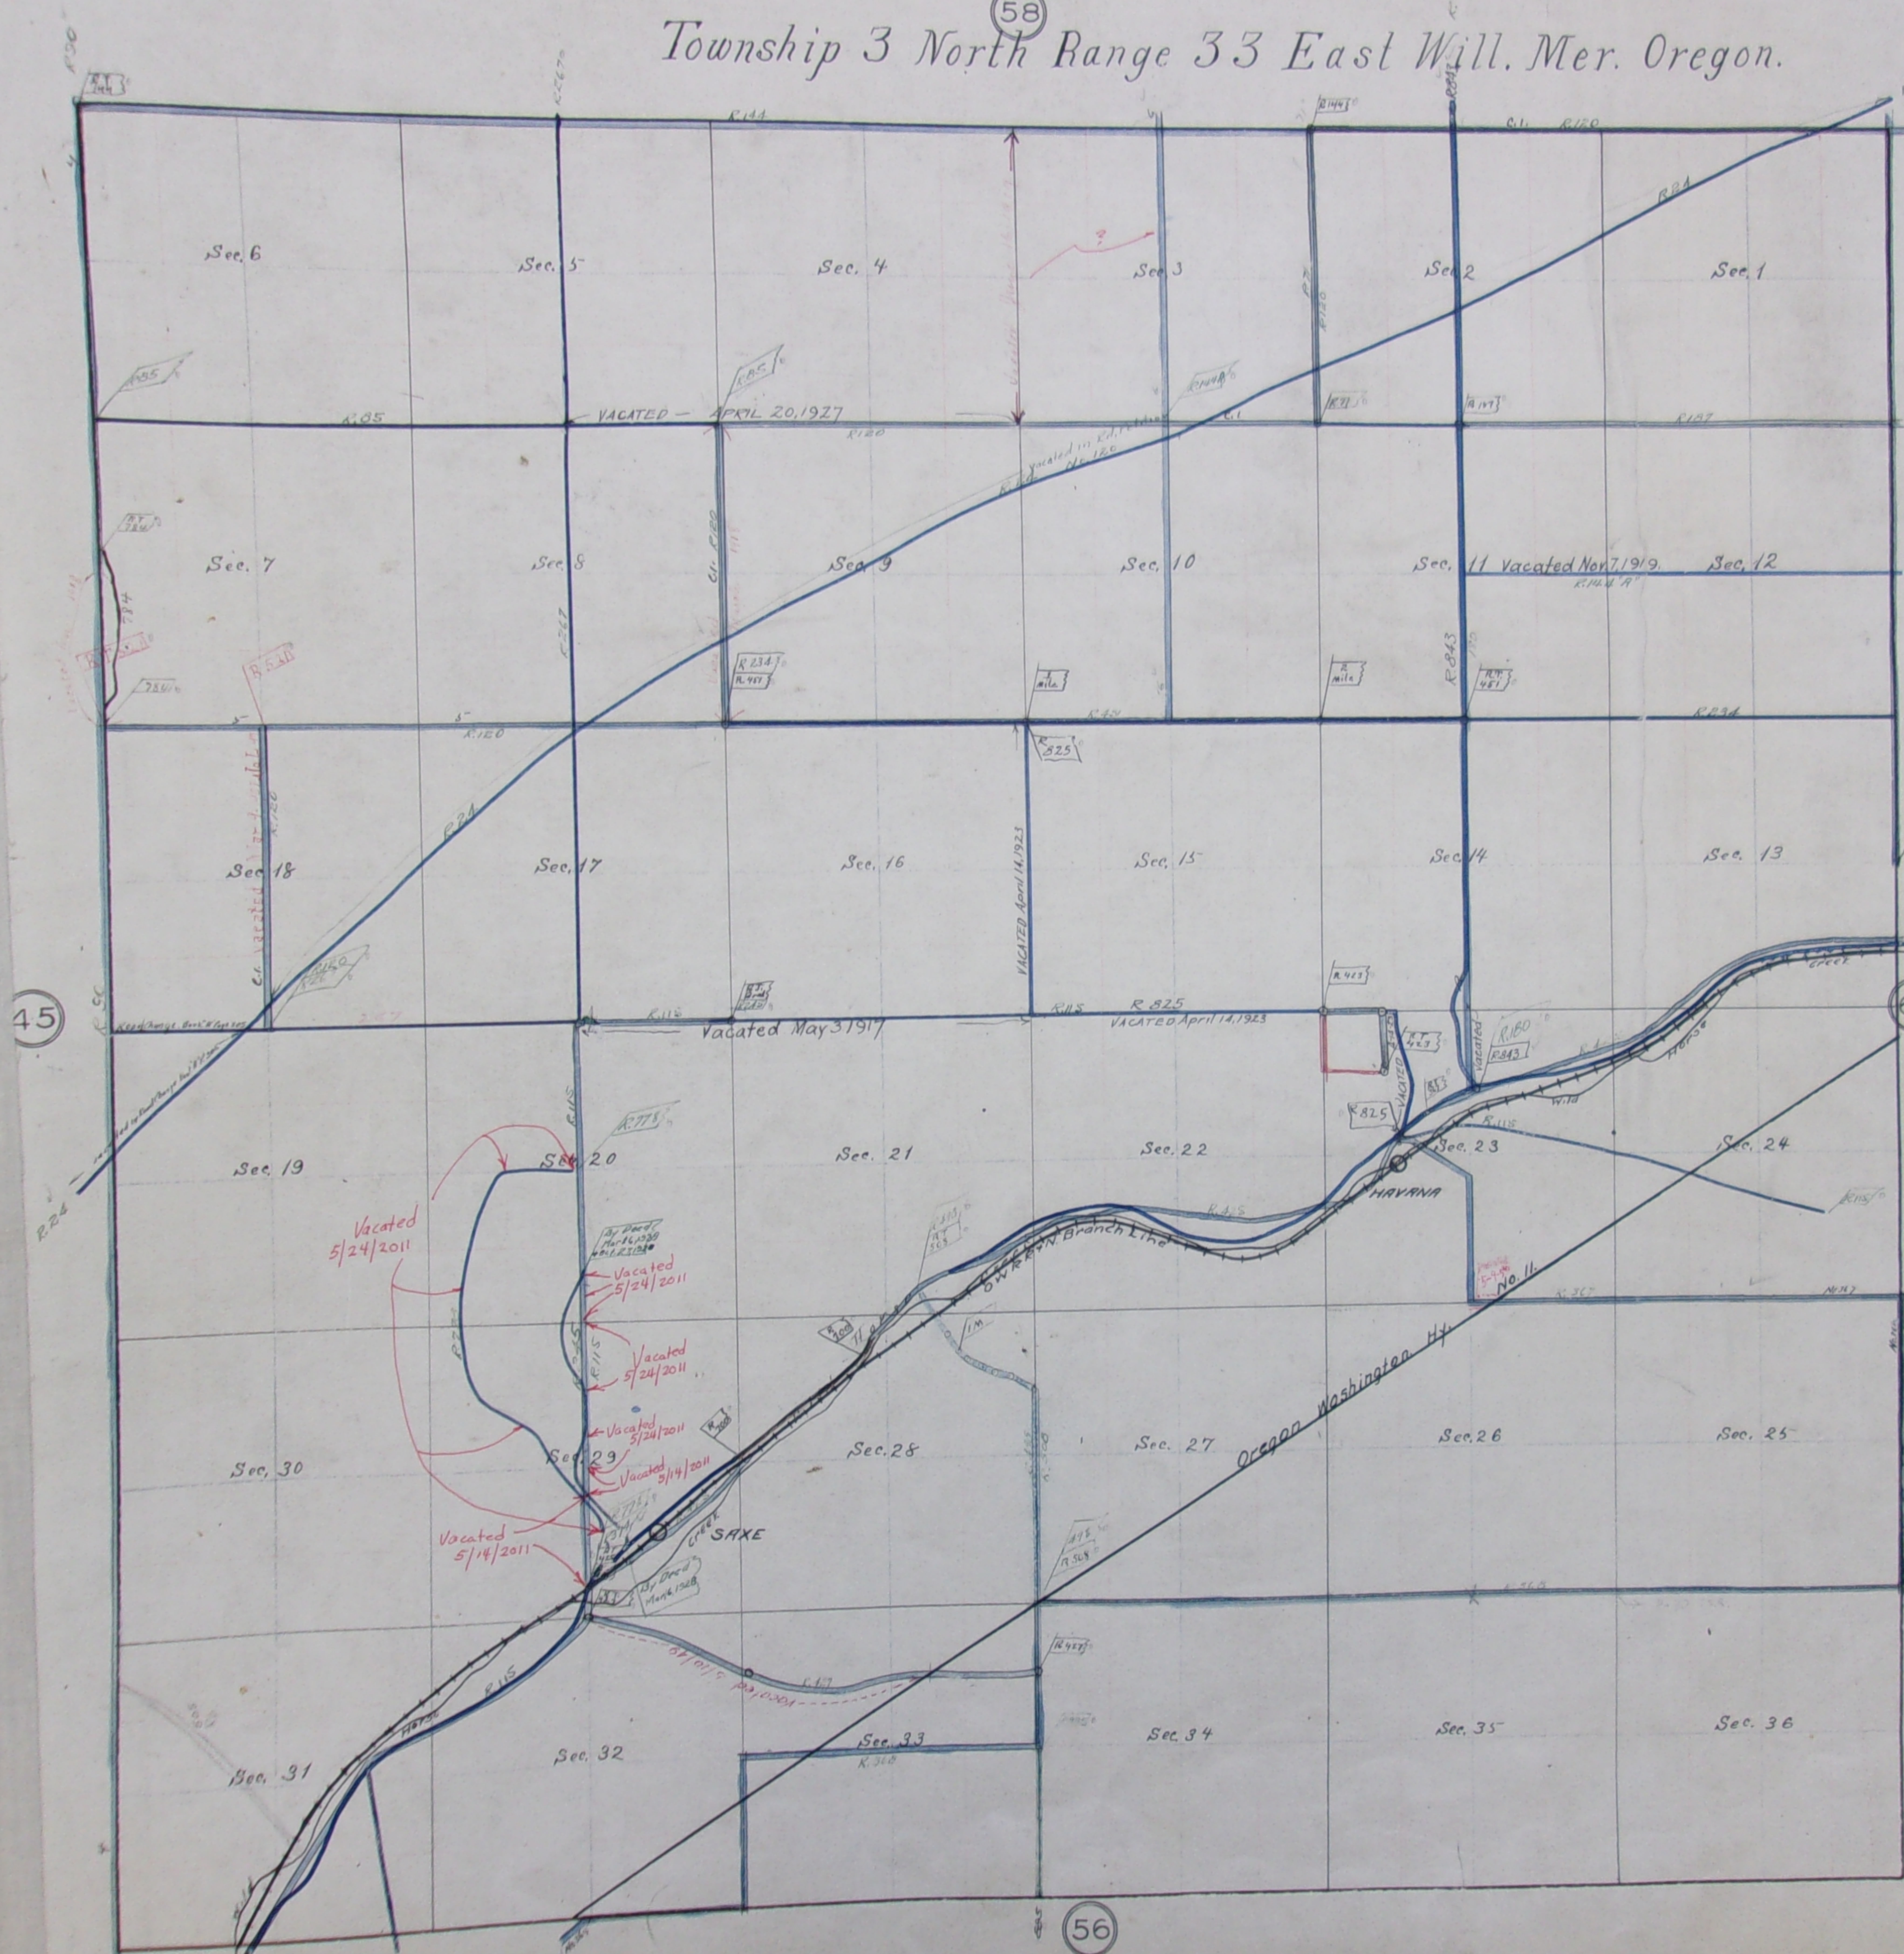

| Date | No. Box | Book Page | Date | No. Box | Book Page |
|----------------|---------|-----------|------|---------|-----------|
| Nov. 12 1894 | 451 134 | J 247 | | | |
| July 10 1893 | 433 132 | J 539 | | | |
| Nov. 13 1894 | 485 131 | J 102 | | | |
| Apr. 5 1893 | 427 131 | J 547 | | | |
| Nov. 7 1891 | 365 131 | H 745 | | | |
| Nov. 7 1891 | 367 131 | H 765 | | | |
| Nov. 6 1891 | 374 123 | J 74 | | | |
| Jan. 21 1888 | 223 | F 685 | | | |
| Apr. 9 1884 | 187 16 | F 422 | | | |
| July 11 1883 | 144 14 | F 45 | | | |
| July 6 1881 | 14 | E 200 | | | |
| May 1884 | 176 | E 365 | | | |
| Nov. 1881 | | E 291 | | | |
| July 1880 | | E 44 | | | |
| July 1880 | | D 651 | | | |
| July 1880 | | D 648 | | | |
| July 1879 | | C 329 | | | |
| Mar. 9 1870 | 521 133 | B 801 47 | | | |
| May 1, 1911 | 700 | M 529 | | | |
| Oct. 10, 1922 | 825 | O 109 | | | |
| April, 1924 | 843 | O | | | |
| July 6, 1929 | 885 | | | | |
| April 6, 1916 | 778 | | | | |
| March, 1918 | 784 | | | | |
| April 14, 1885 | 224 | | | | |
| Jan. 21 1885 | 245 | | | | |
| May 21 1884 | 100 | | | | |
| Sept. 15 1881 | 71 | | | | |
| July 15, 1880 | 85 | | | | |
| Sept. 11, 1880 | 90 | | | | |
| July 11, 1880 | 100 | | | | |
| July 3, 1872 | 24 | | | | |
| Jan. 24, 1882 | 115 | | | | |
| May 2, 1873 | 144 | | | | |
| Vacated | | | | | |
| 5/24/2011 | 718 | | | | |
| Vacated | | | | | |
| 5/24/2011 | 115 | | | | |
| Vacated | | | | | |
| 5/24/2011 | 245 | | | | |

Time Meridian
 15.0. from 15. to 21.15.0

Scale 25 chains to 1 inch.

45

66

56