


Township 1 South, Range 34 East, Will. Mer. Oregon.

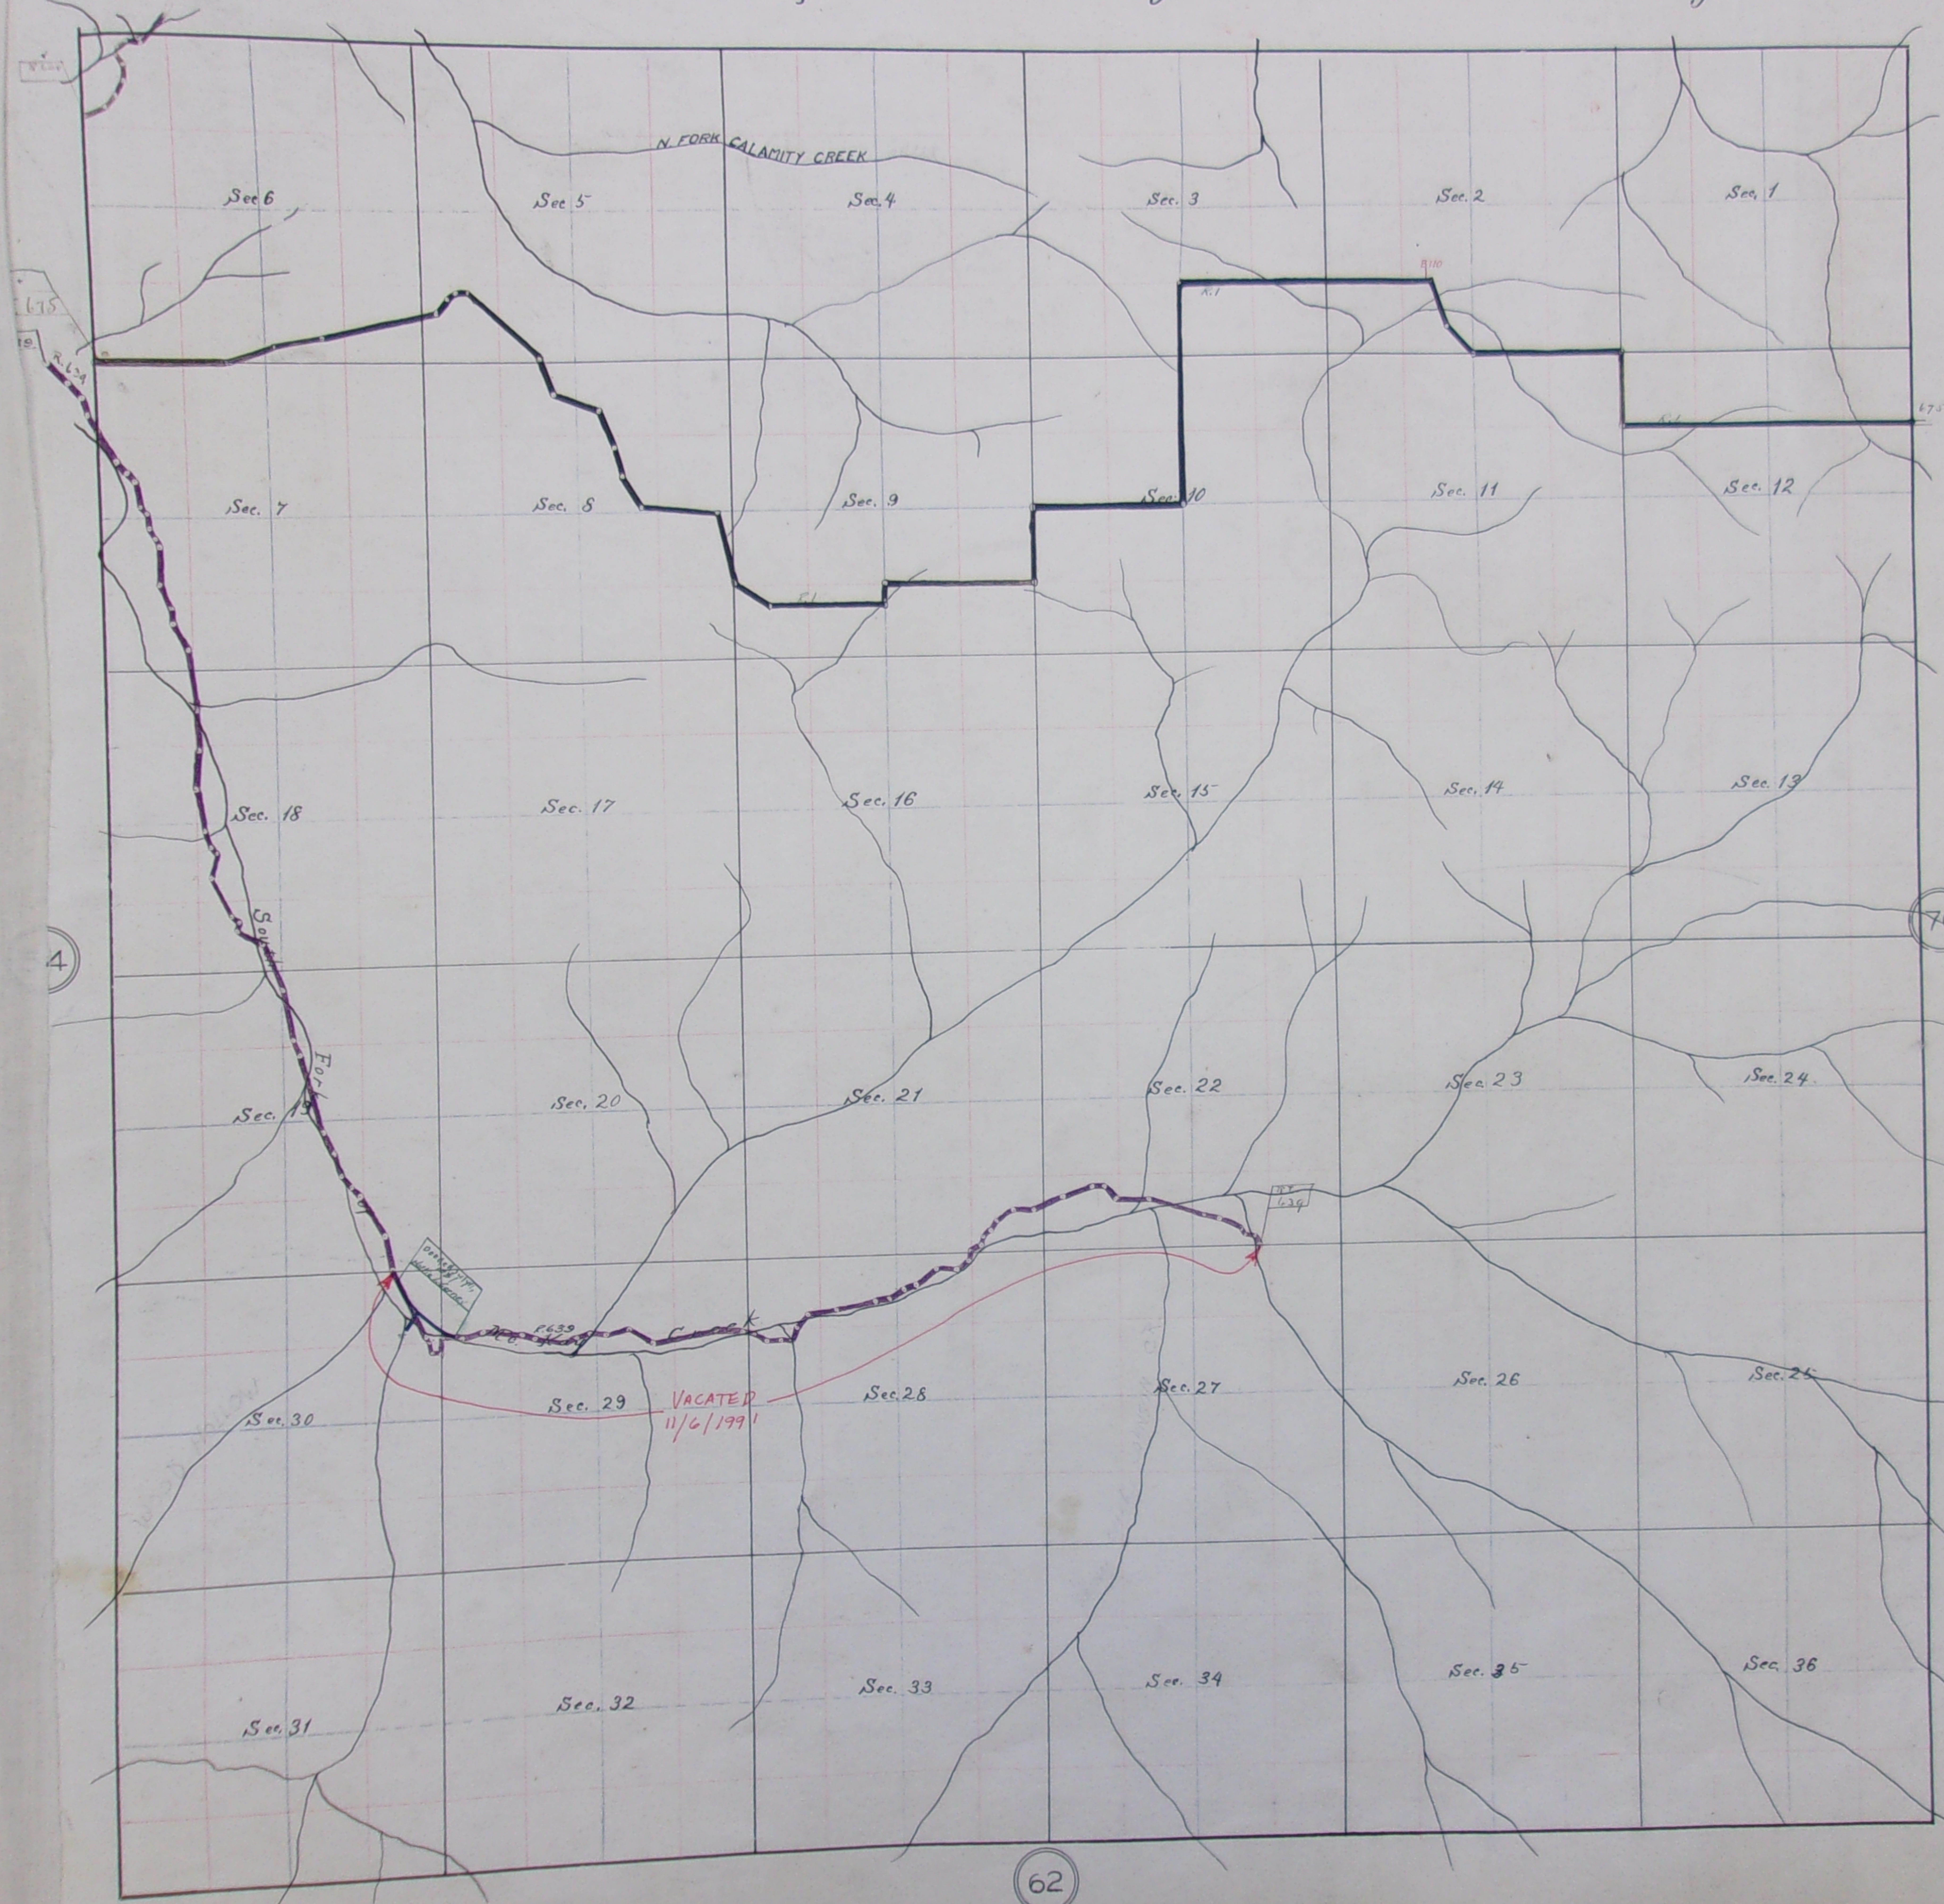

Date	No. Box	Book	Page	Date	No. Box	Book	Page
Feb. 8, 1908	639	233	M 246				
" " "	640	"	" 245				
Oct. 9, 1909	675						
May 12, 1900	1						
Vacated							
11/6/1991	639						

True Meridian
 No. 21 1/2' E.

Scale 25 chains to 1 inch.