


Township 5 North Range 34 East Will. Mer. Oregon.

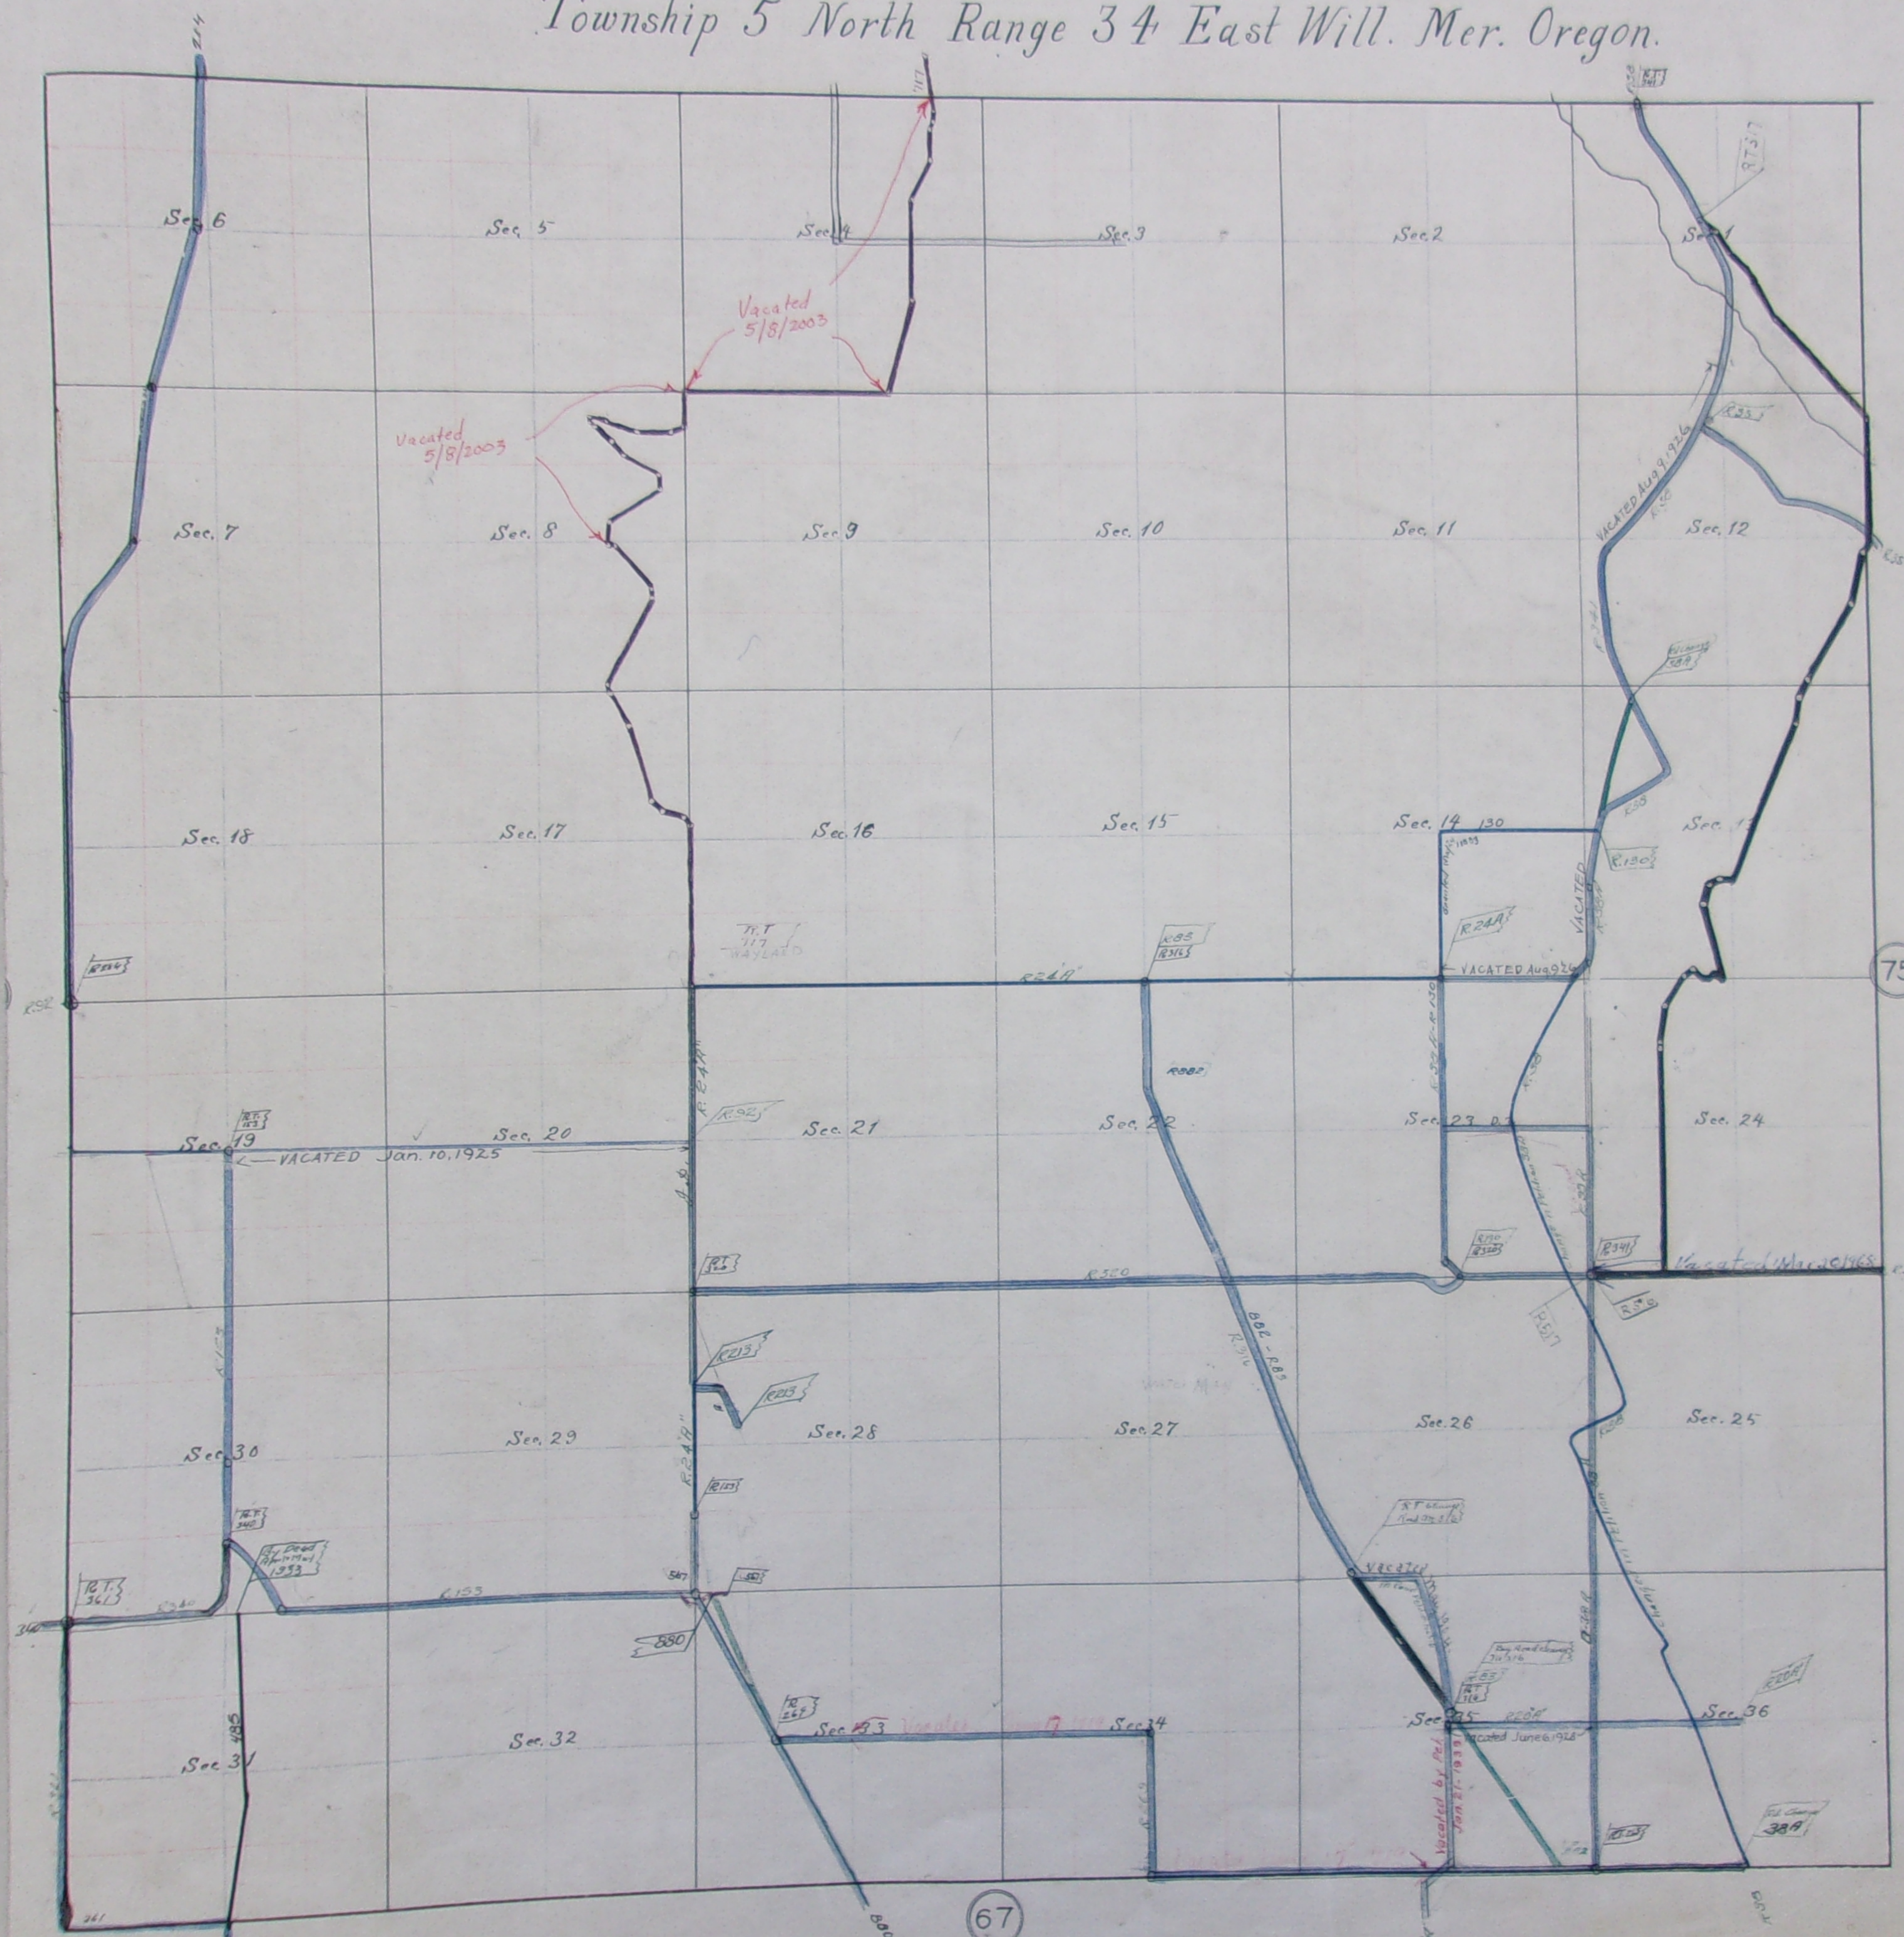

Date	No. Box	Book	Page	Date	No. Box	Book	Page
Sept 10 1871	361	129	H 24				
May 12 1870	341	128	H 576				
July 16 1878	340	128	H 575				
July 13 1877	244	19	S 583				
Oct 18 1866	269	18	S 399				
July 10 1883	153	14	F 52				
Apr 2 1869	316	124	H 308				
Apr 3 1887	320	124	H 311				
Feb 11 1874	8		F 240				
July 10 1878	269		S 380				
July 10 1878	269		S 380				
June 9 1879			C 270				
Apr 7 1874	835		B 451				
Jan 4 1901	516		L 67				
Jan 7 1901	517		L 67				
May 1901	316		L 67				
July 1911	717		L 547				
July 6 1923	880						
July 6 1923	882						
July 10 1913	244						
April 1874	38						
Sept 1880	85						
Jan 11 1894	23						
Sept 1880	52						
May 24 1852	150						
Vacated 5/8/2003	717						

75

True Meridian
 True Meridian
 True Meridian

Scale 25 chains to 1 inch.