


Township 5 North, Range 35 East Will. Mer. Oregon.

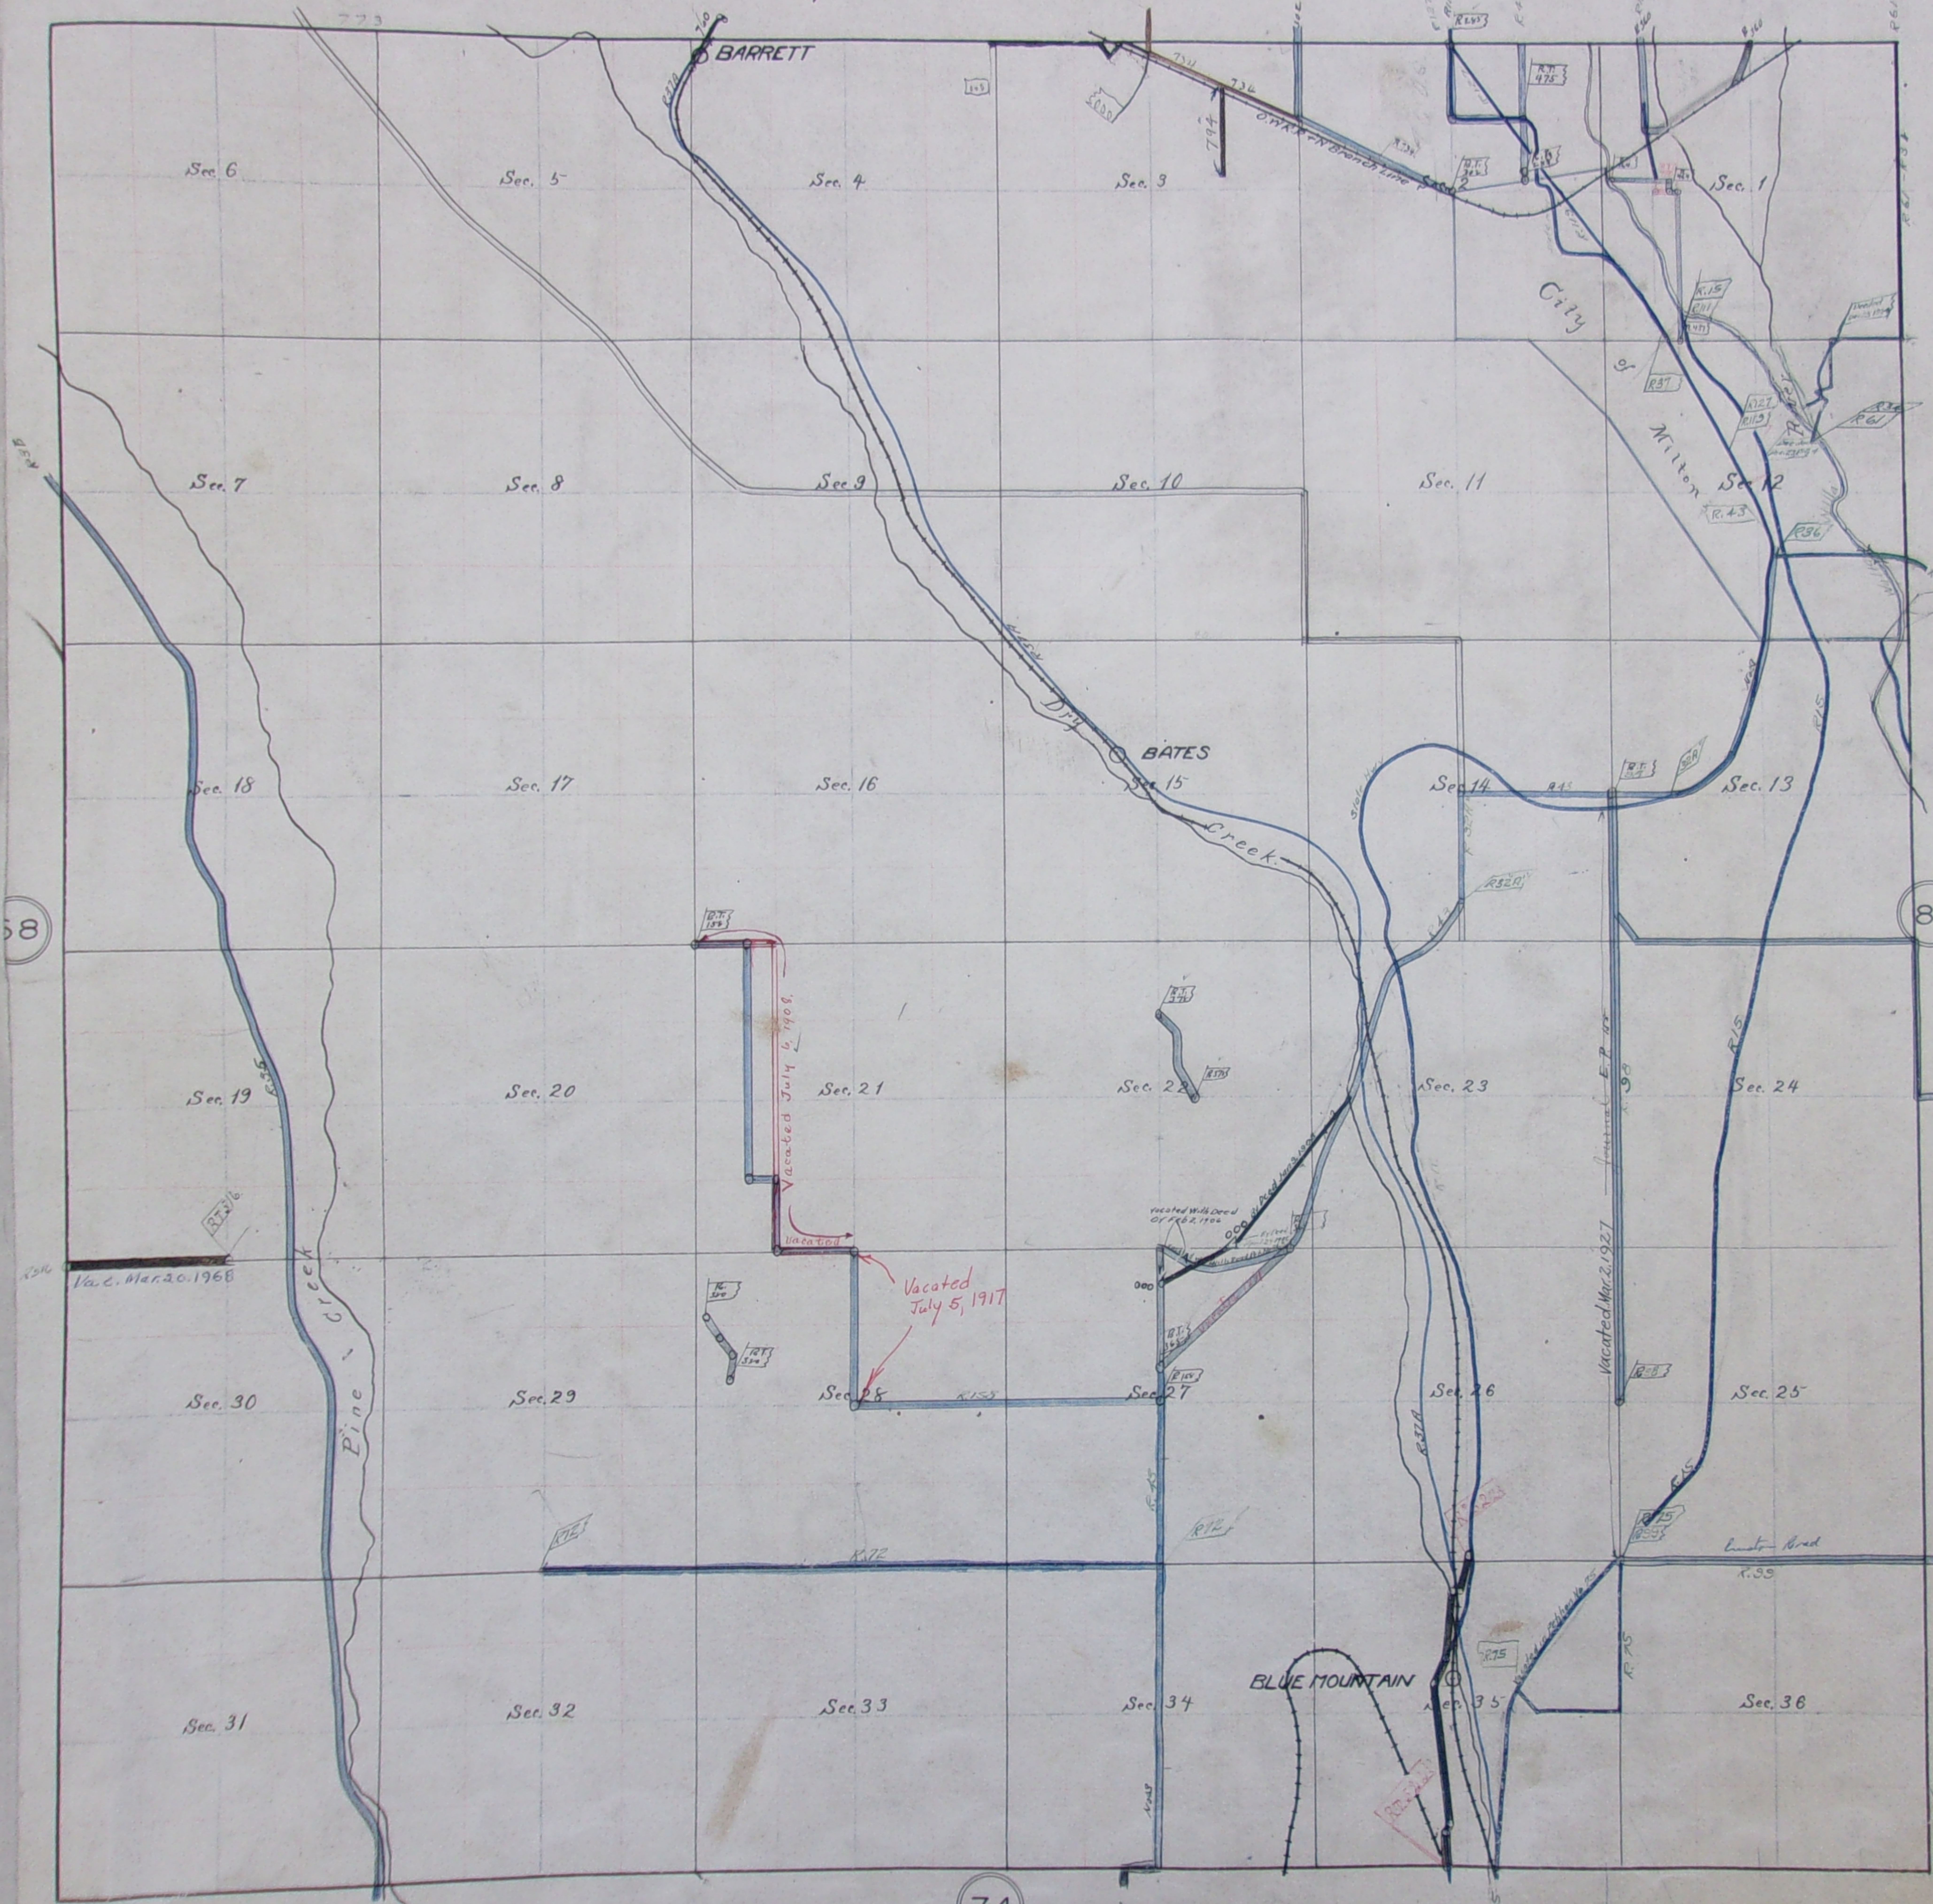

Date	No.	Box	Book	Page	Date	No.	Box	Book	Page
Nov 5 1876	475	134	J	623	710				
Apr 7 1875	464	132	J	441					
July 7 1874	437	132	J	181					
May 6 1872	380	129	J	34					
July 10 1871	360	129	H	72					
Sept 10 1871	345	129	J	23					
July 13 1867	255	19	S	583					
July 10 1863	138	14	F	125					
April 1858	302	124							
Apr 8 1851		12	E	15					
May 17 1850	59	12	D	60					
Nov 1831	378		J	77					
Sept 1880			E	41					
Jan 1879	72		S	380					
Oct 5 1875	43		R	578					
Sept 10 1874	35		B	451					
Mar 9 1901	522	3501	L	98					
Jan 7 1901	516	3506	L	67					
Nov 6 1903	000								
Mar 9 1906	000	B563		615					
July 6 1908				462	711				
Feb 9 1912		734	772						
" 5 1914		760	N 133						
Mar 7 1919		794	N 438						
April 3 1881	98								
Jan 10 1853	127								
Oct 3 1871	15								
July 10 1874	37								
Sept 10 1870	328								
April 4 1858	61								
July 9 1874	54								
July 9 1874	36								
Sept 1879	75								
Jan 23 1882	111								
Vacated July 5 1917	158								

True Meridian  
Var. from 20 to 21 1/2'

Scale 25 chains to 1 inch.

76

8

81

74