


Township 3 North, Range 36 East, Will. Mer. Oregon.

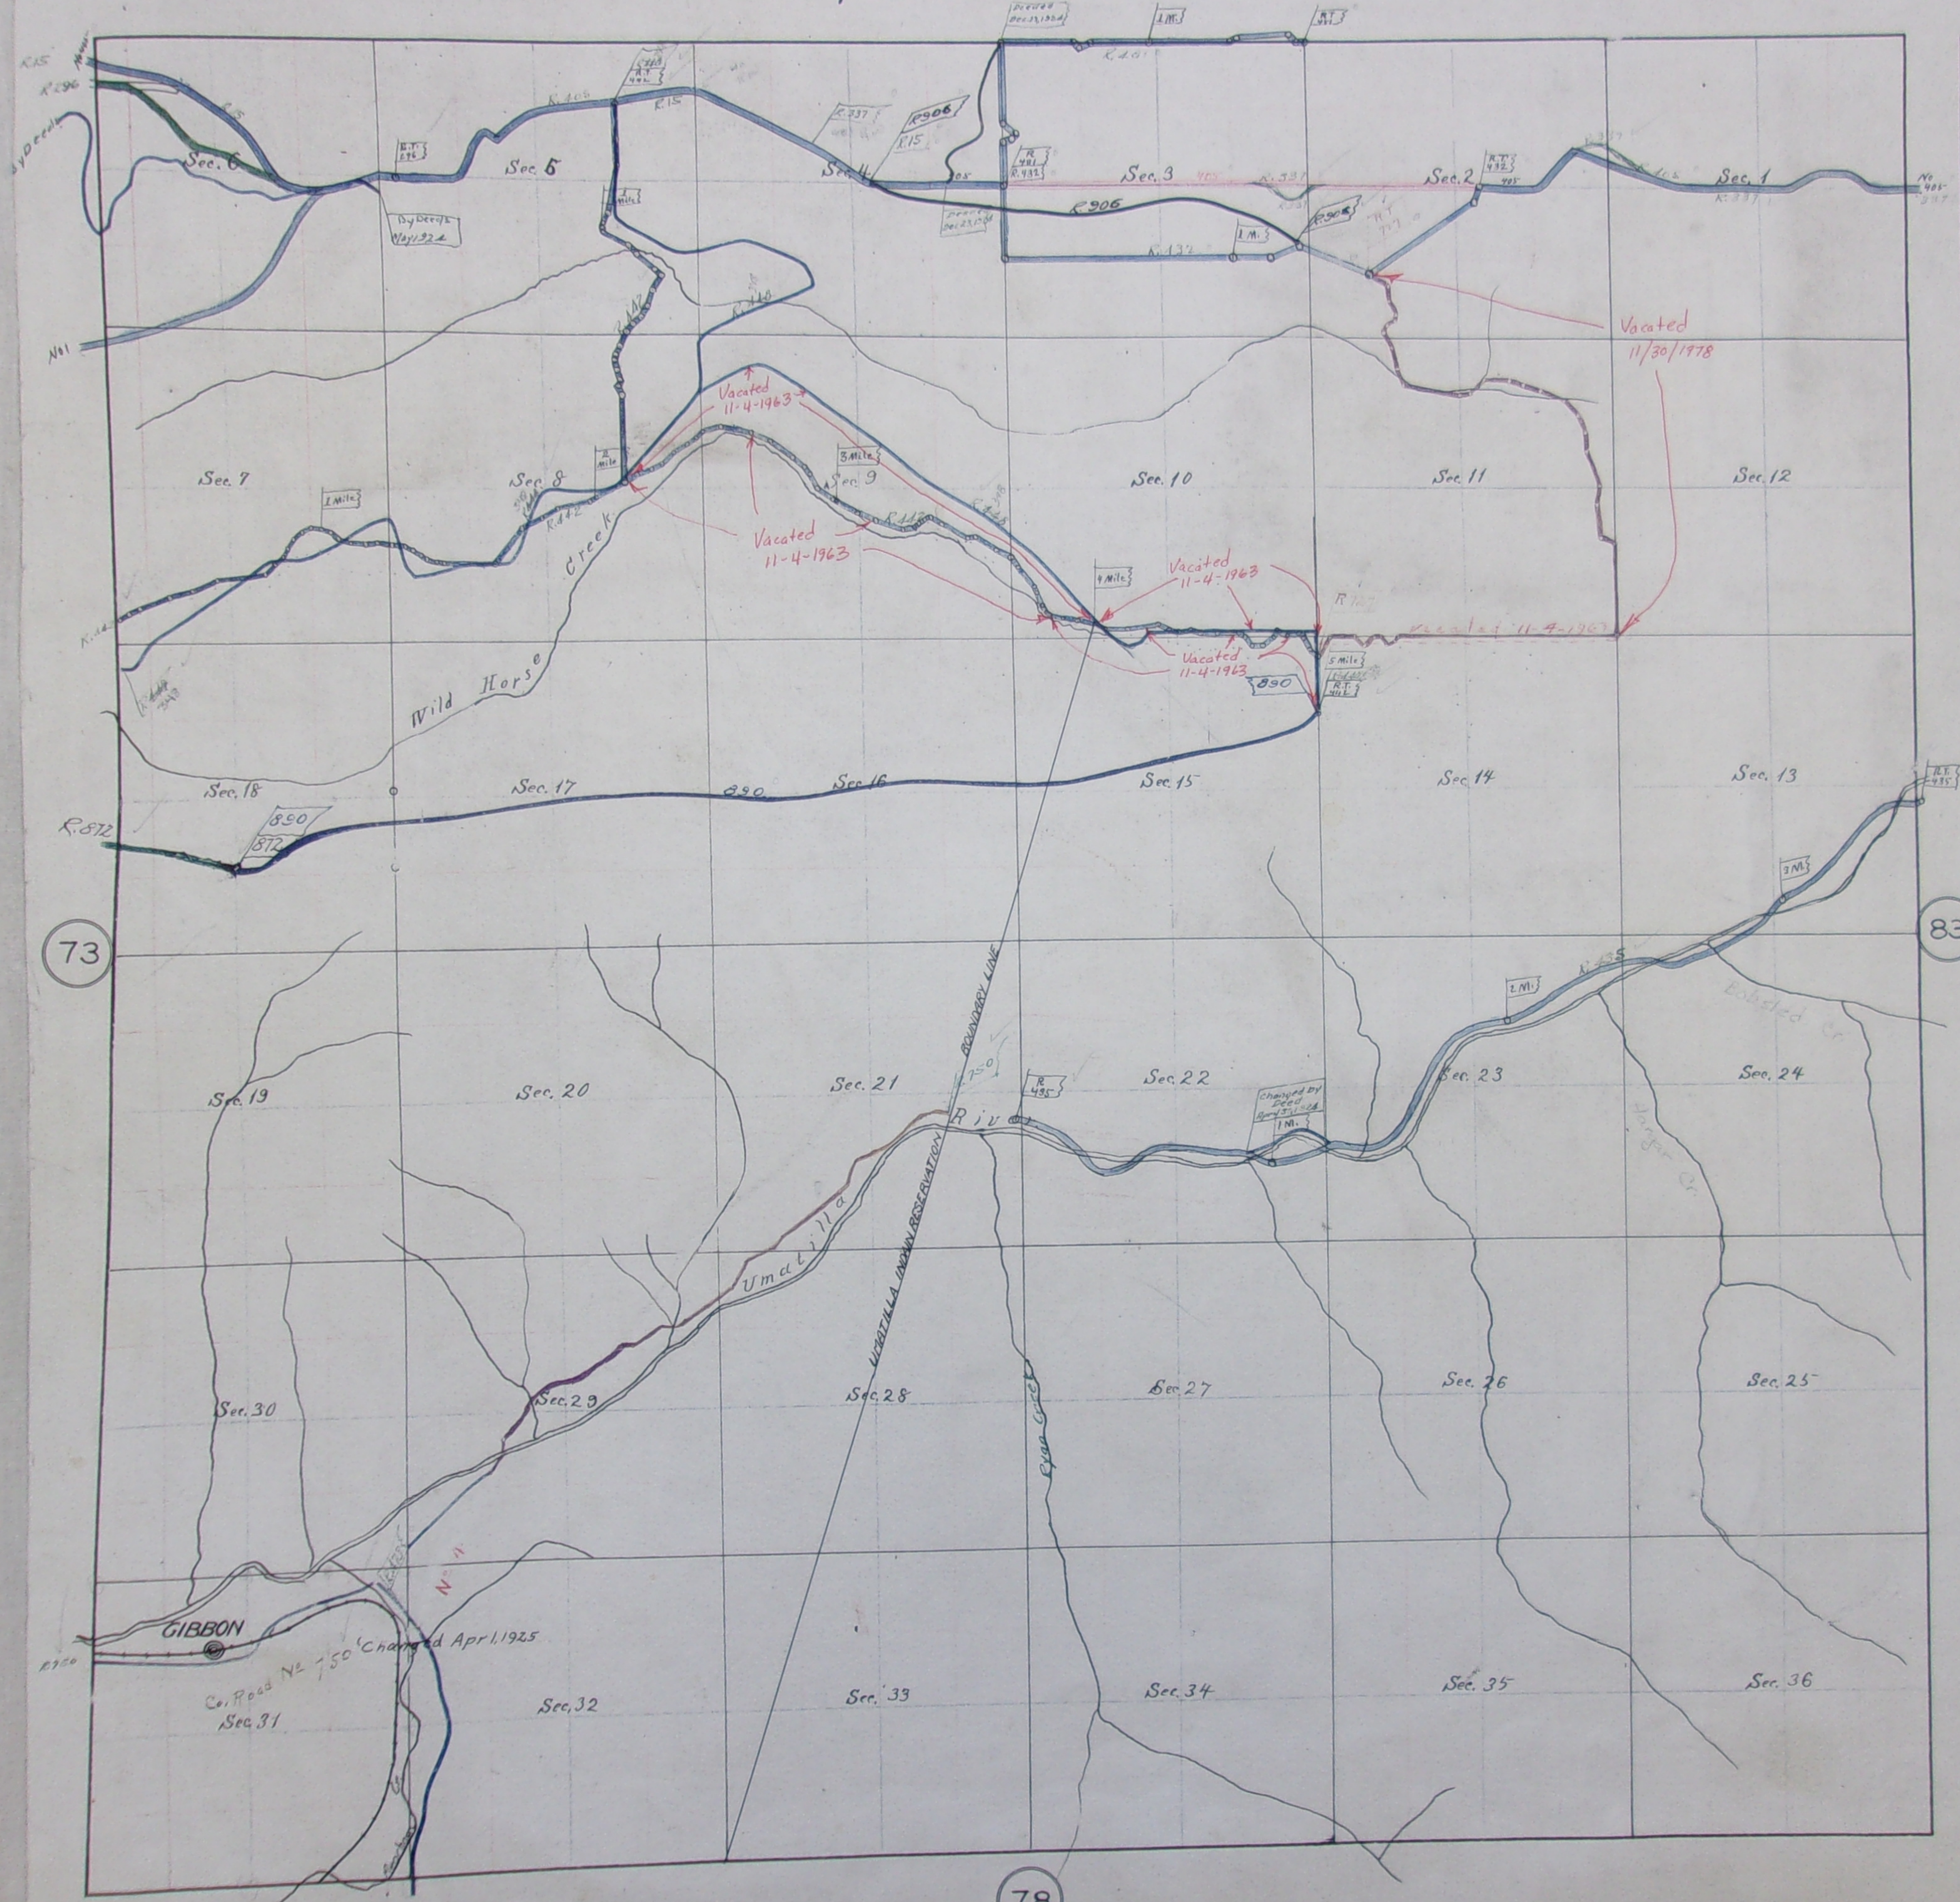

Date	No. Box	Book	Page	Date	No. Box	Book	Page
Sept 10 1874	442	134	J 214				
Sept 10 1876	478	134	J 177				
Jan. 21 1877	461	134	16 41				
May 10 1874	435	131	J 109				
Sept 1873	432	131	J 607				
Sept 1873	401	131	J 107				
Nov 12 1872	405	130	J 318				
Jan 7 1875	296		S 704				
Apr 1875			S 421				
Oct 5 1911	727		M 588				
June 5 1913			N 79				
July 7 1928	872		O 611				
Aug 5 1820	880						
July 16 1830	837						
Mar. 6 1881	722						
Oct 18 1871	15						
July 5 1833	906						
Vacated							
Nov. 9 1963	348						
Vacated							
Nov. 4 1963	442						
Vacated							
11/30/1978	727						

True Meridian
 Box from 15° to 22 1/2° E

Scale 25 chains to 1 inch.