


Township 4 North, Range 36 East, Will. Mer. Oregon.

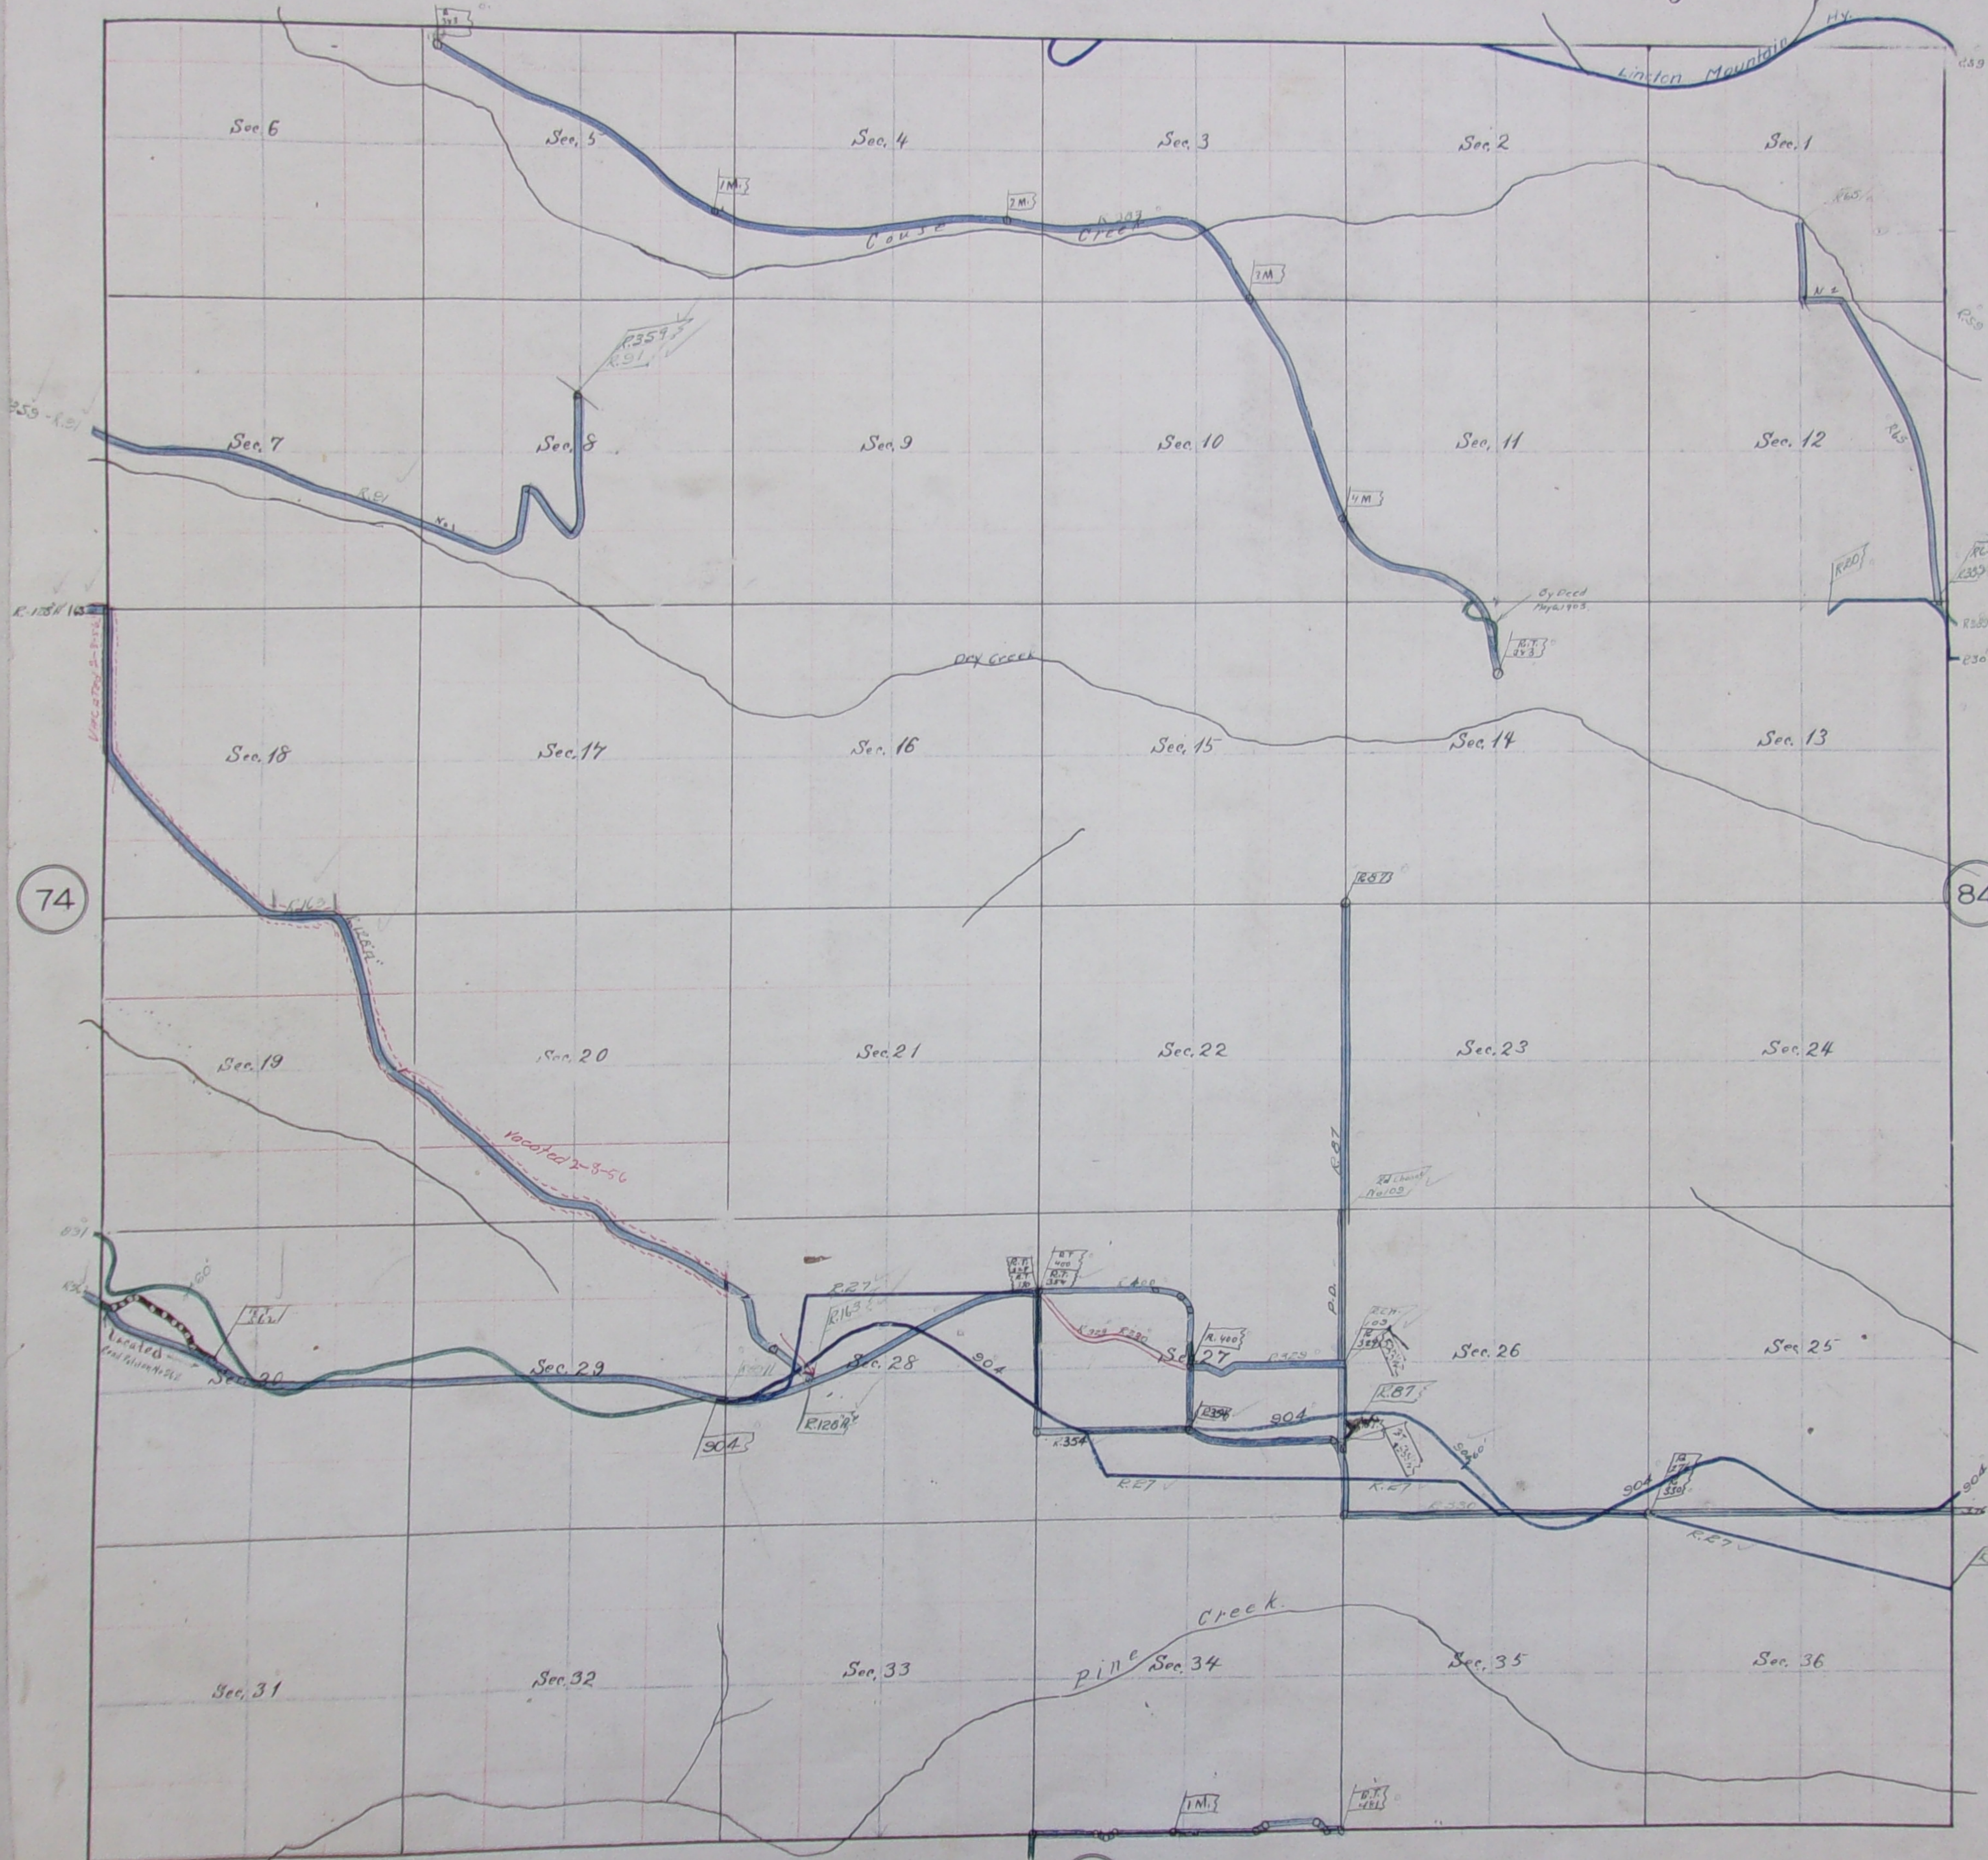

Date	No. Box	Book	Page	Date	No. Box	Book	Page
Jan 11 1877	1412	184	K 41				
Jan 7 1879	400	131	J 307				
Mar. 11 1872	383	123	J 192				
Mar. 6 1871	354	128	H 712				
May 10 1870	320	128	H 543				
July 17 1870	329	128	H 552				
Jan 15 1867	276	19	G 471				
Aug 22 1871	87	13	E 162				
Sept 9 1870	110	12	E 63				
Sept 1870	91		E 43				
Sept 1878	65		C 216				
July 12 1867			L 240				
Sept 10 1870	556	270	L 428				
Nov 8 1829	891						
May 25 1822	904						
Jan 15 1864	163						
Jan 23 1862	103		E 205				
Jan 7 1863	27		B 265				
Jan 1873	30						
April 5 1877	50						
Sept 1820	359		E				
April 4 1878	53						
Jan 1875	123A						

74

84

79

Trac Meridian
 1000 feet from 16 1/2 to 24 1/2

Scale 25 chains to 1 inch.