


Township 5 North Range 38 East Will. Mer. Oregon

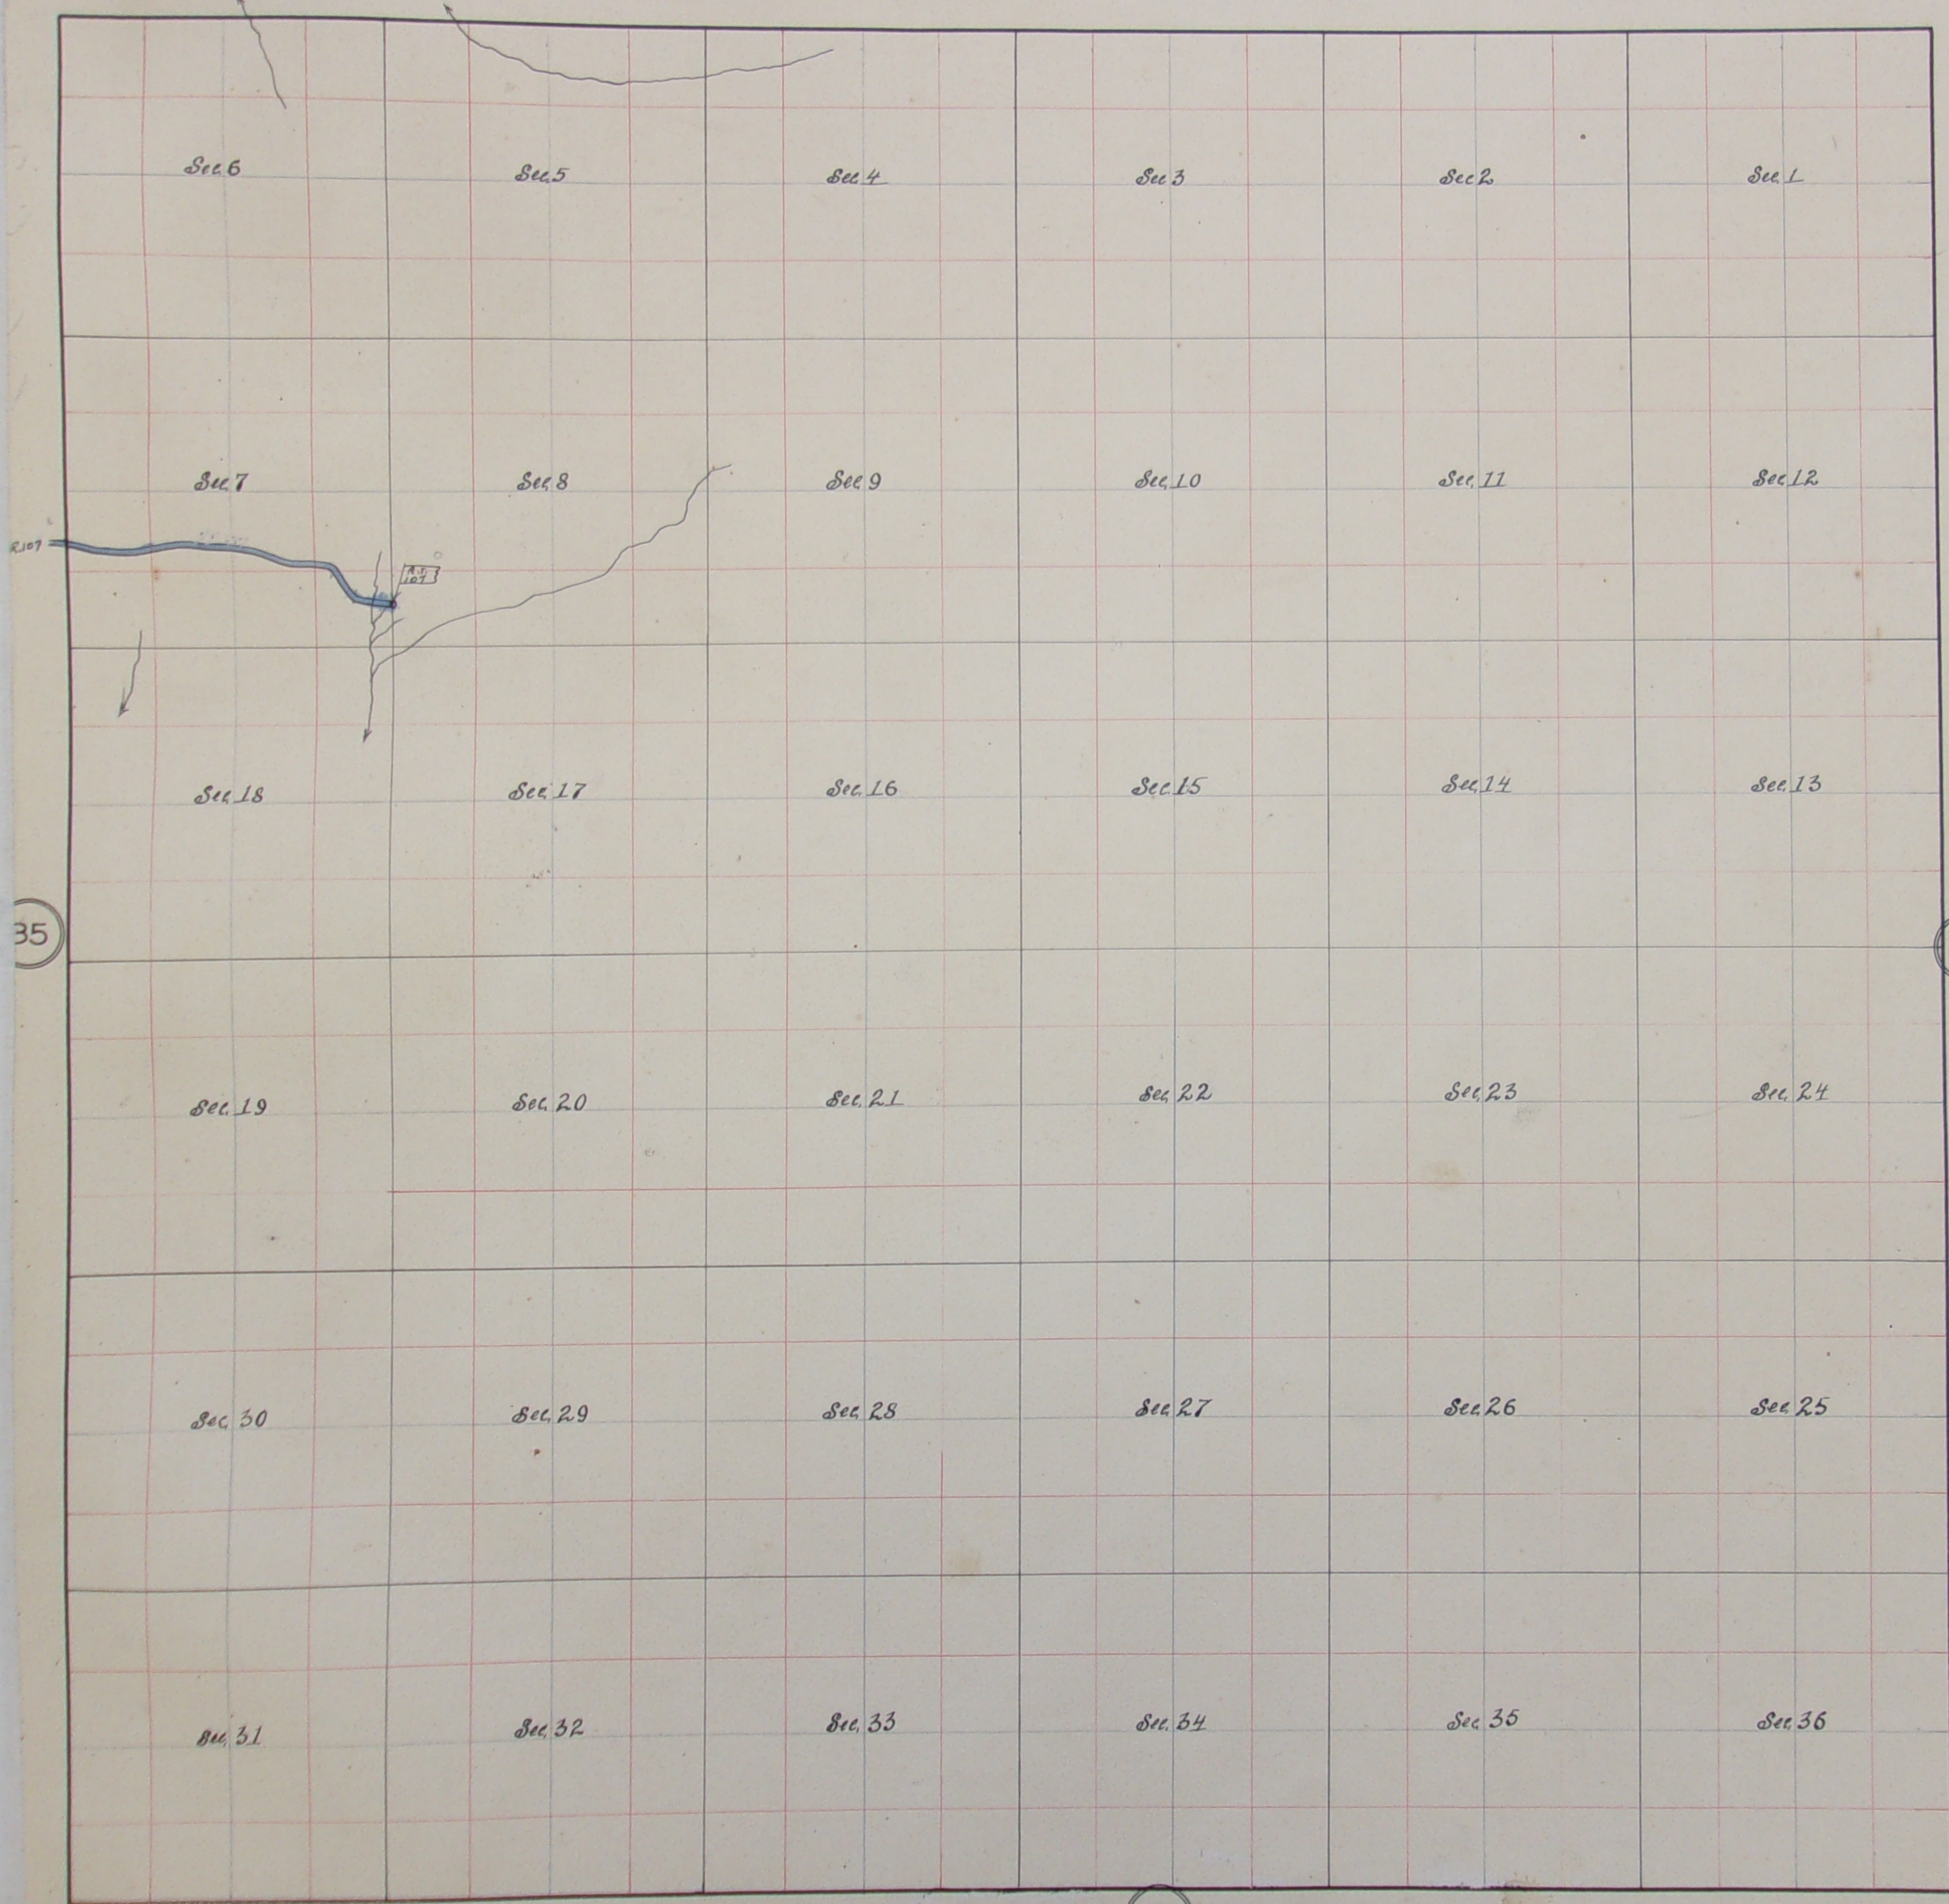

Date	No.	Box	Book	Page	Date	No.	Box	Book	Page
Sept. 11, 1891	107		E	248					

True Meridian
Var. from P.M. 11 1/2 E.

Scale 25 chains to 1 inch