



UMATILLA COUNTY  
 COUNTY ENGINEER'S OFFICE  
**WESTON MOUNTAIN MARKET ROAD NO. 7**  
 UNITS NO. 1 & 2  
 CONSTRUCTED LINE  
 SCALE 1 IN. = 400 FT. DEC. 1925

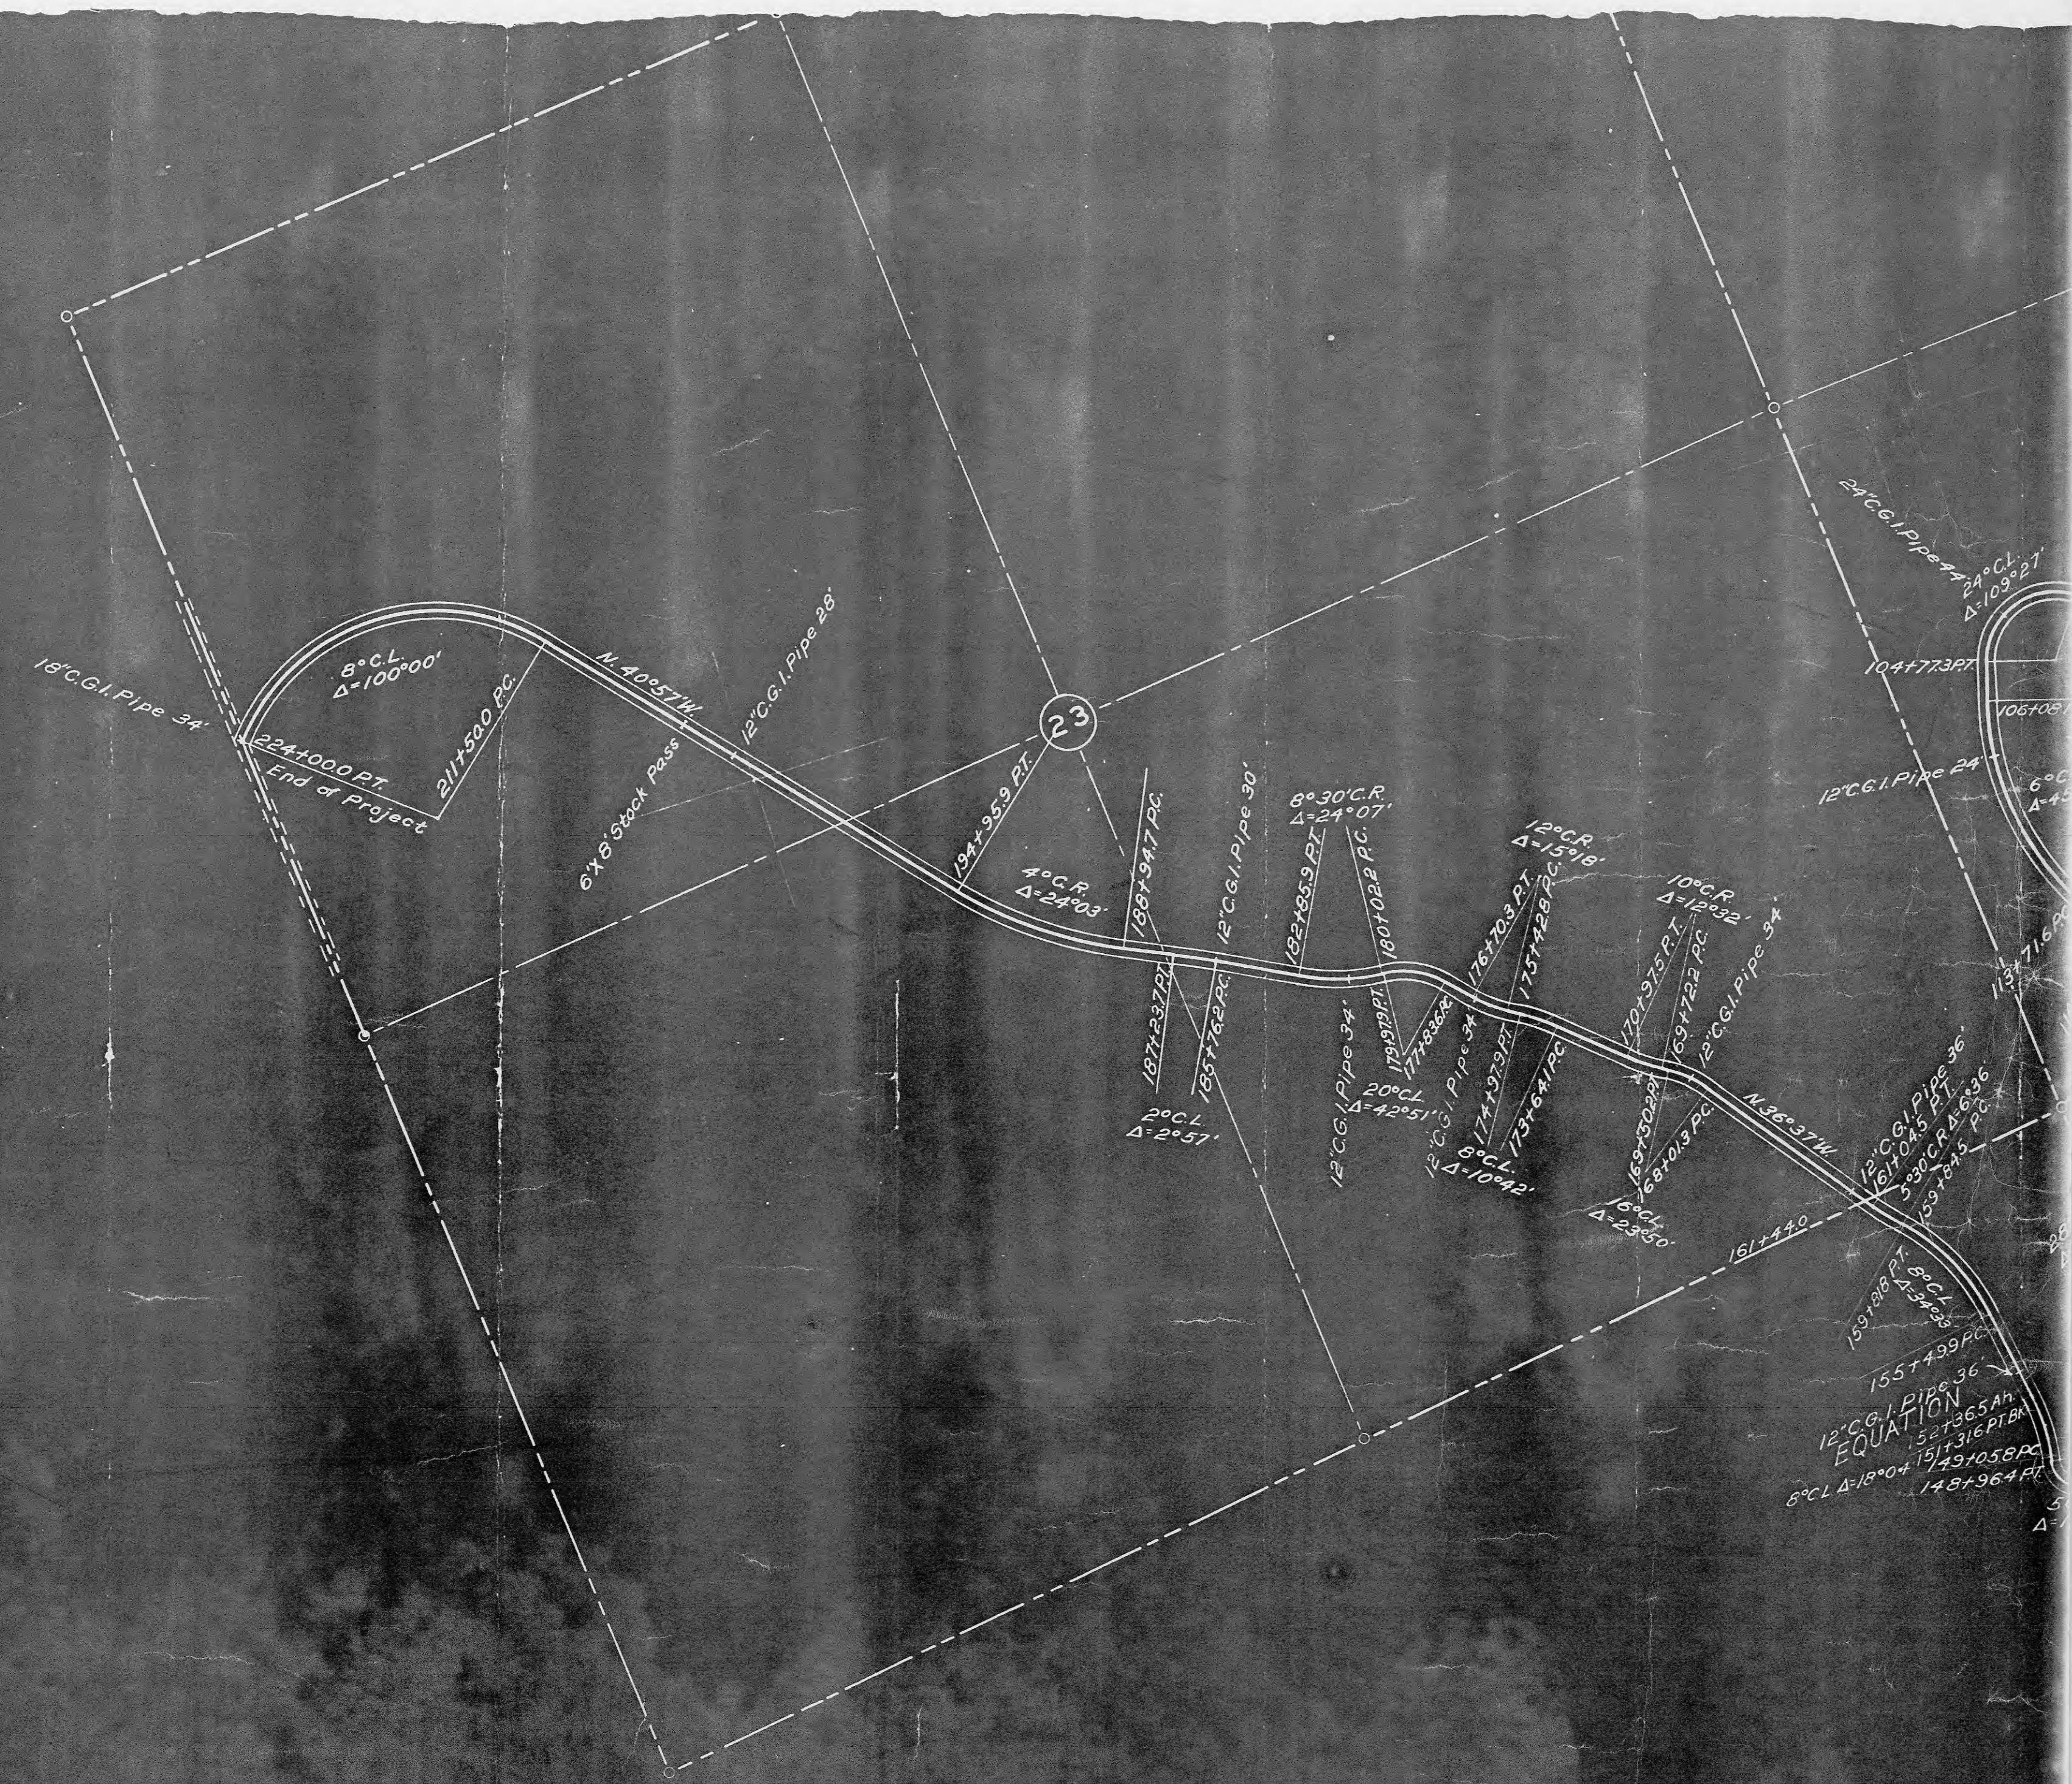

12" C.G.I. PIPE 36"  
 EQUATION  
 521365.54  
 15119316.18  
 17491058.82  
 1781964.47

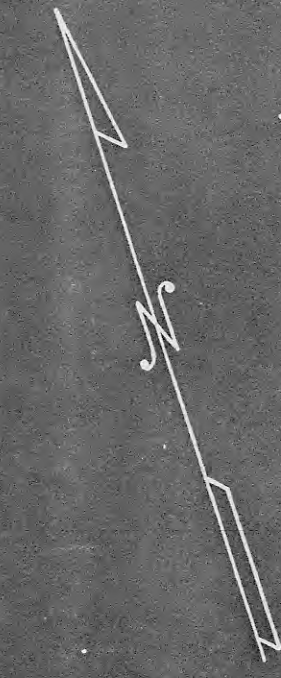

Box 22



TAN RISE N.M.  
4 N. R. 35 E. N.M.

EQUATION  
14300 Unit  
0+00 Unit

EQUATION  
25137.1  
25137.1  
25137.1

EQUATION  
100 C.R.  
Δ=25°19'

29

16  
16  
16  
End of Project