OREGON STATE HIGHWAY DEPARTMENT

Relocated Line as Constructed

TUTUILLA CREEK SECTION
PENDLETON-JOHN DAY HIGHWAY

UMATILLA COUNTY

Scale 1 in. = 100 ft.

L. R. Chandler March 1940
JULY 1946

R/W revised June 1946, ownership info. brought up to date
L.R. Chandler

5F 4-6
SH. 1

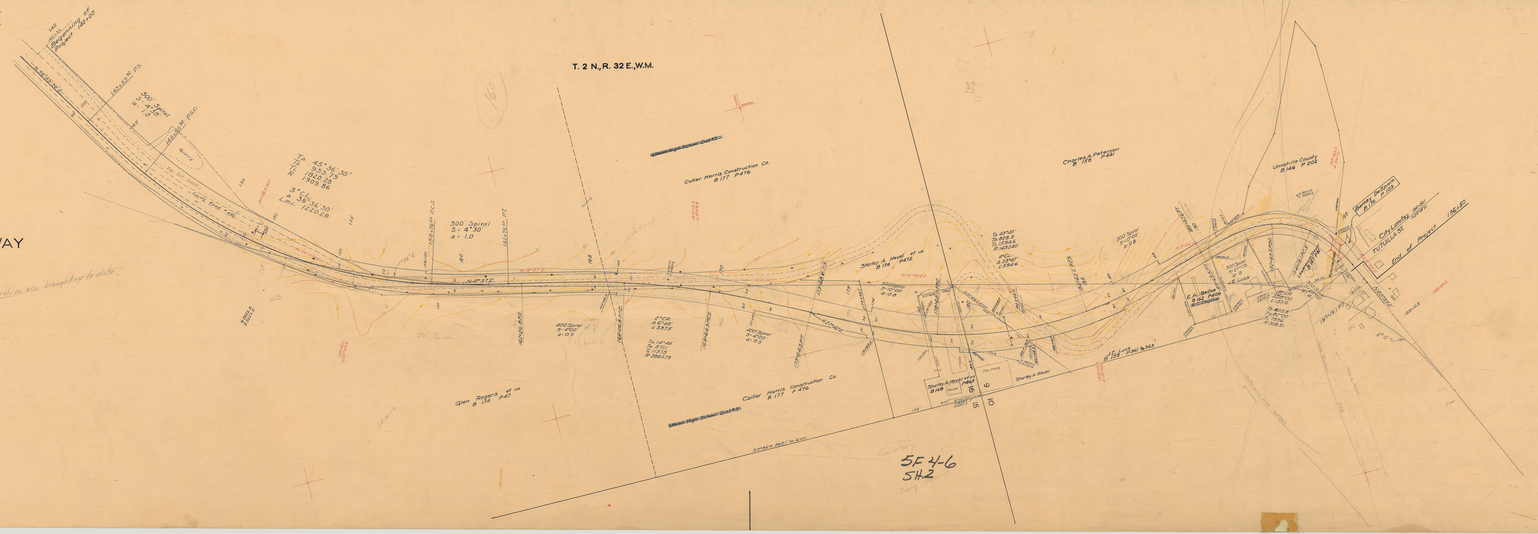
T. 2 N., R. 32 E., W.M.
Cutler Harris Construction Co.
Chauncey Peterson
Umatilla County
Glen Rogers et ux
Cutler Harris Construction Co.
Stanley A. Hewitt et ux
Stanley A. Hewitt
Stanley A. Hewitt et ux
Stanley A. Hewitt et ux
Stanley A. Hewitt et ux