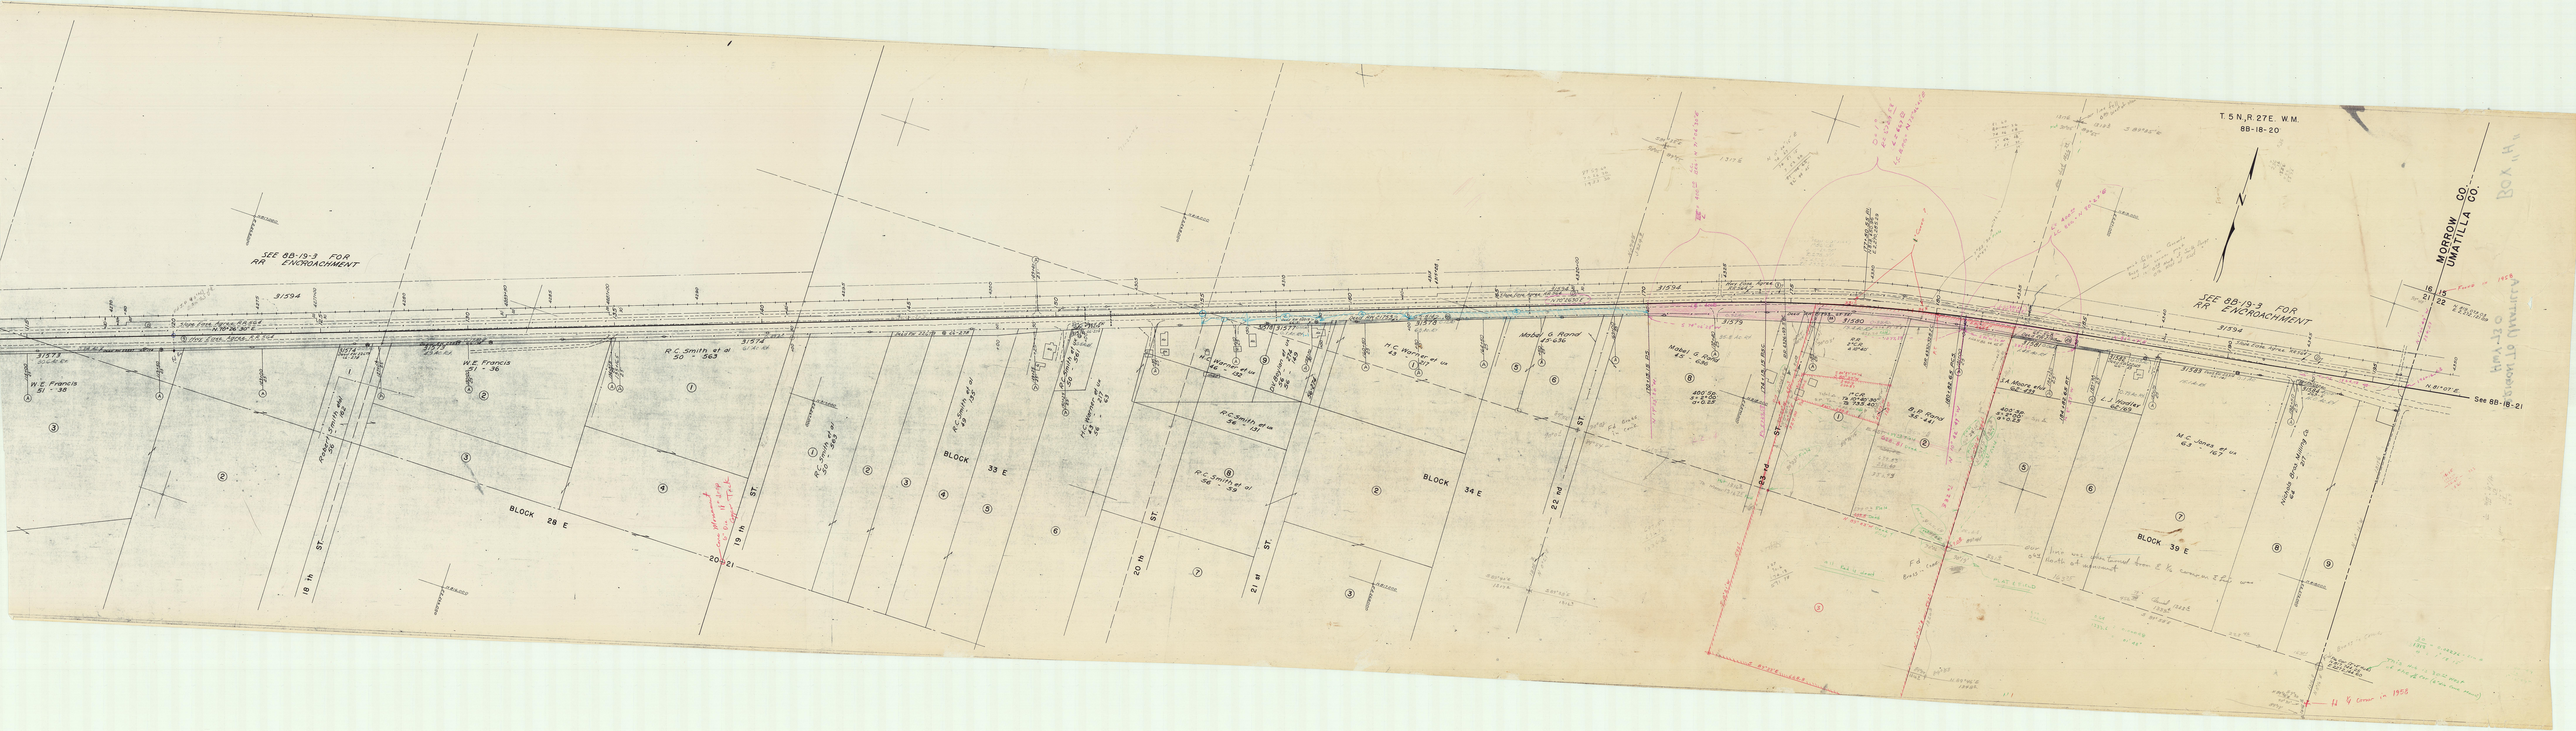
T. 5 N., R. 27 E. W.M.
88-18-20
SEE 88-19-3 FOR RR ENCROACHMENT
SEE 88-19-3 FOR RR ENCROACHMENT
MORROW CO.
UMATILLA CO.
See 88-18-21
BLOCK 28 E
BLOCK 33 E
BLOCK 34 E
BLOCK 39 E
18 th ST.
19 th ST.
20 th ST.
21 st ST.
22 nd ST.
M. C. Jones et ux 63 - 167
3/1594
3/1574
3/1577
3/1579
3/1580
3/1583
3/1585
3/1586
