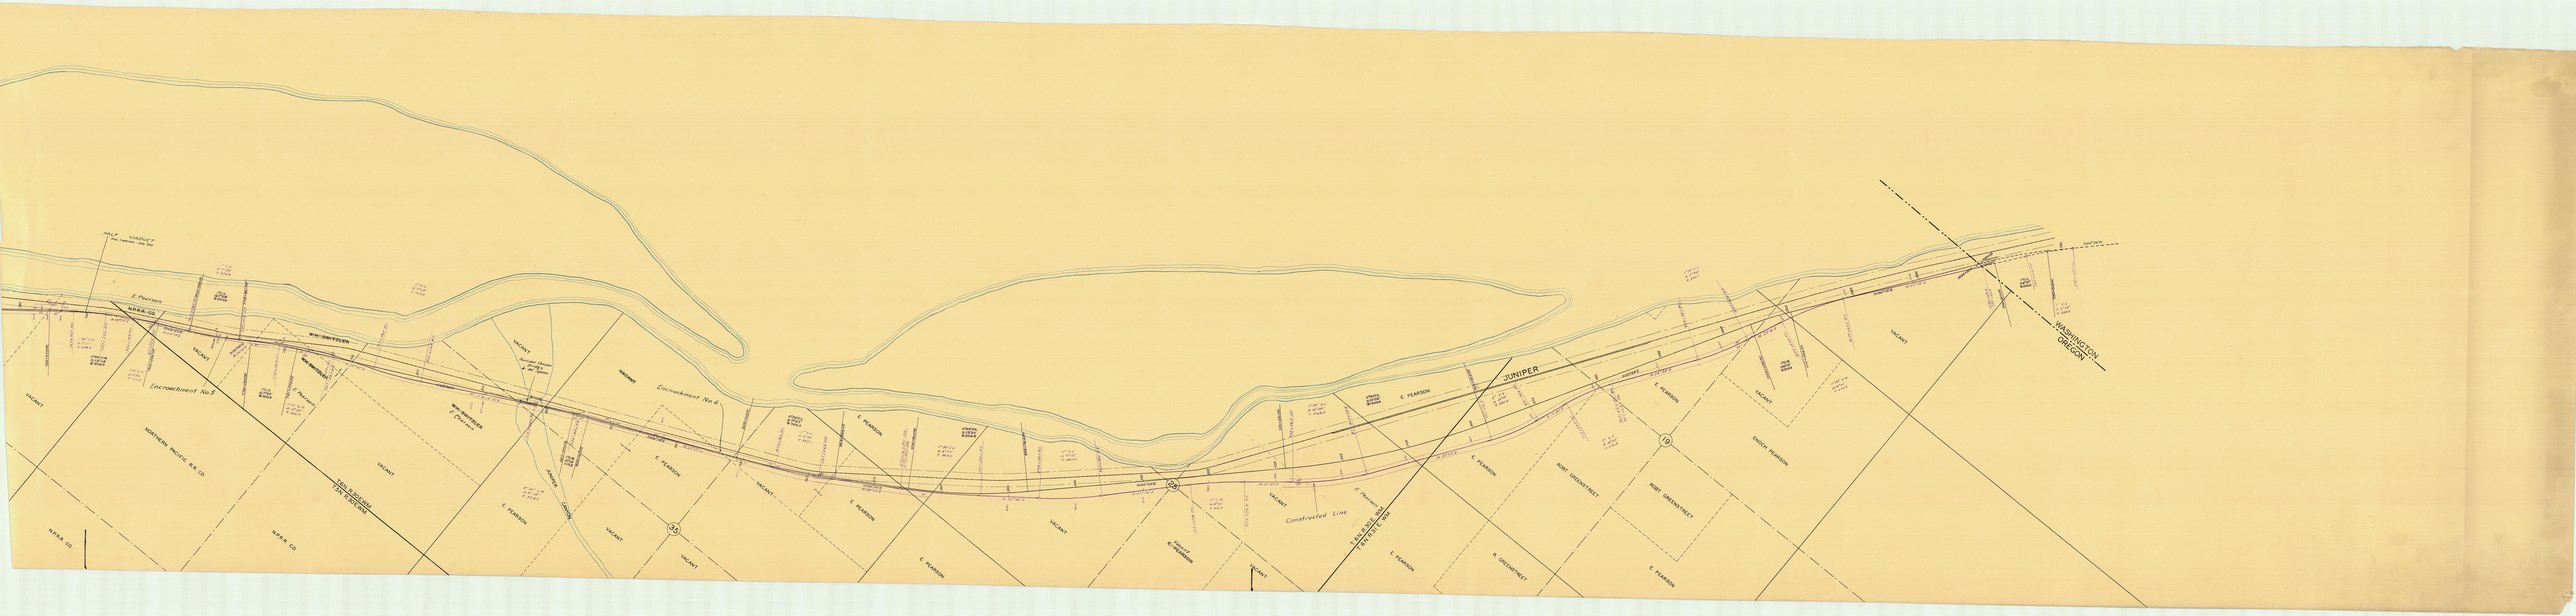
HALF VIADUCT
E. Pearson
N.P.R.R. CO
WM. SWITZLER
VACANT
Encroachment No. 6
NORTHERN PACIFIC R.R. CO
E. PEARSON
JUNIPER
Constructed Line
ROBT. GREENSTREET
R. GREENSTREET
ENOCH PEARSON
WASHINGTON
OREGON
