OREGON STATE HIGHWAY DEPARTMENT
CONSTRUCTED LINE
OREGON-WASHINGTON HIGHWAY
UMATILLA COUNTY
MILTON-WASHINGTON STATE LINE SECTION

Scale 1in=100ft

Construction Began May 20,1919 Completed Apr. 27, 1920.

V. Waggener, Resident Engineer.

Approved ..... 1920.

State Highway Engineer.

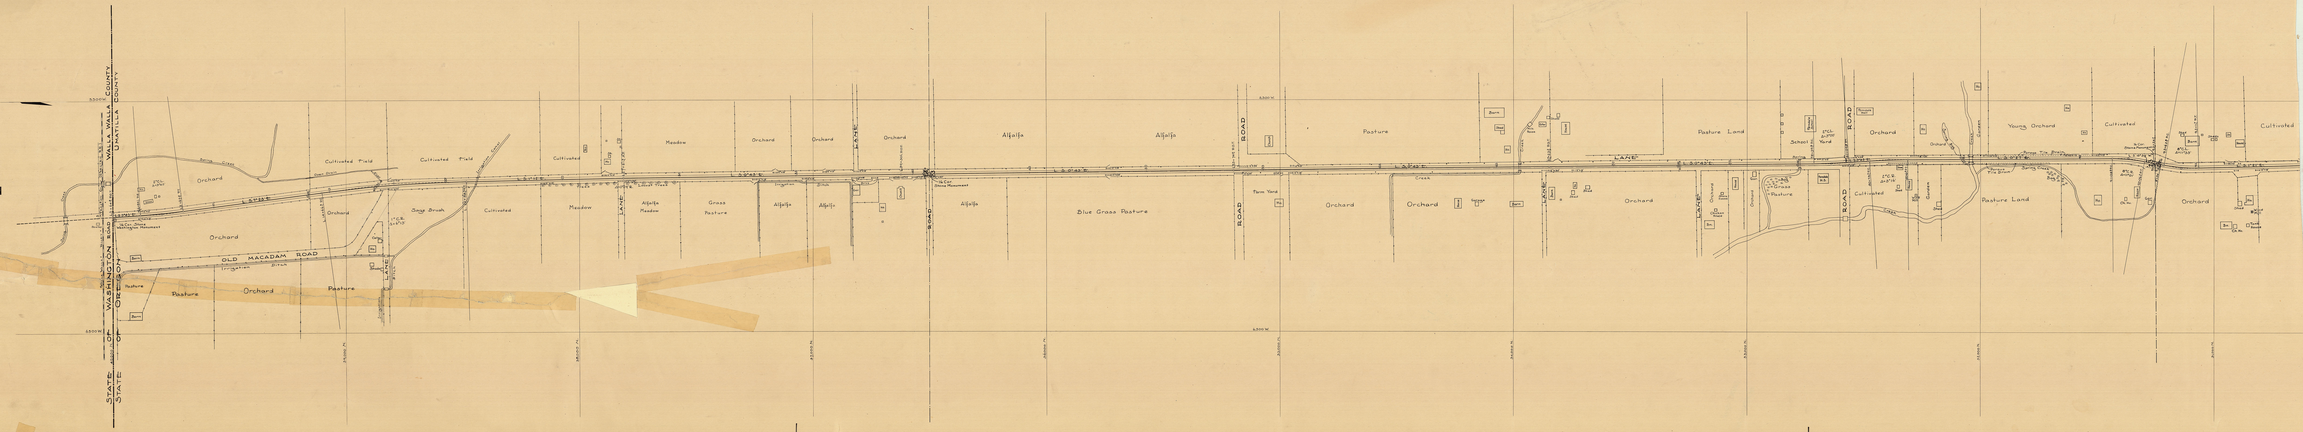
STATE OF WASHINGTON
STATE OF OREGON
WALLA WALLA COUNTY
UMATILLA COUNTY
LANE
ROAD
OLD MACADAM ROAD
Orchard
Pasture
Cultivated Field
Cultivated
Meadow
Grass Pasture
Alfalfa
Alfalfa Meadow
Blue Grass Pasture
Farm Yard
Pasture Land
School
Young Orchard
Creek
Bridge
Cow Barn
Stone Monument
Irrigation Ditch
Dry Ditch
