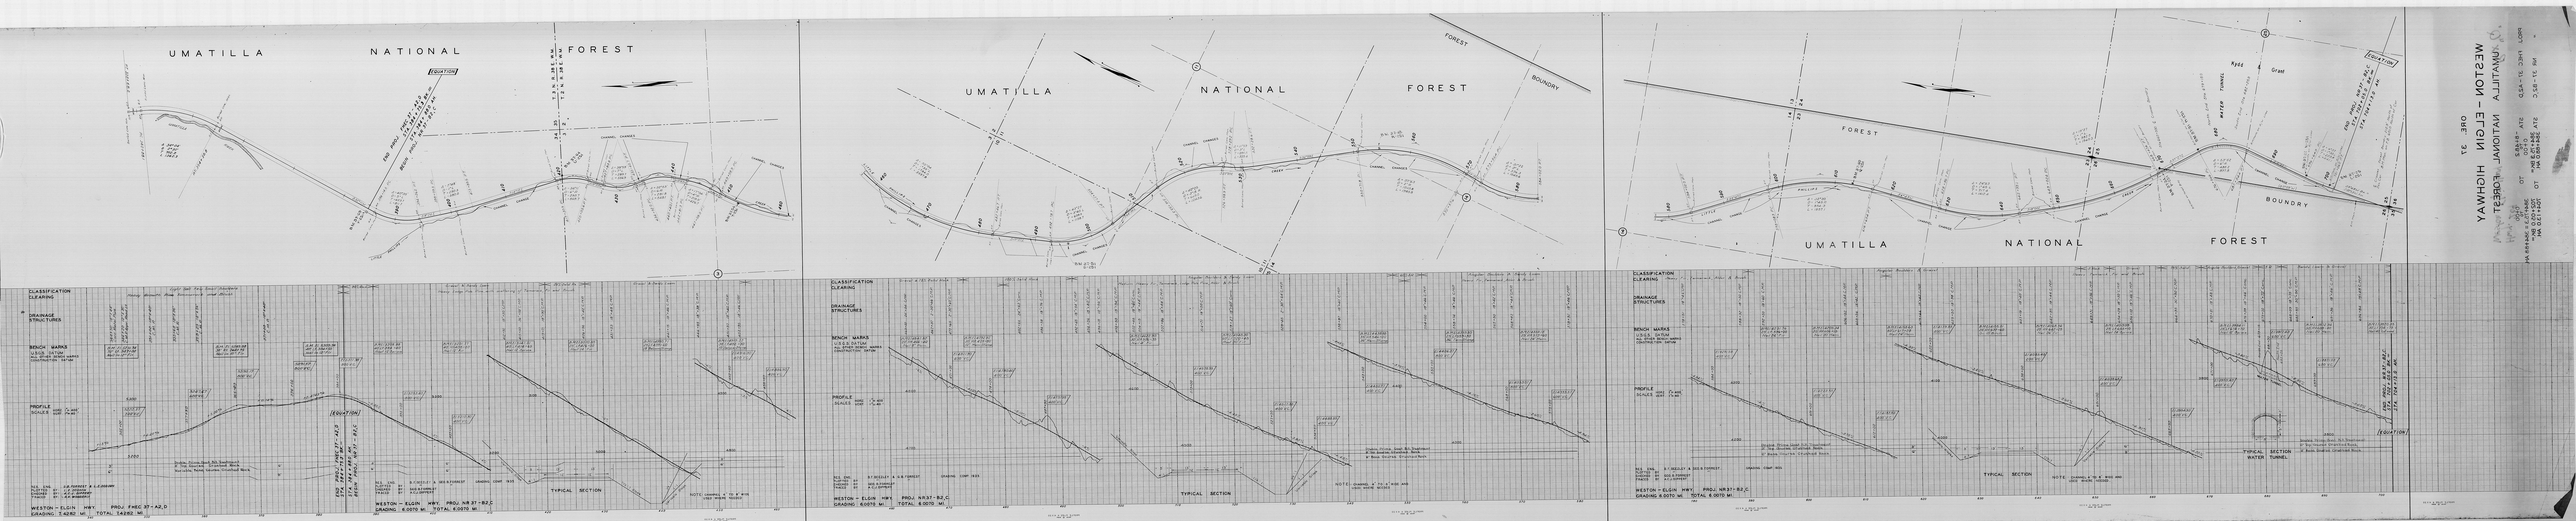
UMATILLA NATIONAL FOREST
EQUATION
CLASSIFICATION CLEARING
DRAINAGE STRUCTURES
BENCH MARKS
PROFILE
TYPICAL SECTION
WESTON - ELGIN HWY. PROJ. F-HEC 37-A2,D
GRADING 7.4282 MI. TOTAL 7.4282 MI.
WESTON - ELGIN HWY. PROJ. NR 37-B2,C
GRADING 6.0070 MI. TOTAL 6.0070 MI.
UMATILLA NATIONAL FOREST
BOUNDRY
Kyle Grant
TYPICAL SECTION WATER TUNNEL
WESTON - ELGIN HIGHWAY
UMATILLA NATIONAL FOREST
SHEET 37
