OREGON STATE HIGHWAY DEPARTMENT

LOCATED LINE

AS CONSTRUCTED

WESTON-MILTON SECTION


OREGON-WASH. HIGHWAY

UMATILLA COUNTY


SCALE: 1"=100' — OREGON GRID SYSTEM

A.J. WALLACE, LOC. ENGR. 1953
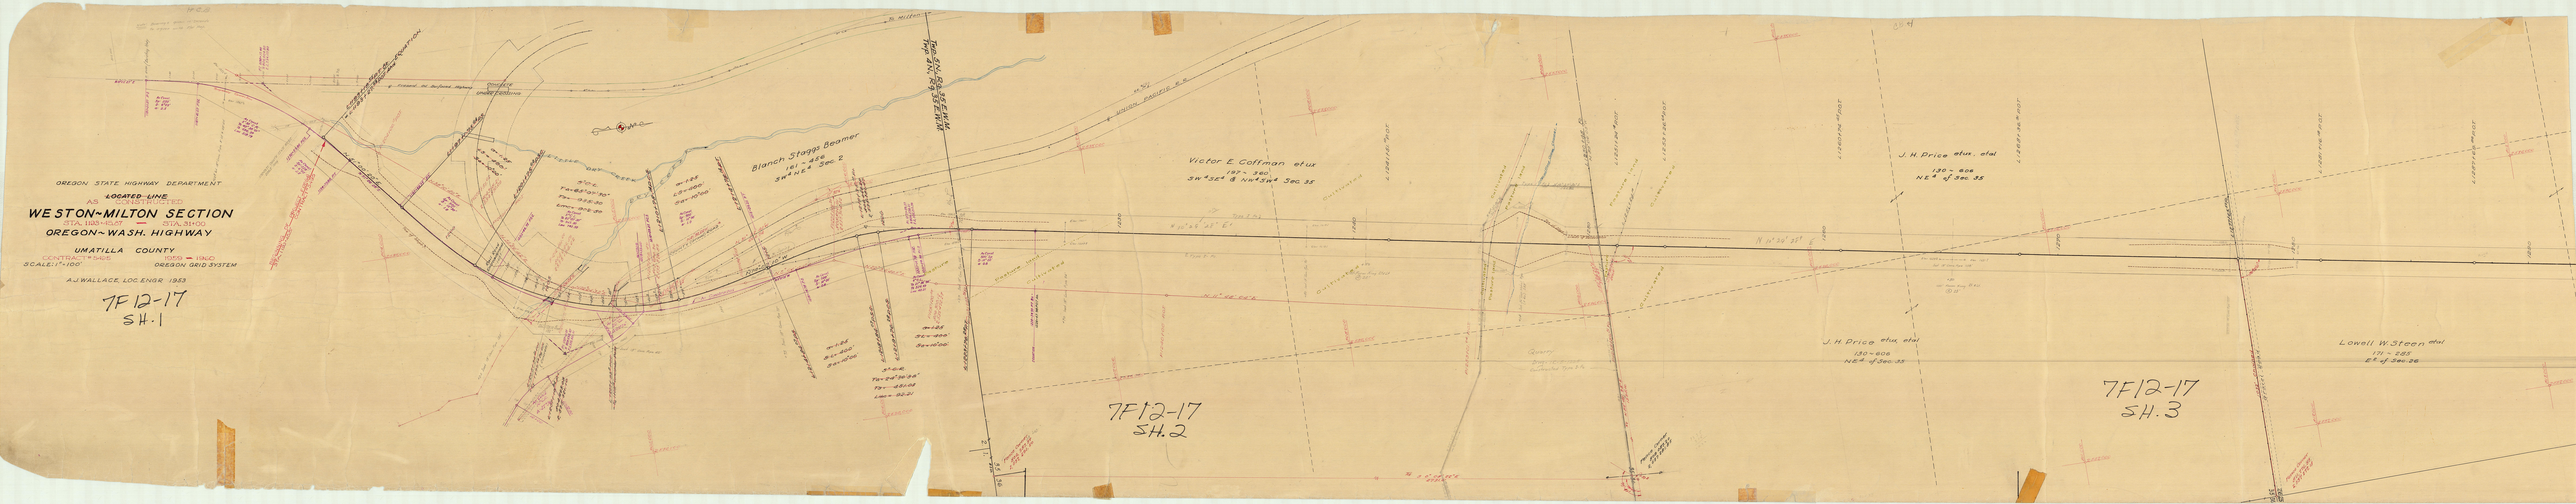
7F12-17
SH. 1