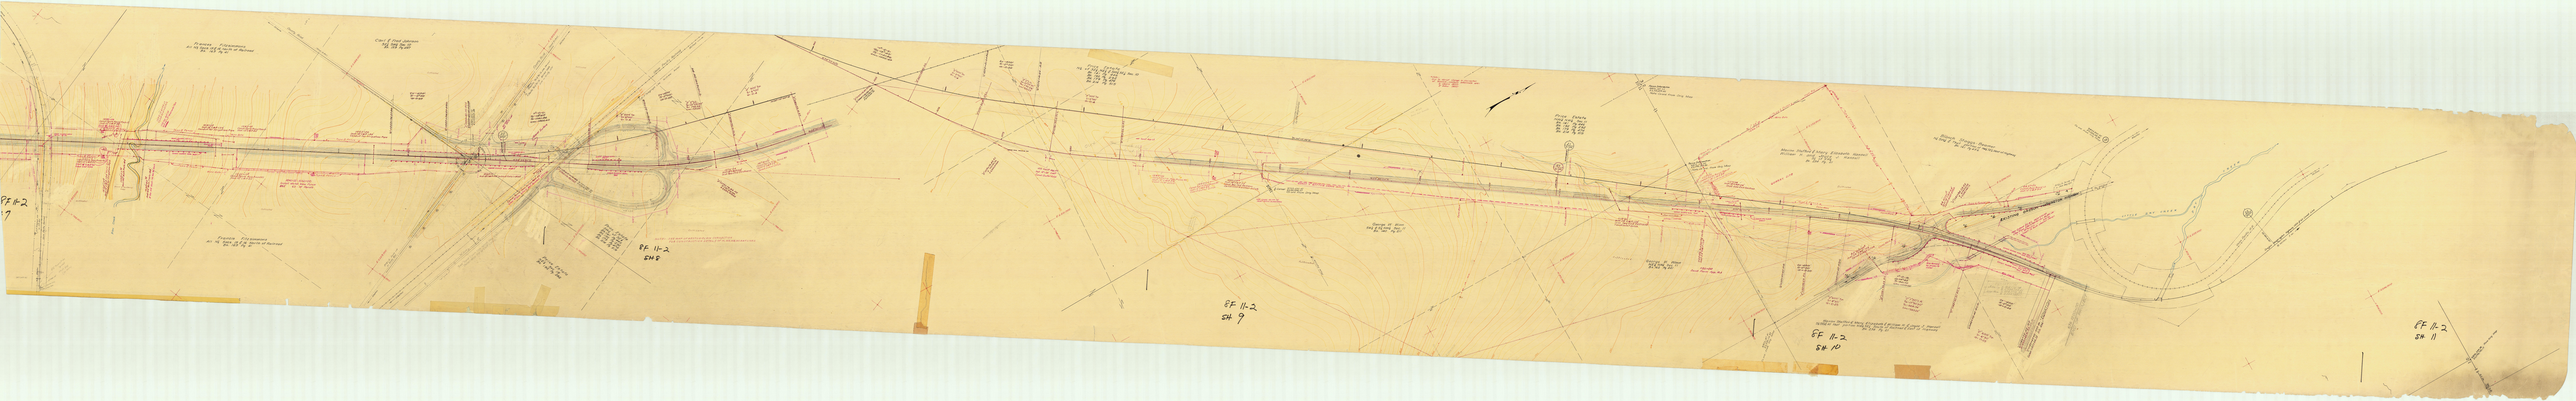
EF 11-2
SH 8
EF 11-2
SH 9
EF 11-2
SH 10
EF 11-2
SH 11