OREGON STATE HIGHWAY DEPARTMENT

THE OLD OREGON TRAIL

CONSTRUCTED LINE

DEADMANS PASS TO KAMELA

UMATILLA COUNTY
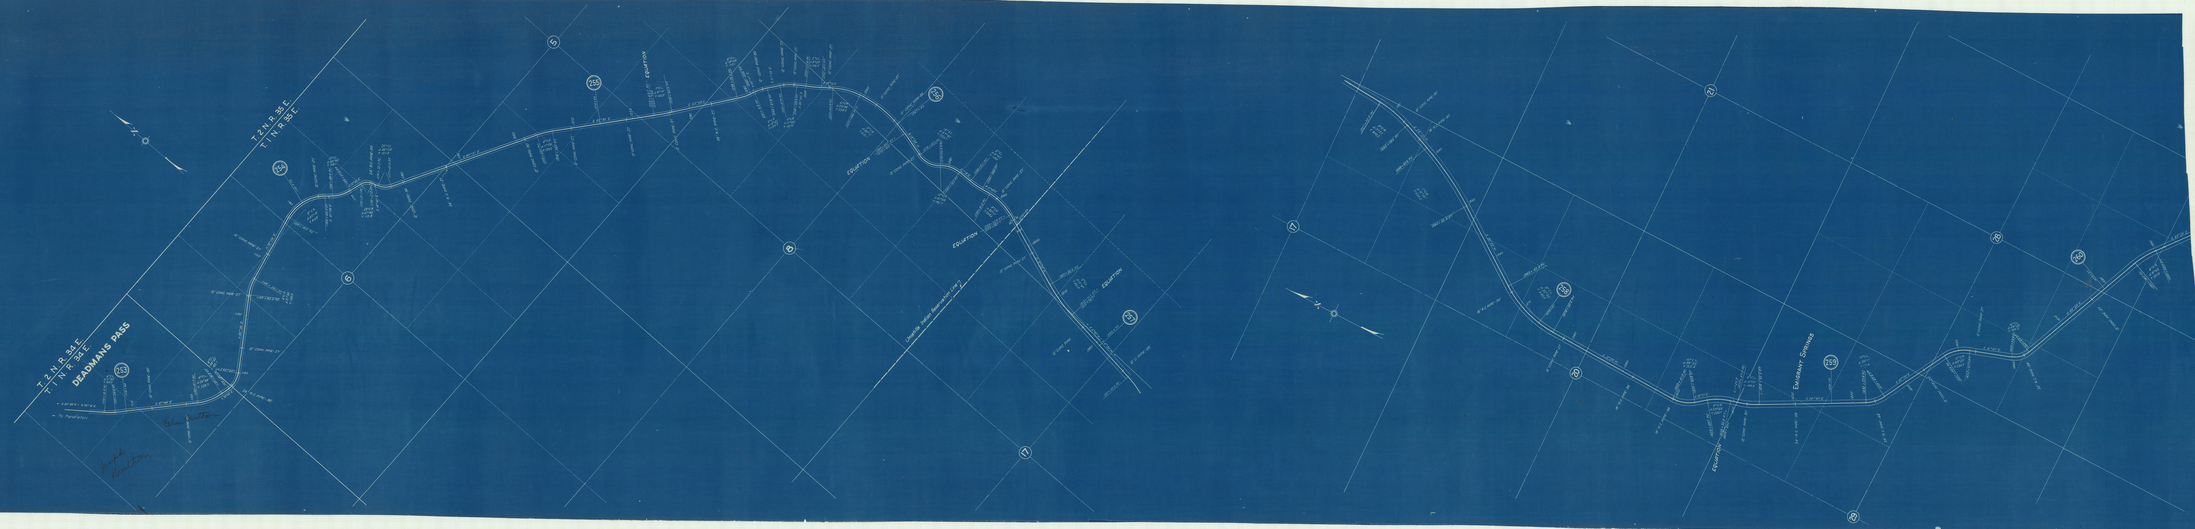
Scale 1 in = 400 ft. May 1936