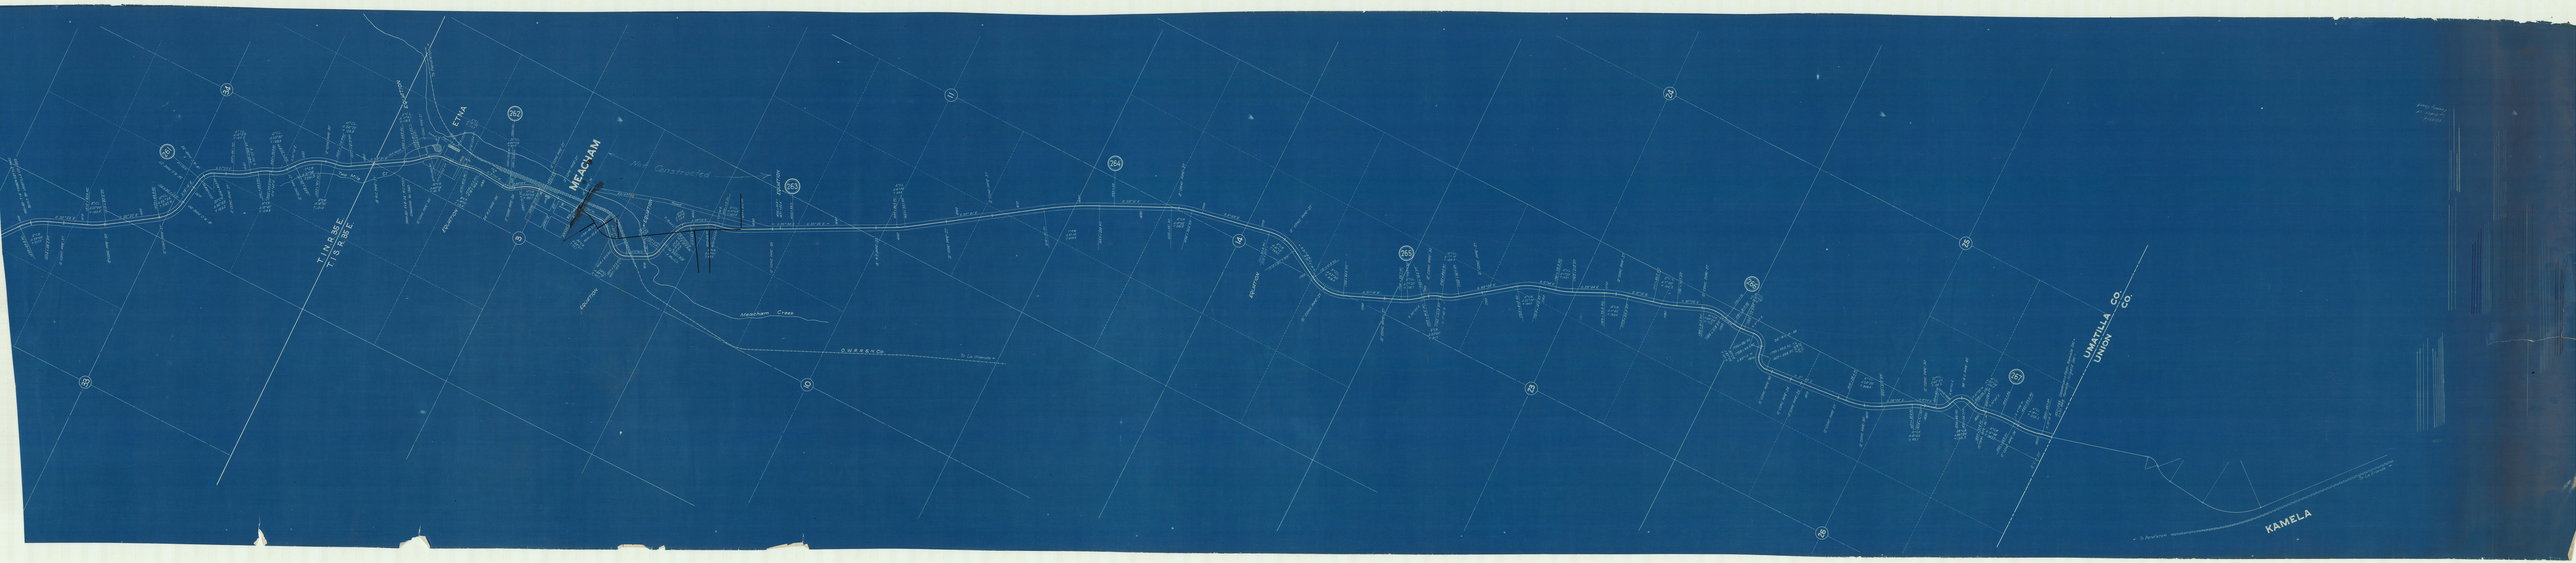
ETNA
MEACHAM
Not Constructed
Meacham Cree
UMATILLA CO.
UNION CO.
KAMELA