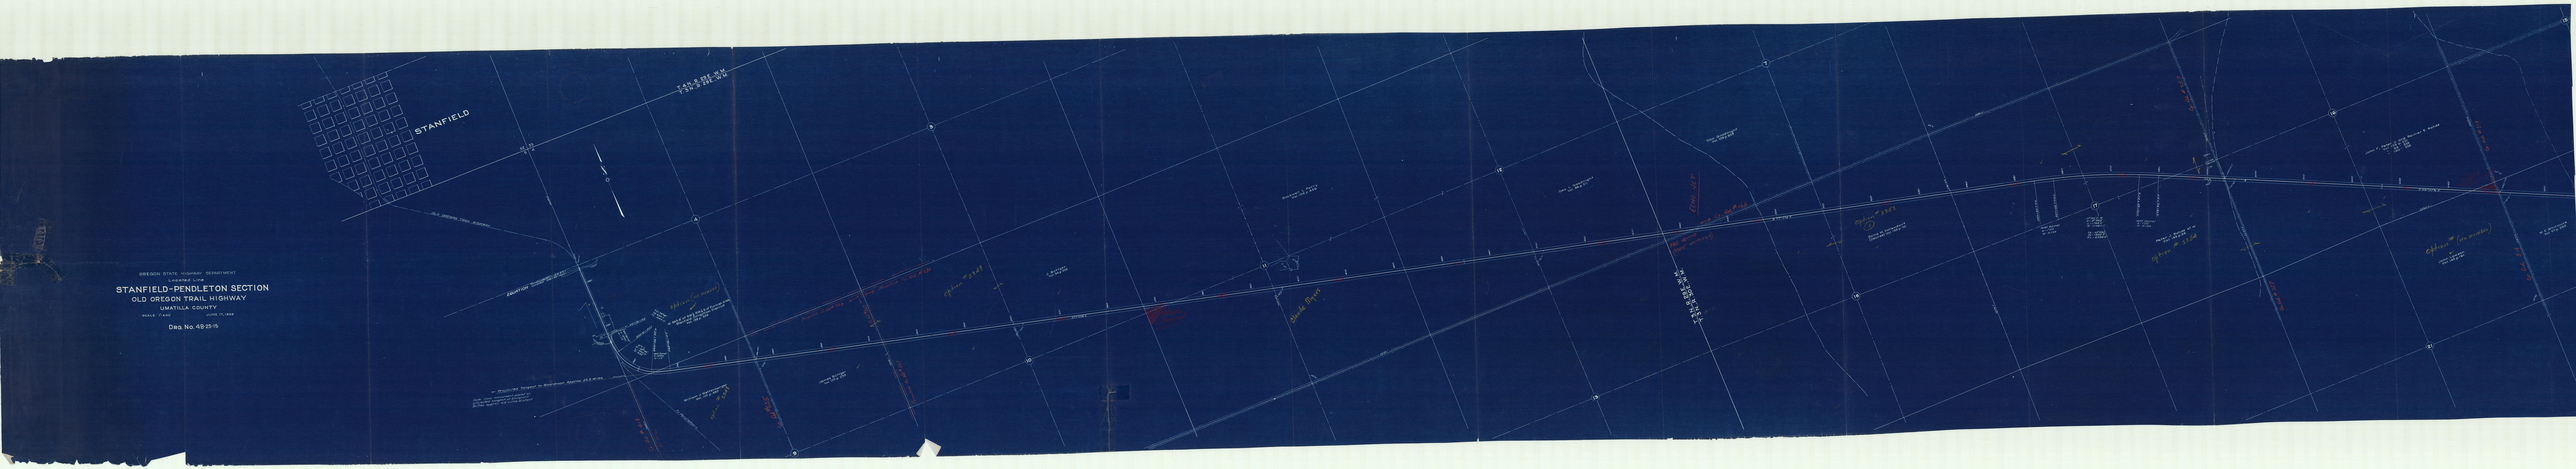
STANFIELD
OREGON STATE HIGHWAY DEPARTMENT
CONSTRUCTION
STANFIELD-PENDLETON SECTION
OLD OREGON TRAIL HIGHWAY
UMATILLA COUNTY
SCALE 1" = 400'
JUNE 11, 1928
Dwg. No. 48-25-15