


YOUNG'S ADDITION

Glen Rogers

MONTREE PENDLETON ADDITION

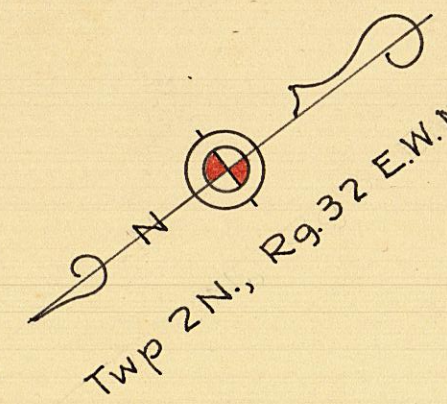

7F2-7
SH.4

2+16
Const. Appr. Lt. - Installed
12" x 63' Conc. Pipe

4+10
Const. Appr. Lt.
Installed 12" x 45' Conc.
Conc. Pipe

8+48.5
Const. Appr. Lt.
(Public Street)
Installed 12" x 66' Conc. Pipe

10+08
Const. Appr. Lt.
Installed 12" x 57'
Conc. Pipe

15+58
Const. Appr. Lt.
Installed 12" x 66'
Conc. Pipe

5+58
Const. Appr. Lt.
(Public Street)
Installed 12" x 66'
Conc. Pipe

10+00 to 14+50, Rt.
Constructed Connection to Old Road

16+00
Const. Appr. Rt. -
Installed 12" x 30' Conc. Pipe

19+81.6 to 21+80, Rt.
Const. Drain Ditch

18+41 to 21+25, Lt.
Const. Channel Change

+18 - Installed 36" x 129' Conc. Pipe

+69 - Installed 18" x 114' Conc. Pipe

27+50
Const. Appr. Lt.

L=250'
S=2°11.3'
a=0.7

28+00
Const. Appr. Rt.

37+30
Const. Appr. Rt.

44+59, Rt.
Installed 18" x 5' Conc. Pipe, Rt.

45+10
Const. Appr. Rt.

46+30
Const. Appr. Rt.

48+50, Rt.
Constructed Connection
to Old Highway

50+15
Appr. Rt.

F.A. & Mary Lyon
188-100
NE 1/4 NW 4 East of Hwy.
42+00, 44+50
Const. Drainage Ditch, Rt.

1°45' C.L.
TA=27°27'15"
Ts=512.15
Lmc=415.14

P 31+84.34
P 31+84.34
2+480.912.77
2+727.500.08.43
2+480.158.76
P 31+77.85
P 31+77.85
2+128.74
2+140.861.40

P 2+41+29.37
P 2+41+58.00
P 2+41+58.45
726.061.85
2+440.180.25

P 2+41+48.87
P 2+41+59.10
2+440.261.85

1st Left Hand 61+60

2+480.000
2+480.000
