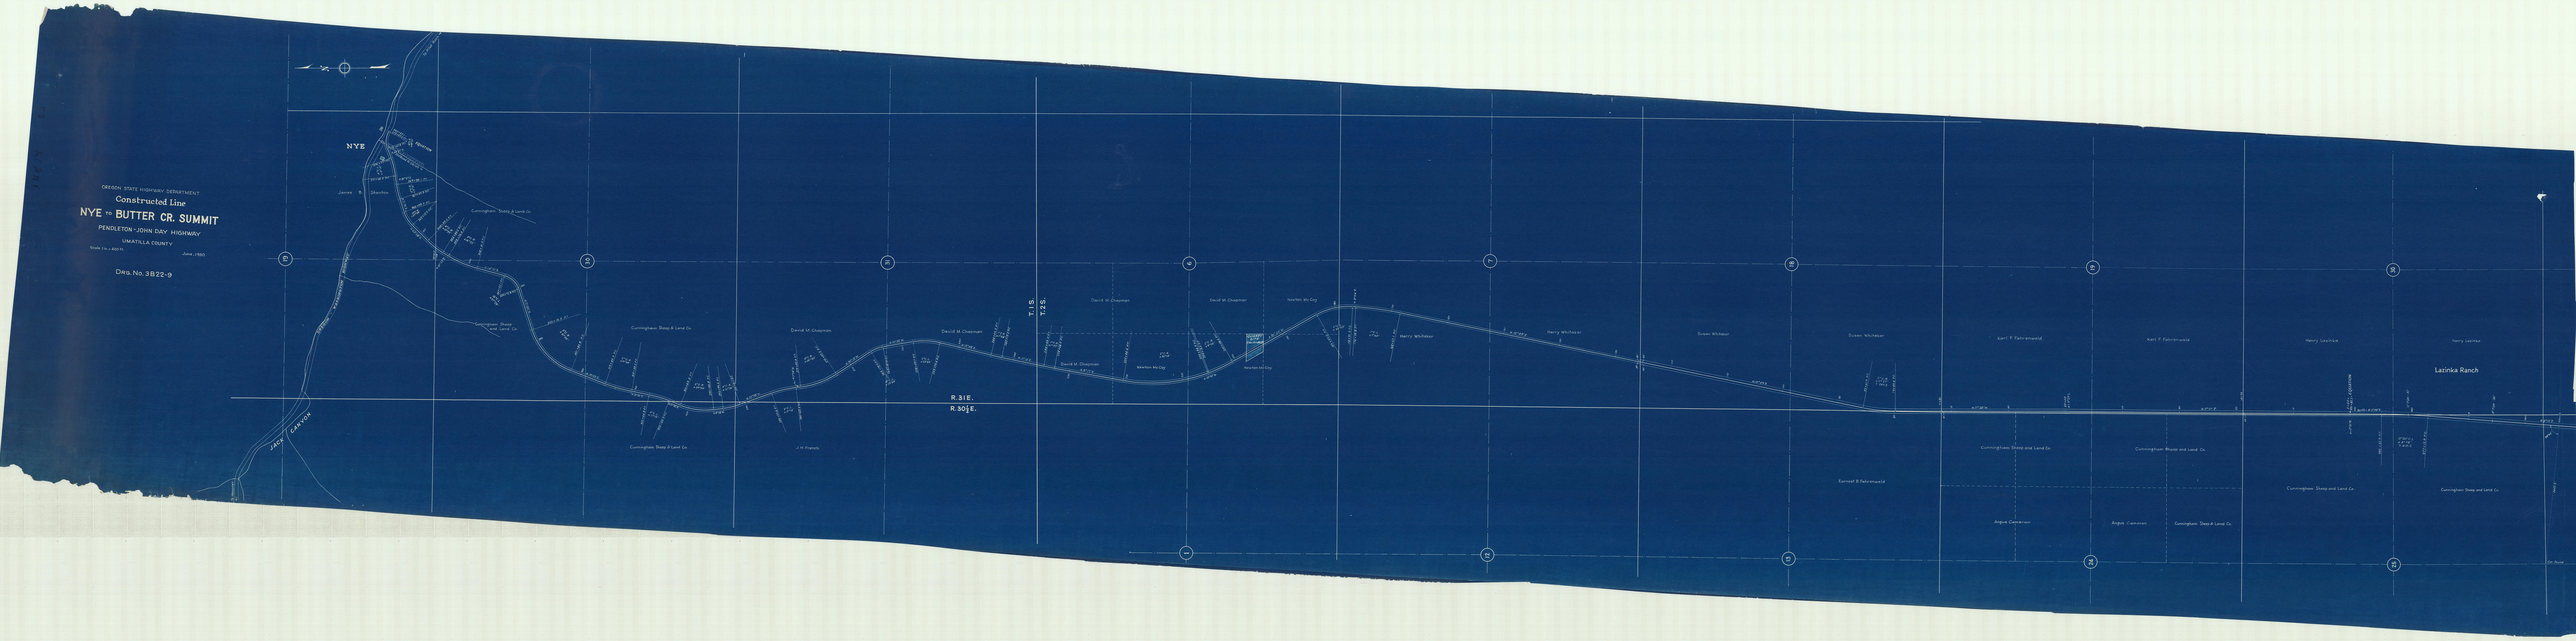
OREGON STATE HIGHWAY DEPARTMENT
Constructed Line
NYE to BUTTER CR. SUMMIT
PENDLETON-JOHN DAY HIGHWAY
UMATILLA COUNTY
June, 1960
Dwg. No. 3822-9
NYE
JACK CANYON
R.31E.
R.30E.
T.1S.
T.2S.
Lazinka Ranch
Cunningham Sheep & Land Co.
David M. Chapman
Newton Mc Coy
Henry Whitaker
Susan Whitaker
Karl F. Fahrenwald
Henry Lazinka
Earnest B Fahrenwald
Angus Cameron
J.H. Francis