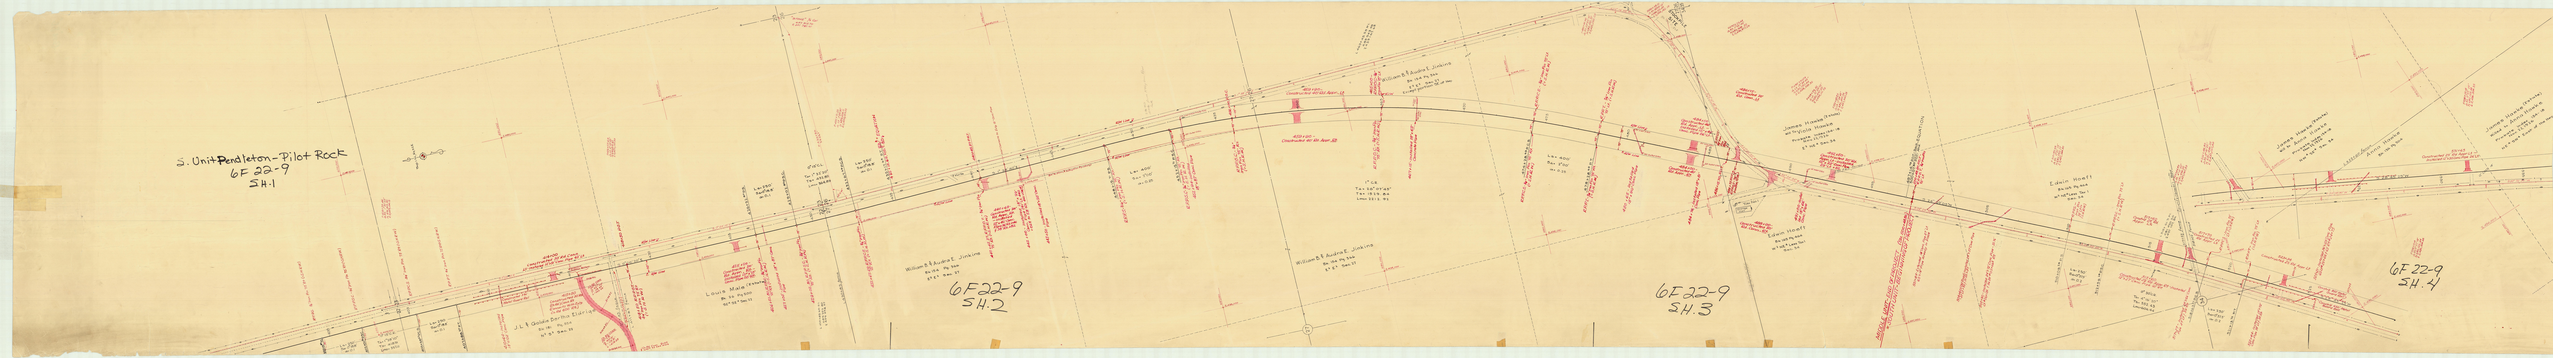
S. Unit Pendleton-Pilot Rock
6F 22-9
SH. 1
6F 22-9
SH. 2
6F 22-9
SH. 3
6F 22-9
SH. 4