OREGON STATE HIGHWAY DEPARTMENT

LOCATION MAP

PENDLETON-PILOT ROCK SECTION

MIDDLESOUTH UNIT (Sta. 2412.460 to 39.460)

PENDLETON - JOHN DAY HIGHWAY

UMATILLA COUNTY

SCALE: 1" = 100' OREGON GRID SYSTEM

J. T. BUNCH, RES. ENGR. SEPT. 1955

6F 22-8
SH. 1

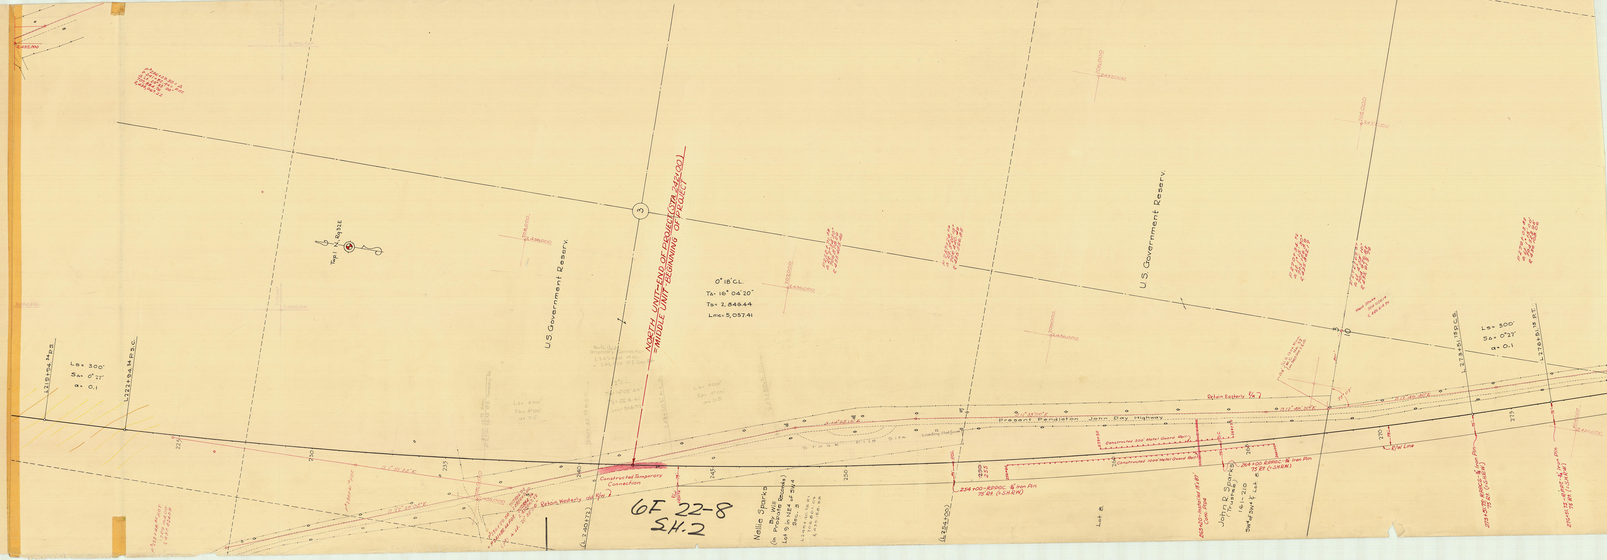

6F 22-8
SH. 2