OREGON STATE HIGHWAY DEPARTMENT

CONSTRUCTED LINE

PILOT ROCK TO PENDLETON

PENDLETON - JOHN DAY HIGHWAY

UMATILLA COUNTY

Scale 1 in = 800 ft. April 1926
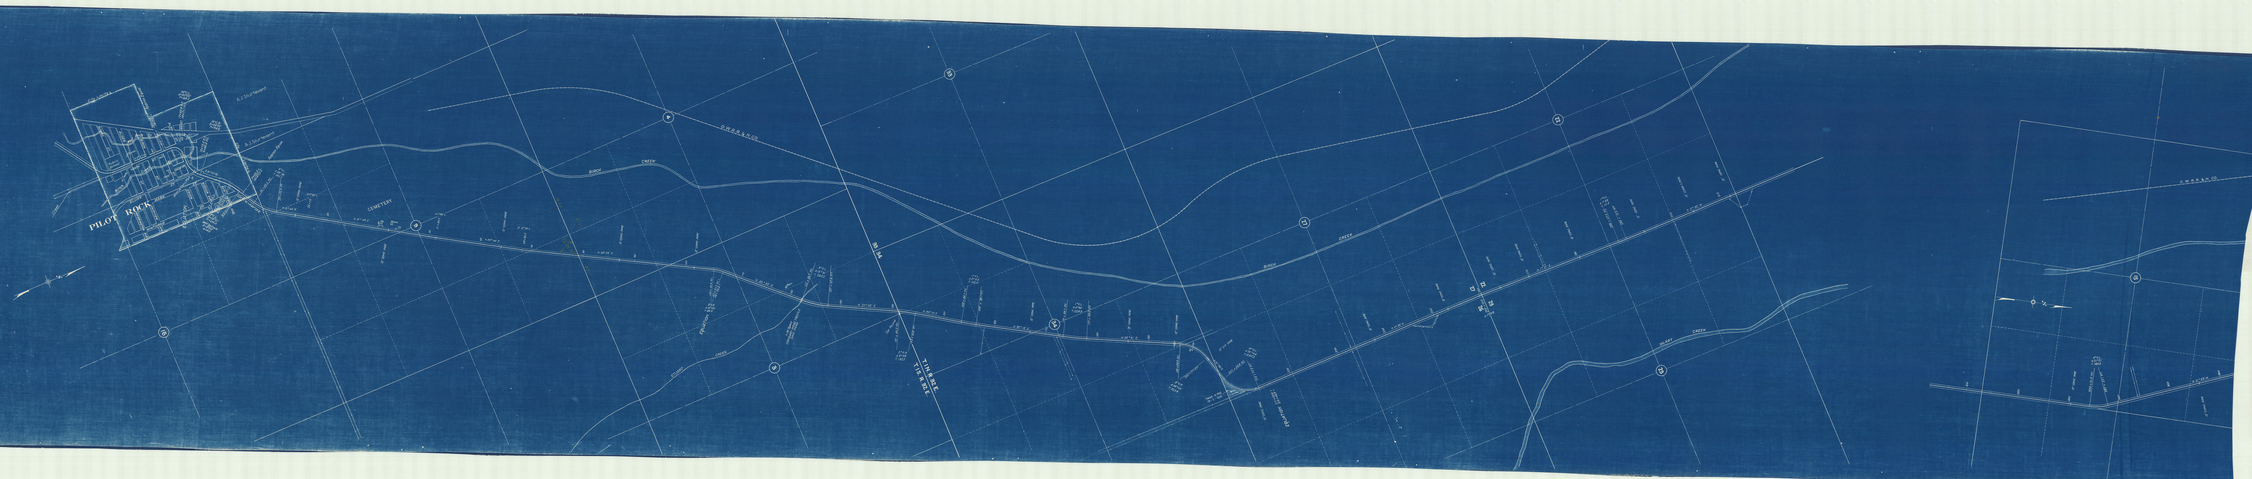
Date No. 3817-B