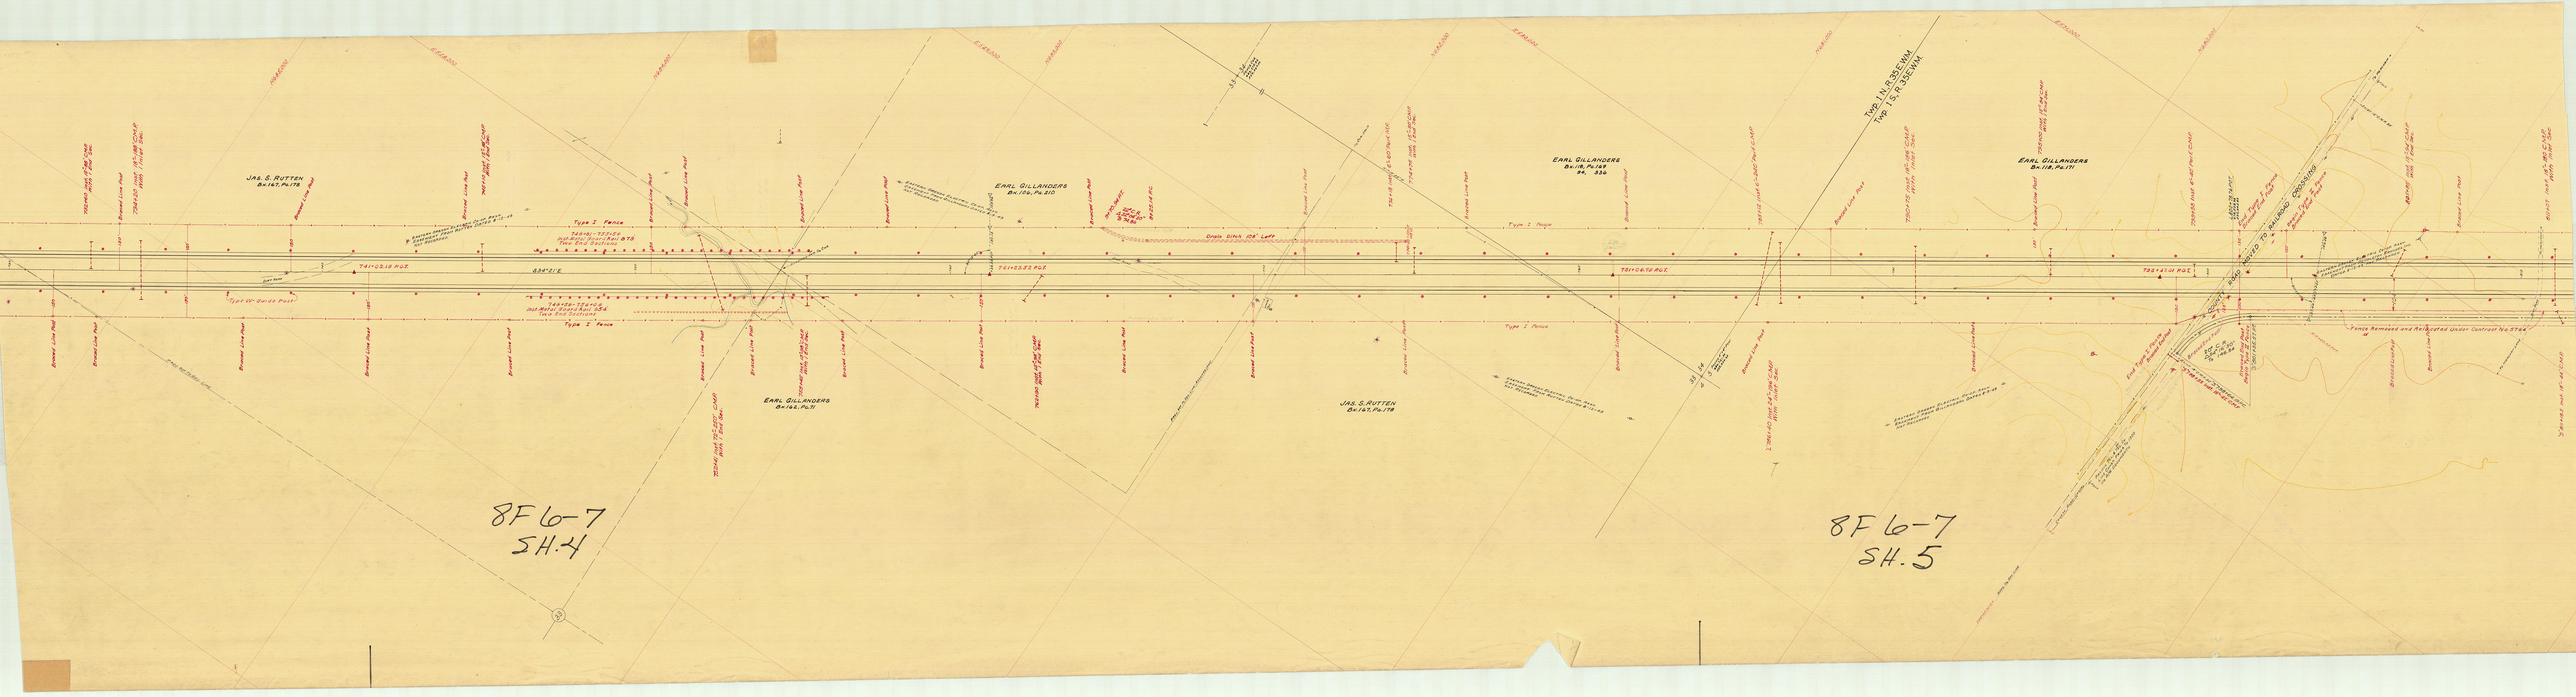
JAS. S. RUTTEN
Bk.167, Pg.178
EARL GILLANDERS
Bk.166, Pg.31
EARL GILLANDERS
Bk.166, Pg.210
Type I Fence
Grass Ditch 108' Left
JAS. S. RUTTEN
Bk.167, Pg.178
EARL GILLANDERS
Bk.118, Pg.169
Pg. 336
Type I Fence
TWP. 1 N. R. 3 E. W.M.
TWP. 1 S. R. 3 E. W.M.
EARL GILLANDERS
Bk.118, Pg.171
Fence Removed and Relocated Under Contract No. 7164
8F 6-7
SH. 4
8F 6-7
SH. 5