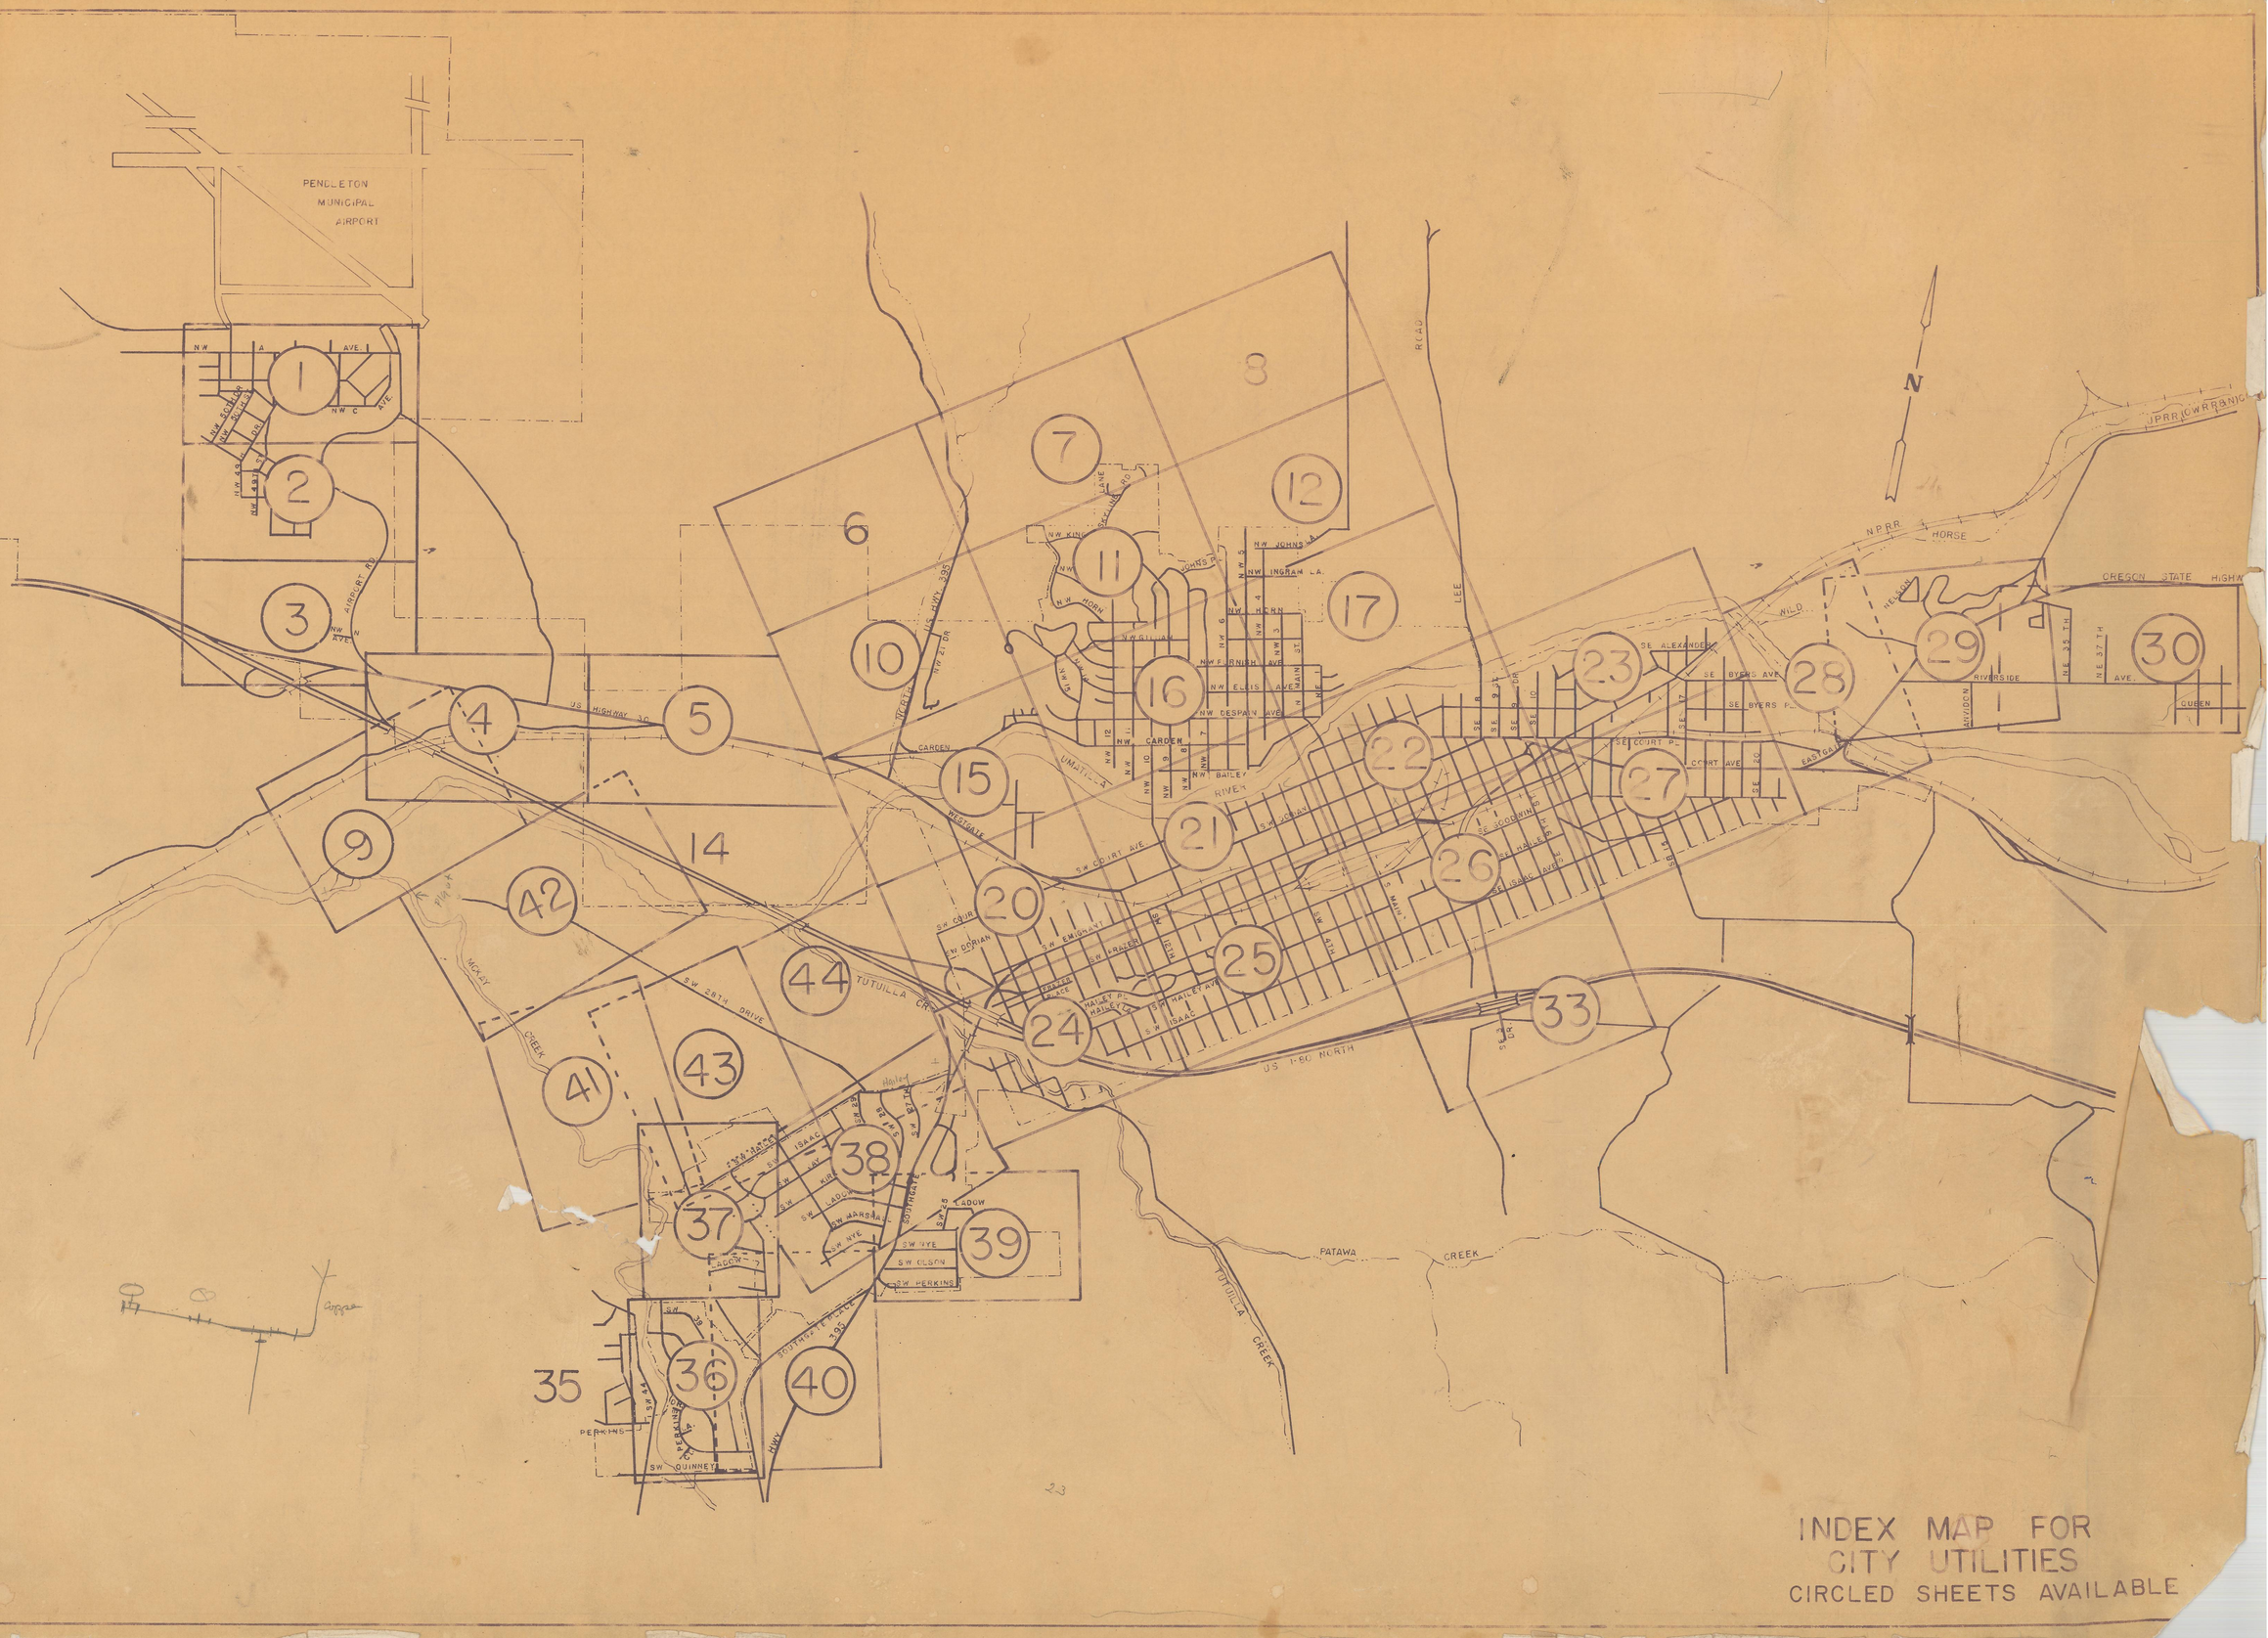


INDEX MAP FOR
CITY UTILITIES
CIRCLED SHEETS AVAILABLE

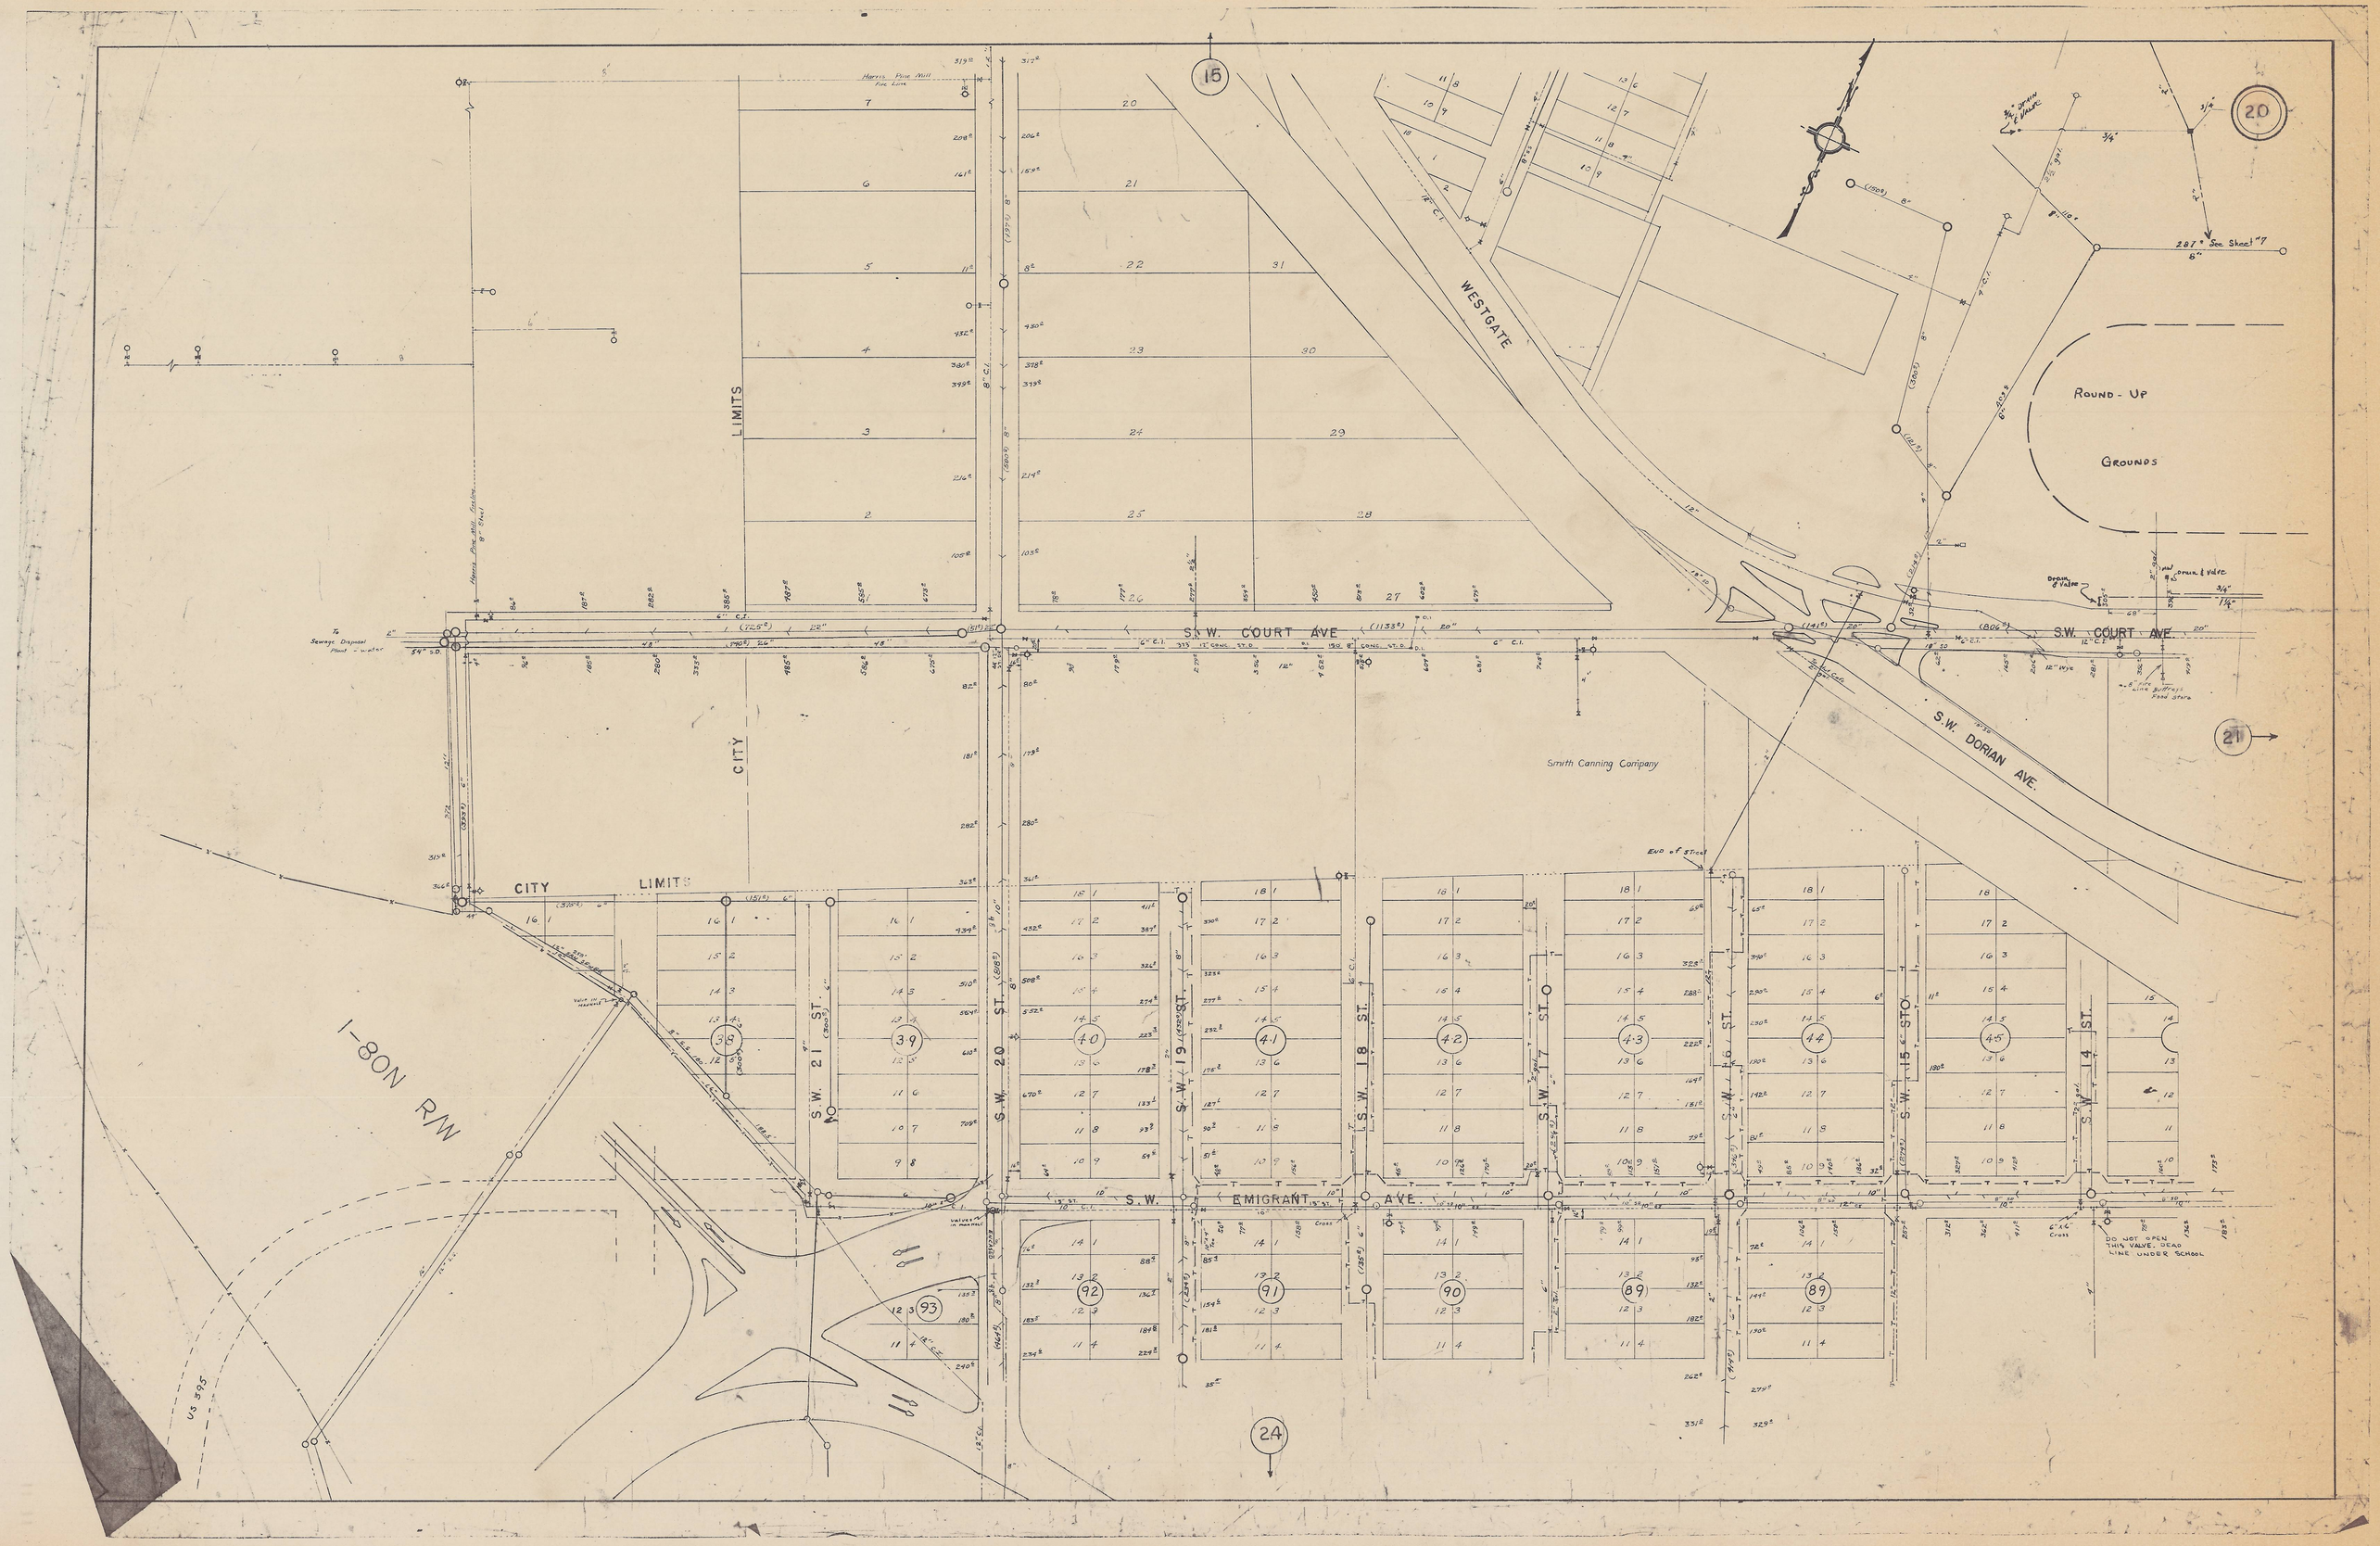

15
20
21
24
WESTGATE
ROUND-UP
GROUNDS
S.W. COURT AVE
S.W. DORIAN AVE.
S.W. EMIGRANT AVE.
CITY LIMITS
S.W. 21 ST.
S.W. 20 ST.
S.W. 19 ST.
S.W. 18 ST.
S.W. 17 ST.
S.W. 16 ST.
S.W. 15 ST.
S.W. 14 ST.
I-80N R/W
US 395
Smith Canning Company
DO NOT OPEN THIS VALVE. DEAD LINE UNDER SCHOOL