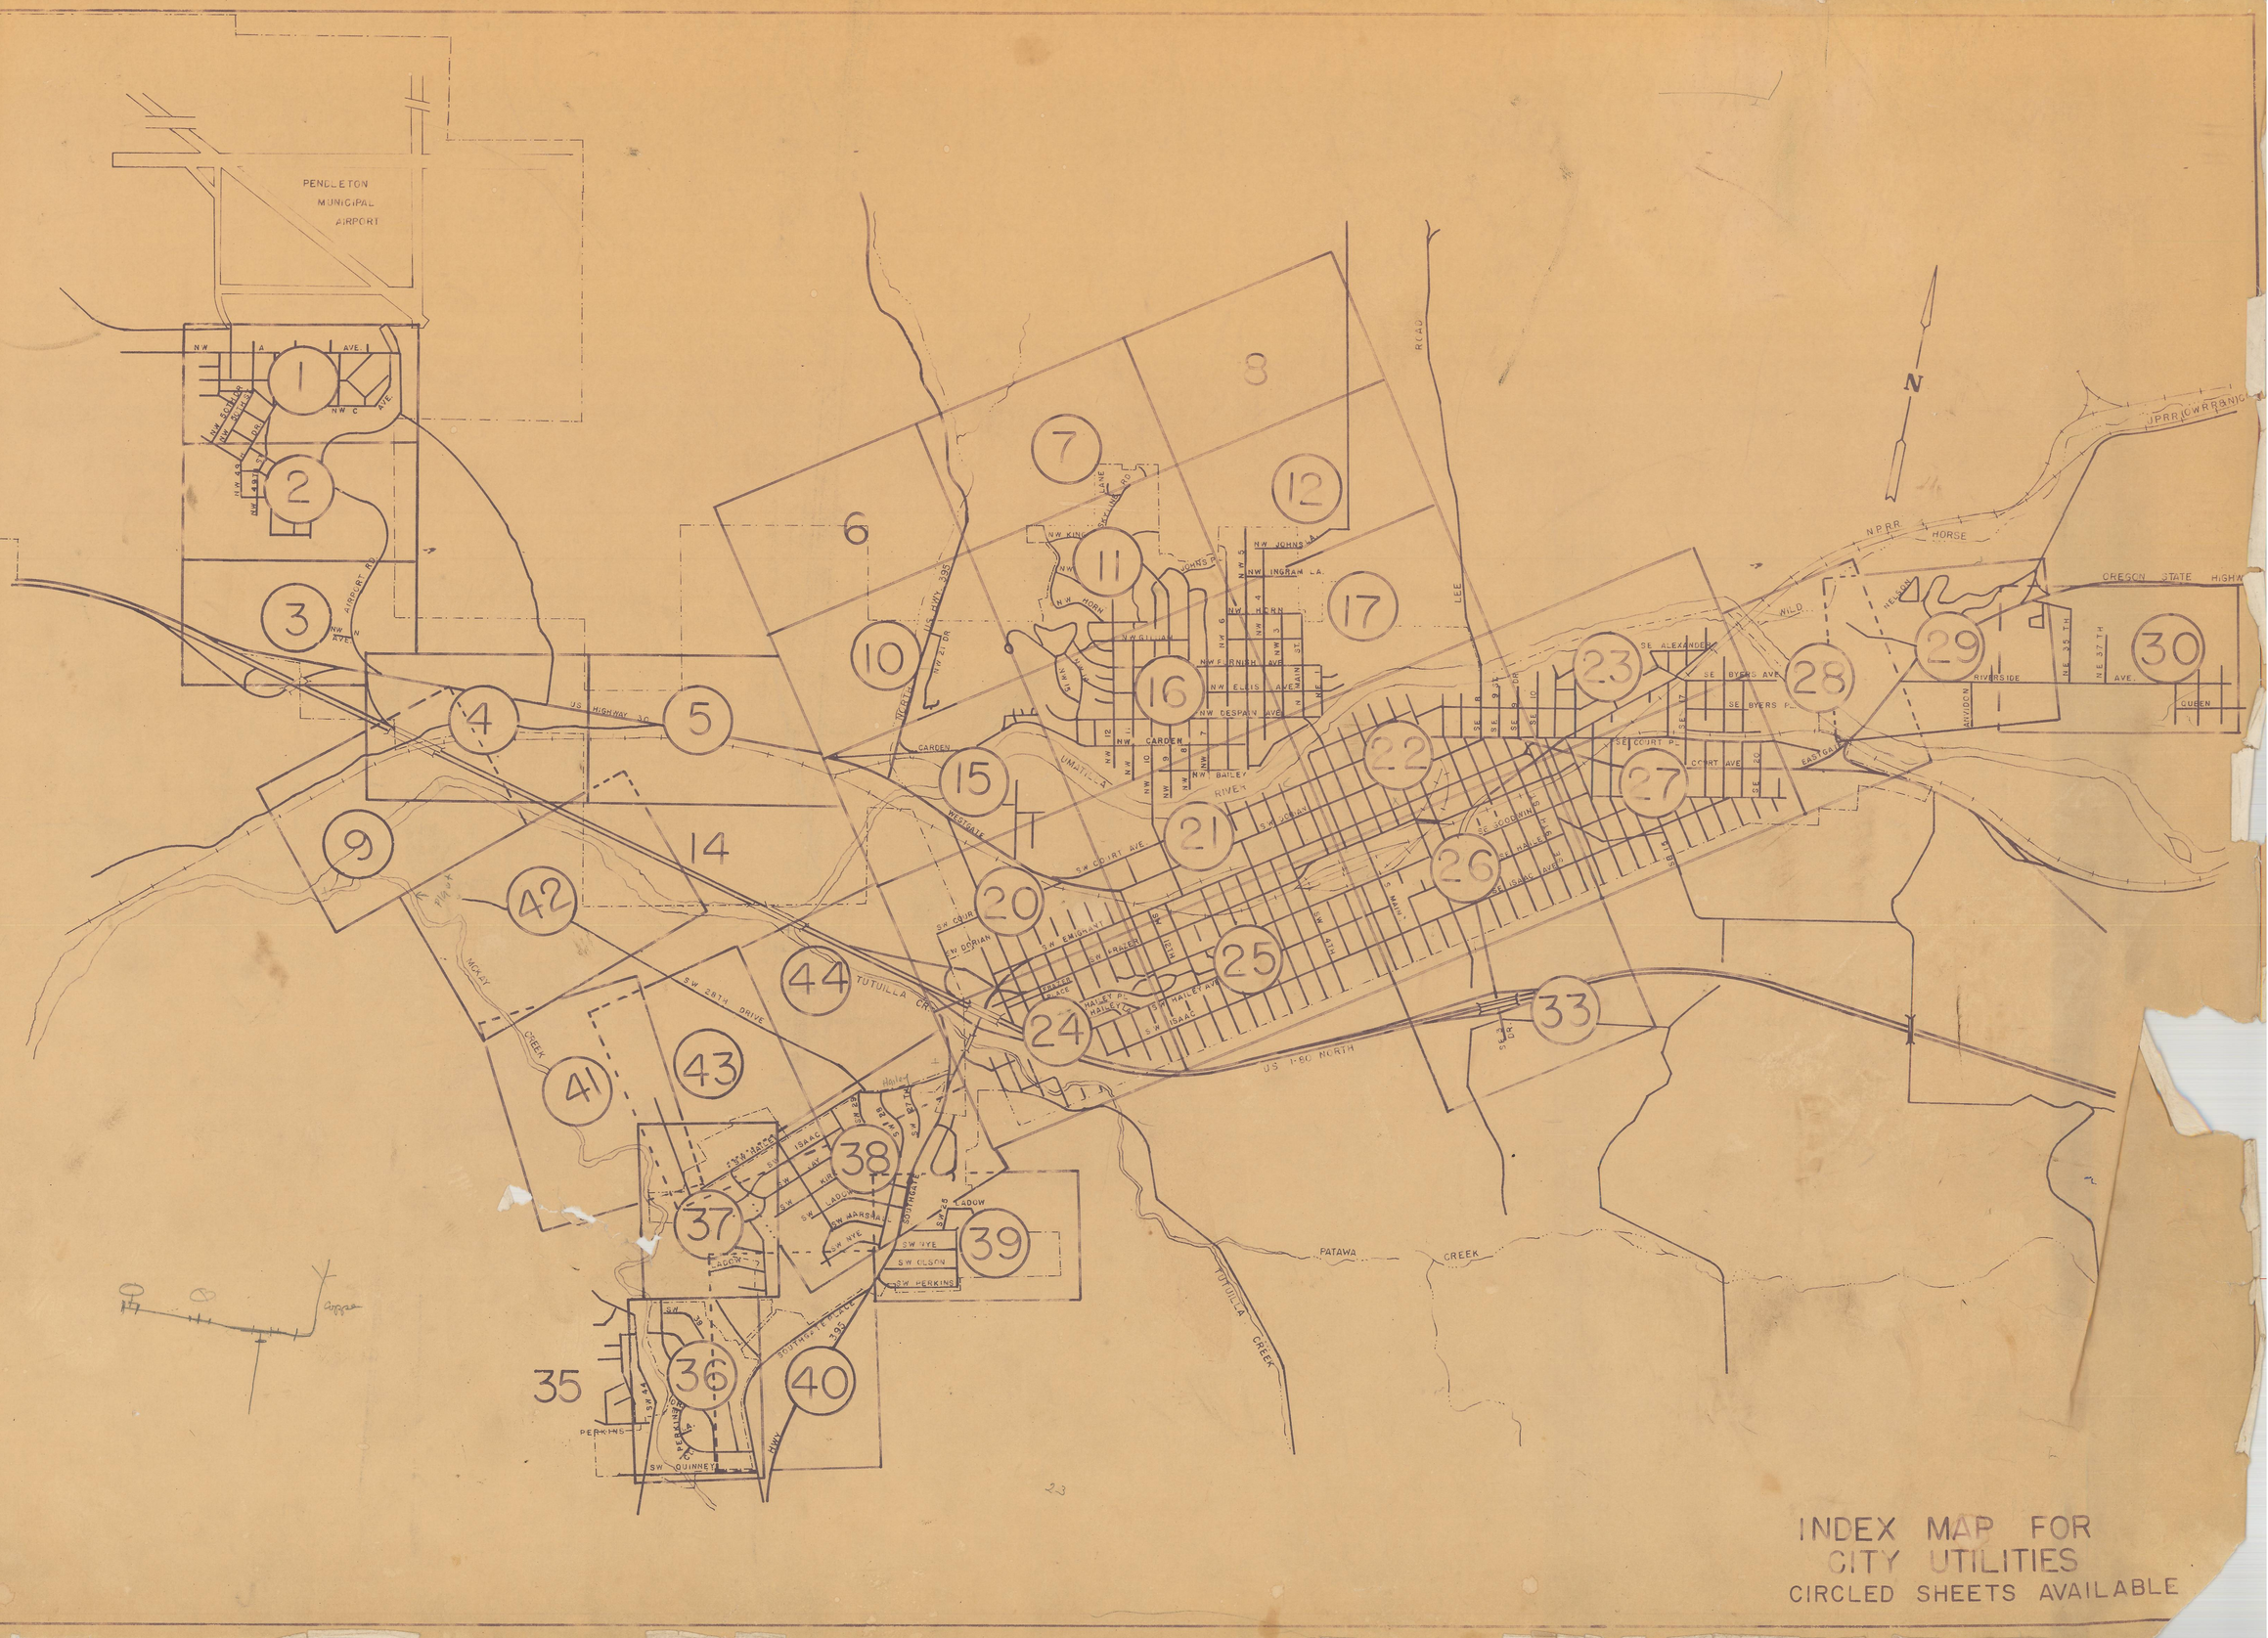

INDEX MAP FOR
CITY UTILITIES
CIRCLED SHEETS AVAILABLE

Academy

Hospital

S. E. 12 DRIVE

S. E. 13 ST.

S. E. 14 ST.

S. E. 15 ST.

S. E. 16 ST.

S. E. 17 ST.

S. E. 18 ST.

S. E. 19 ST.

S. E. 20 ST.

S. E. 21 ST.

S. E. 19 DR.

S. E. COURT

S. E. PLACE

BYERS PLACE

S. E. HAILEY AVE.

S. E. ISAAC AVE.

S. E. GOODWIN AVE.

2 POP OF PIPE AT METER

8" C.I.

4" C.I.

6" C.I.

2" GAL.

4" GAL.

6" AC

8" AC

4" C.I.

6" C.I.

8" C.I.

WATER & GAS MAINS LOCATED BY GARNER'S