


INDEX MAP FOR  
CITY UTILITIES  
CIRCLED SHEETS AVAILABLE

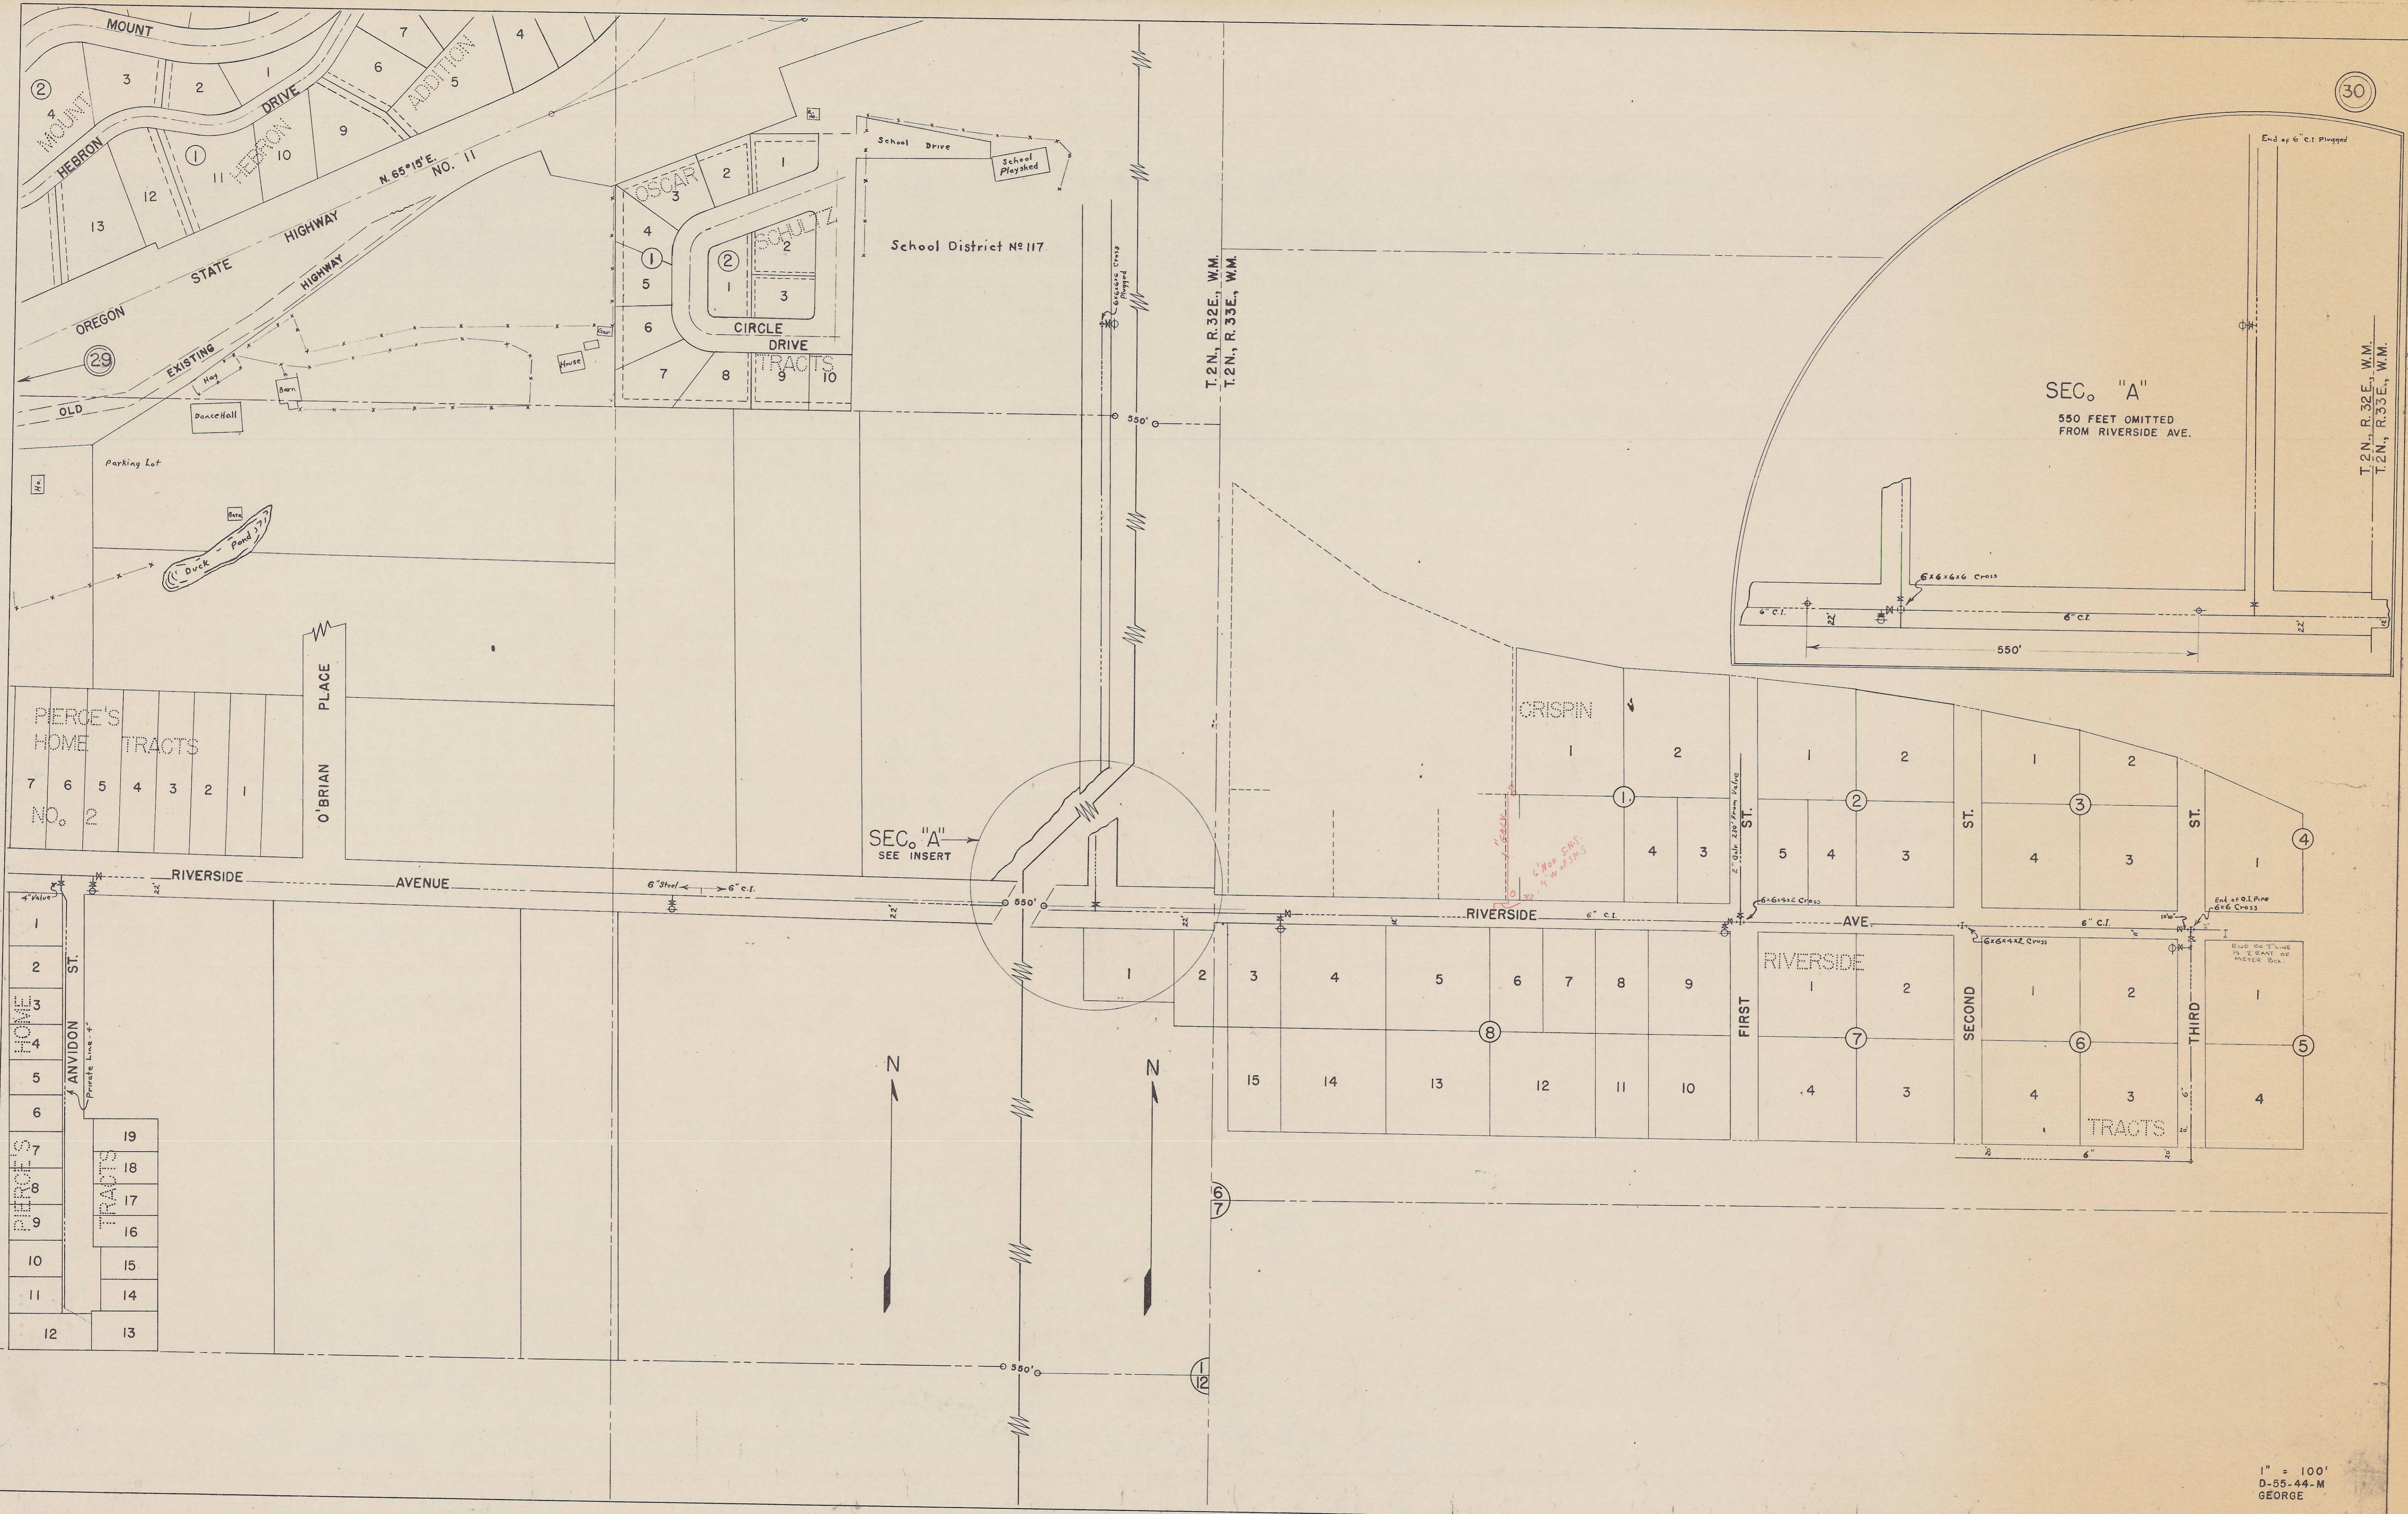

T. 2N., R. 32E., W.M.  
T. 2N., R. 33E., W.M.

T. 2N., R. 32E., W.M.  
T. 2N., R. 33E., W.M.

SEC. "A"  
SEE INSERT

SEC. "A"  
550 FEET OMITTED  
FROM RIVERSIDE AVE.