


INDEX MAP FOR
CITY UTILITIES
CIRCLED SHEETS AVAILABLE

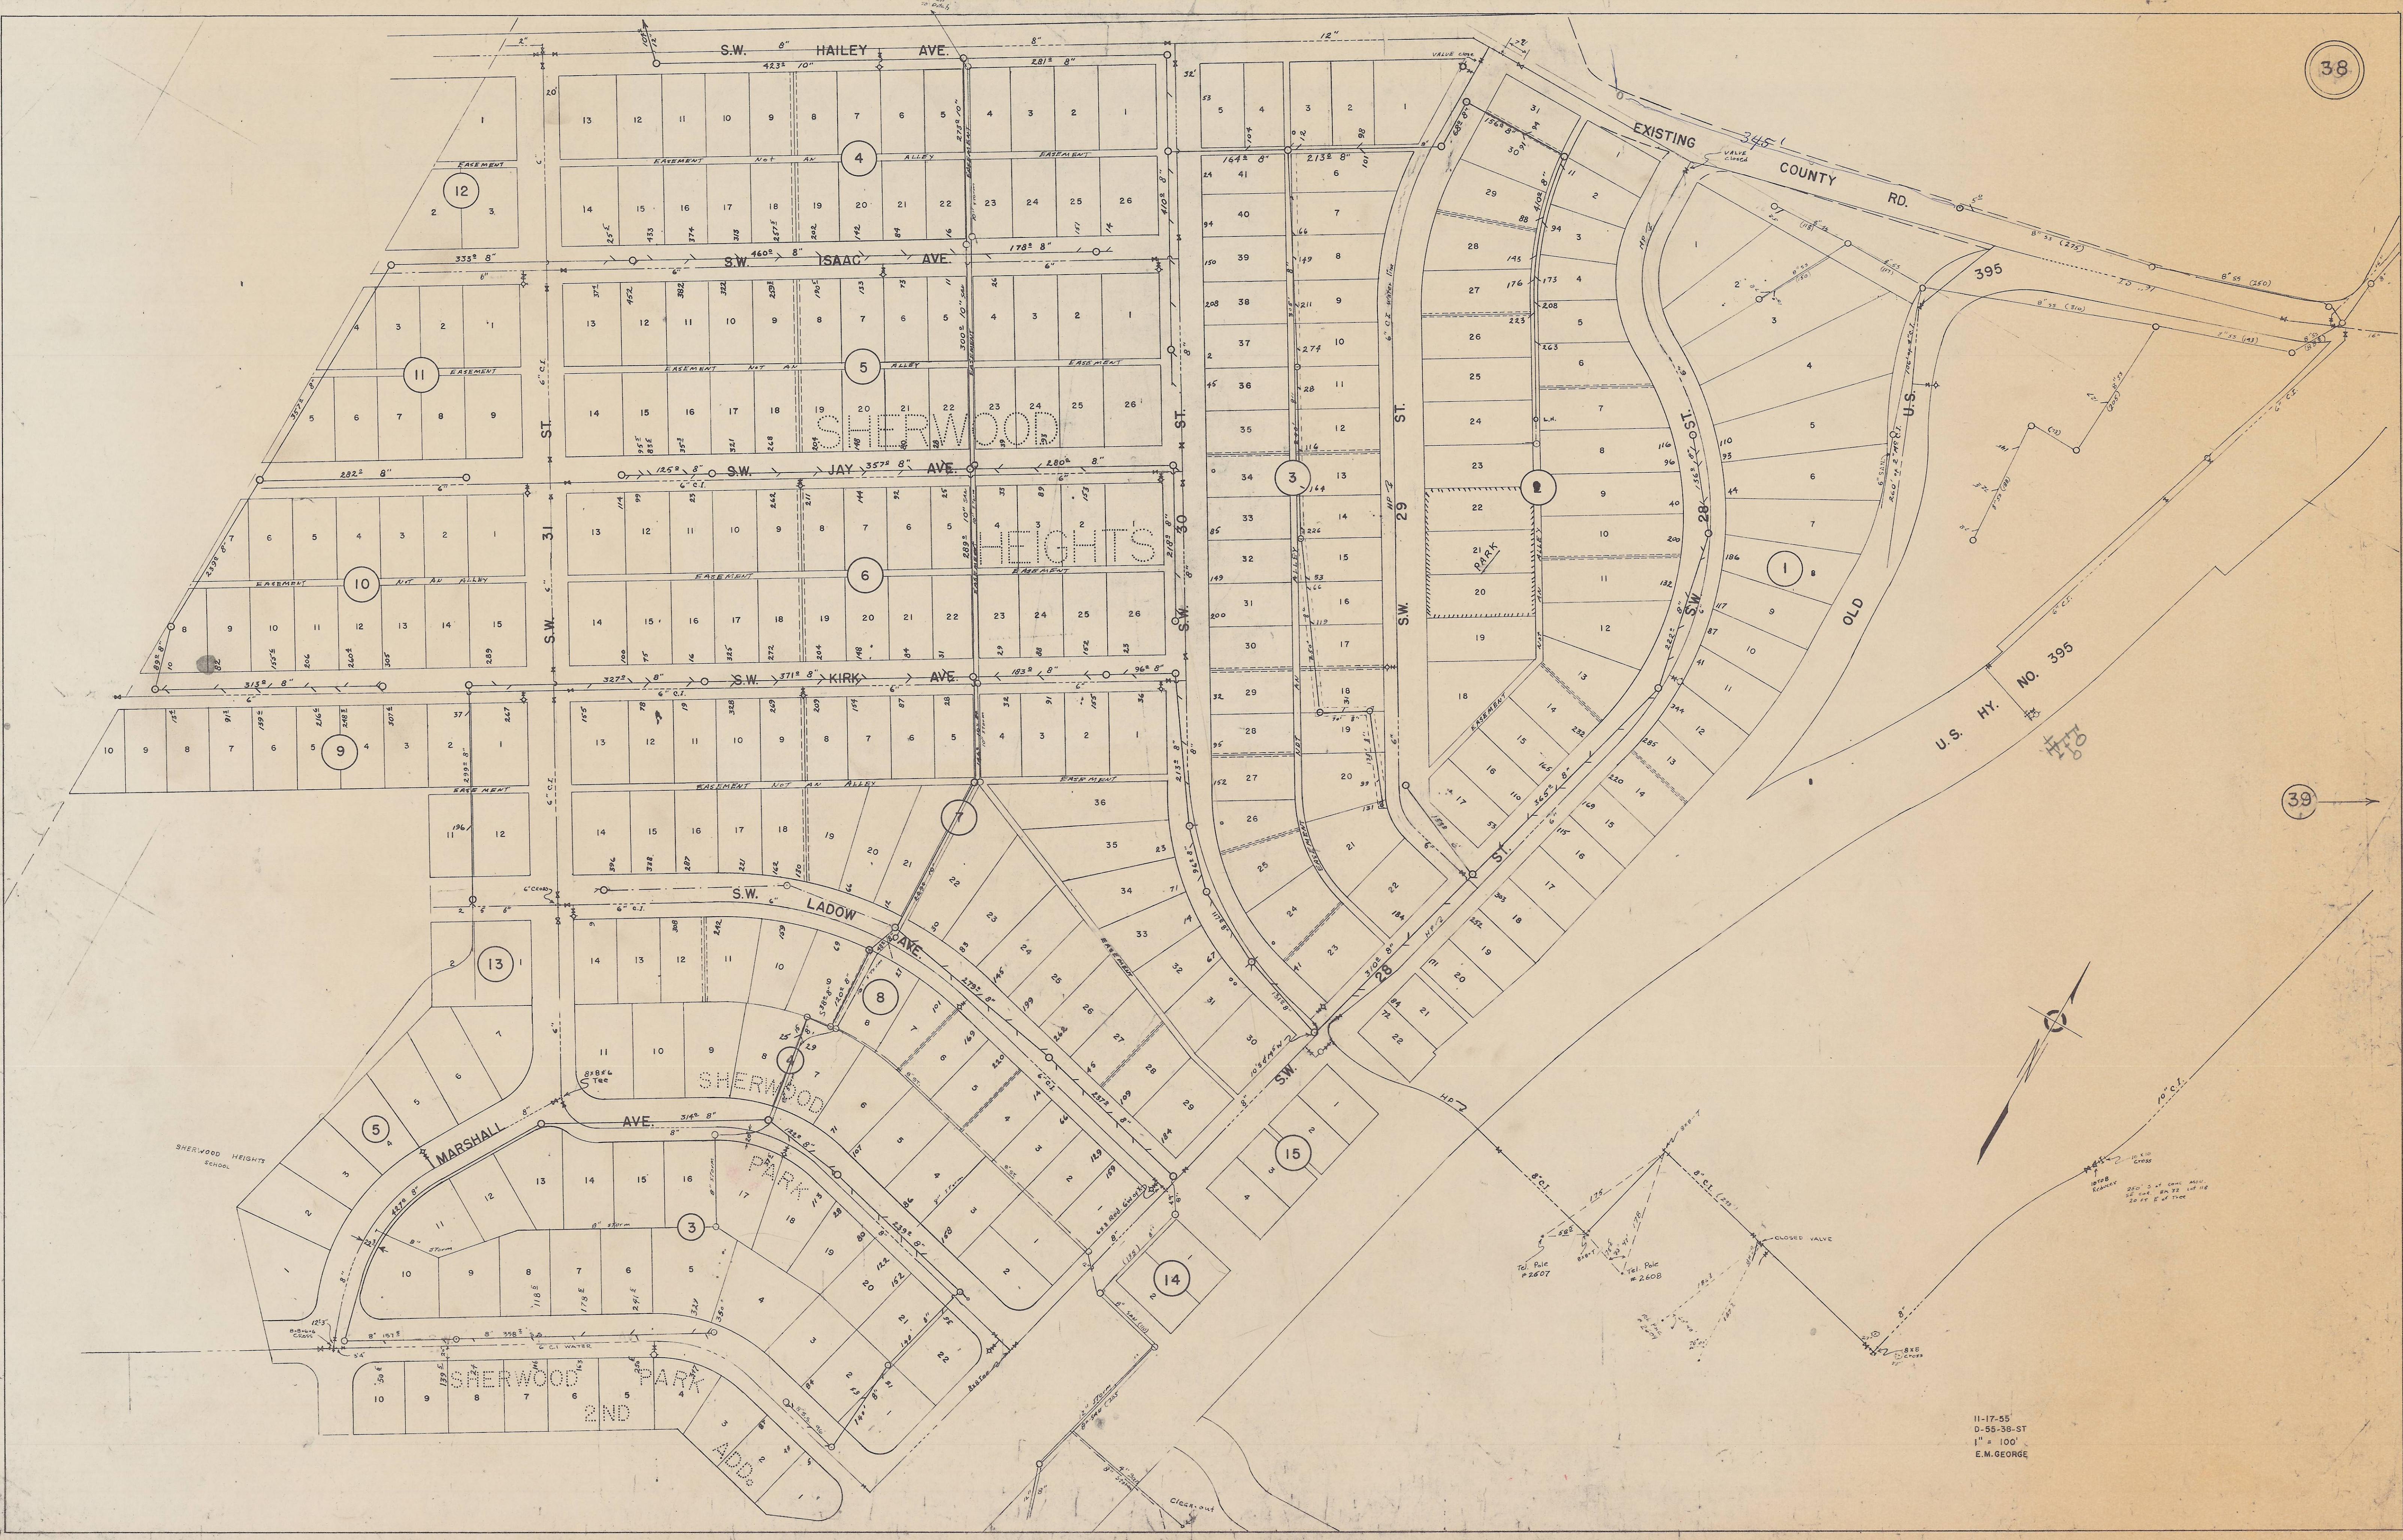

11-17-55
 D-55-38-ST
 1" = 100'
 E.M. GEORGE