


NOTE FOR LOCATION & ACO OF McNARY LOOP SEE DWG 154535 DTM-D

SECS 9, 16, 8 21 T5N R28E W M UMATILLA COUNTY, OREGON

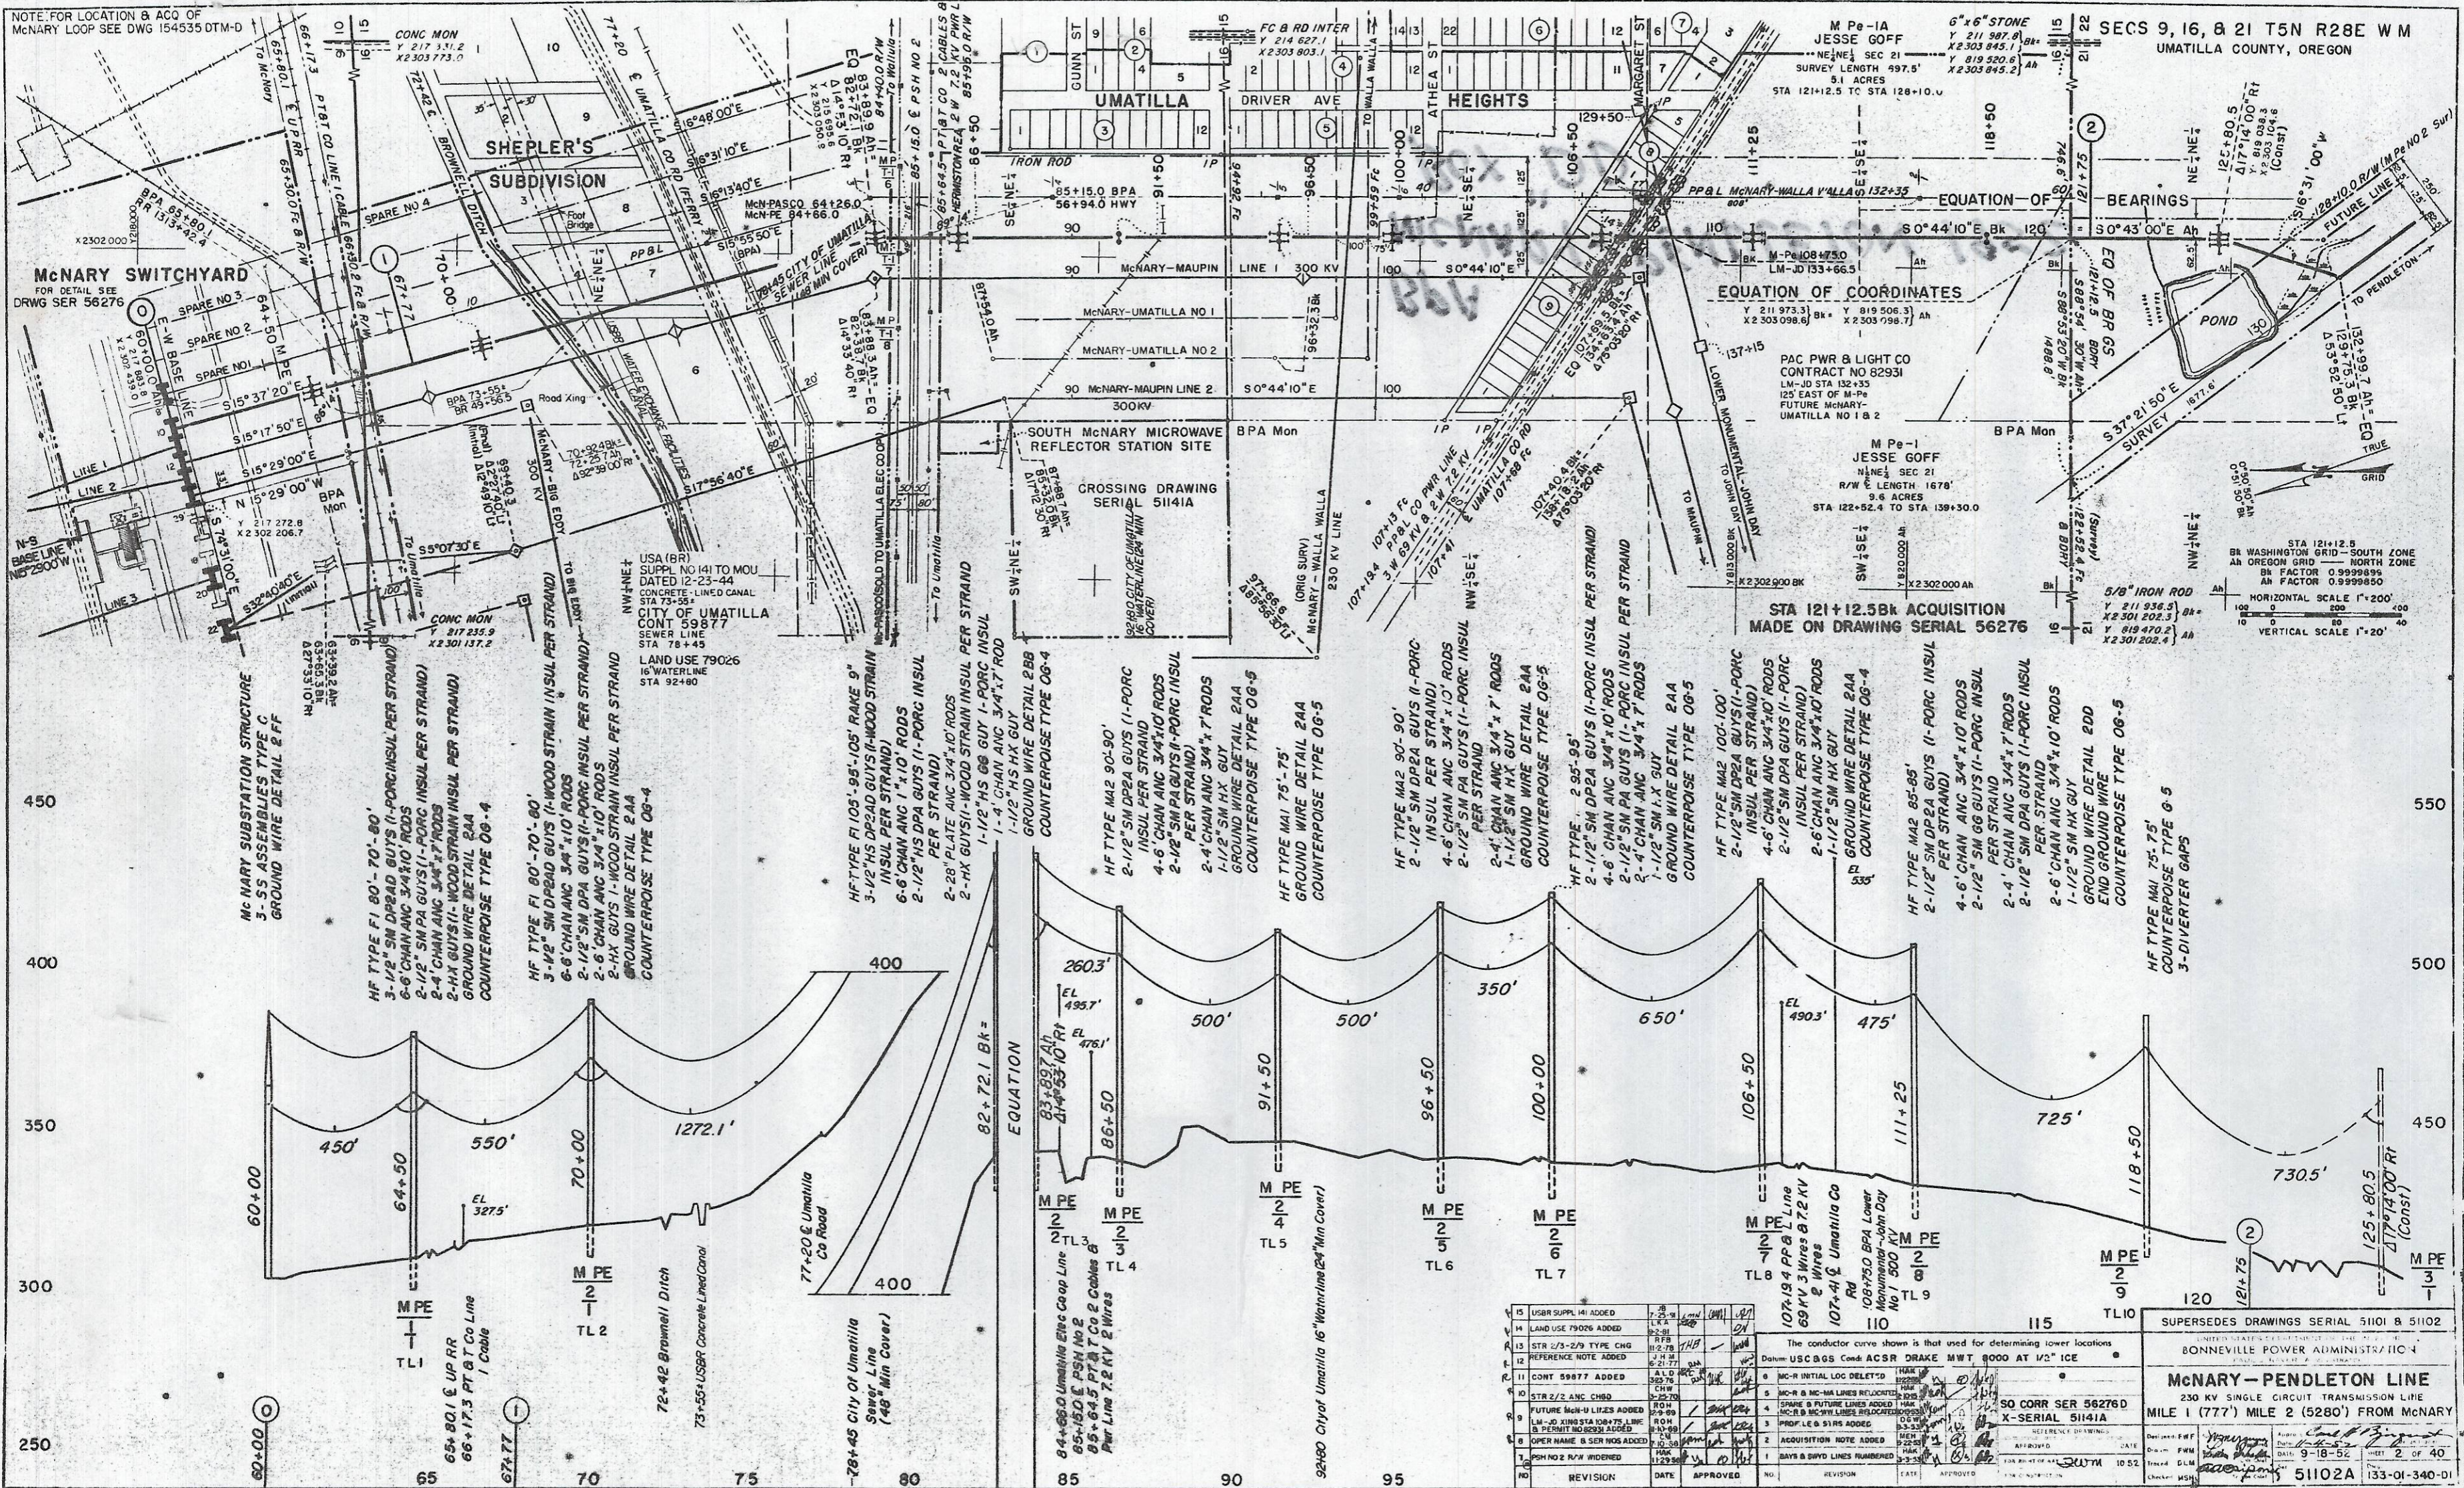

NO	REVISION	DATE	APPROVED	NO	REVISION	DATE	APPROVED
6							
5							
4							
3							
2							
1							

DATE: 9-18-52  
 SHEET: 2 OF 40  
 DRAWING NO: 51102A  
 PROJECT NO: 133-01-340-01  
 OPER AS McNARY-ROUNDUP NO 1