

FOR OWNERSHIP DATA SEE  
DRAWING SERIAL 13224

SECS 34, 3 & 2 T1N. & T1S R35E WM  
UMATILLA COUNTY, OREGON

CONTRACT Ibp NO 75951  
PERMIT TO SALT LAKE PIPE LINE CO  
STA 32+42.8 TO STA 33+05.2

THE J E SMITH LIVESTOCK COMPANY

EARL GILLANDERS

F J WATKINS

THE J E SMITH LIVESTOCK CO

OREGON WASHINGTON RAILROAD & NAVIGATION CO

WESTERN UNION TELEGRAPH CO

U S FOREST SERVICE TLP LINE

WILLAMETTE BASE LINE  
T1N R35E WM  
T1S R35E WM

OLD UMATILLA INDIAN RESERVATION BOUNDARY

OWRRAN CO STA 36+92.8  
BPA STA 31+72.6

B/L 1181+39.8 BK EQUATION  
H/L 0+00 AH

TO LA GRANDE


TO PENDLETON  
2+25 PACE  
2+14.4

CROSSING DRAWING  
SERIAL 32364

HF TYPE A2 75'-75'  
2-1/2" SM DPA GUYS  
2-6" CHAN ANC 3/4" x 10' RODS  
1-WOOD STRAIN INSULATOR PER STRAND  
1-1/2" SM HX GUY  
3-DIVERTER GAPS  
COUNTERPOISE TYPE S-1

HF TYPE A1 75'-80'  
3-DIVERTER GAPS  
COUNTERPOISE TYPE G-3

HORIZONTAL SCALE  
1" = 100'  
VERTICAL SCALE  
1" = 10'

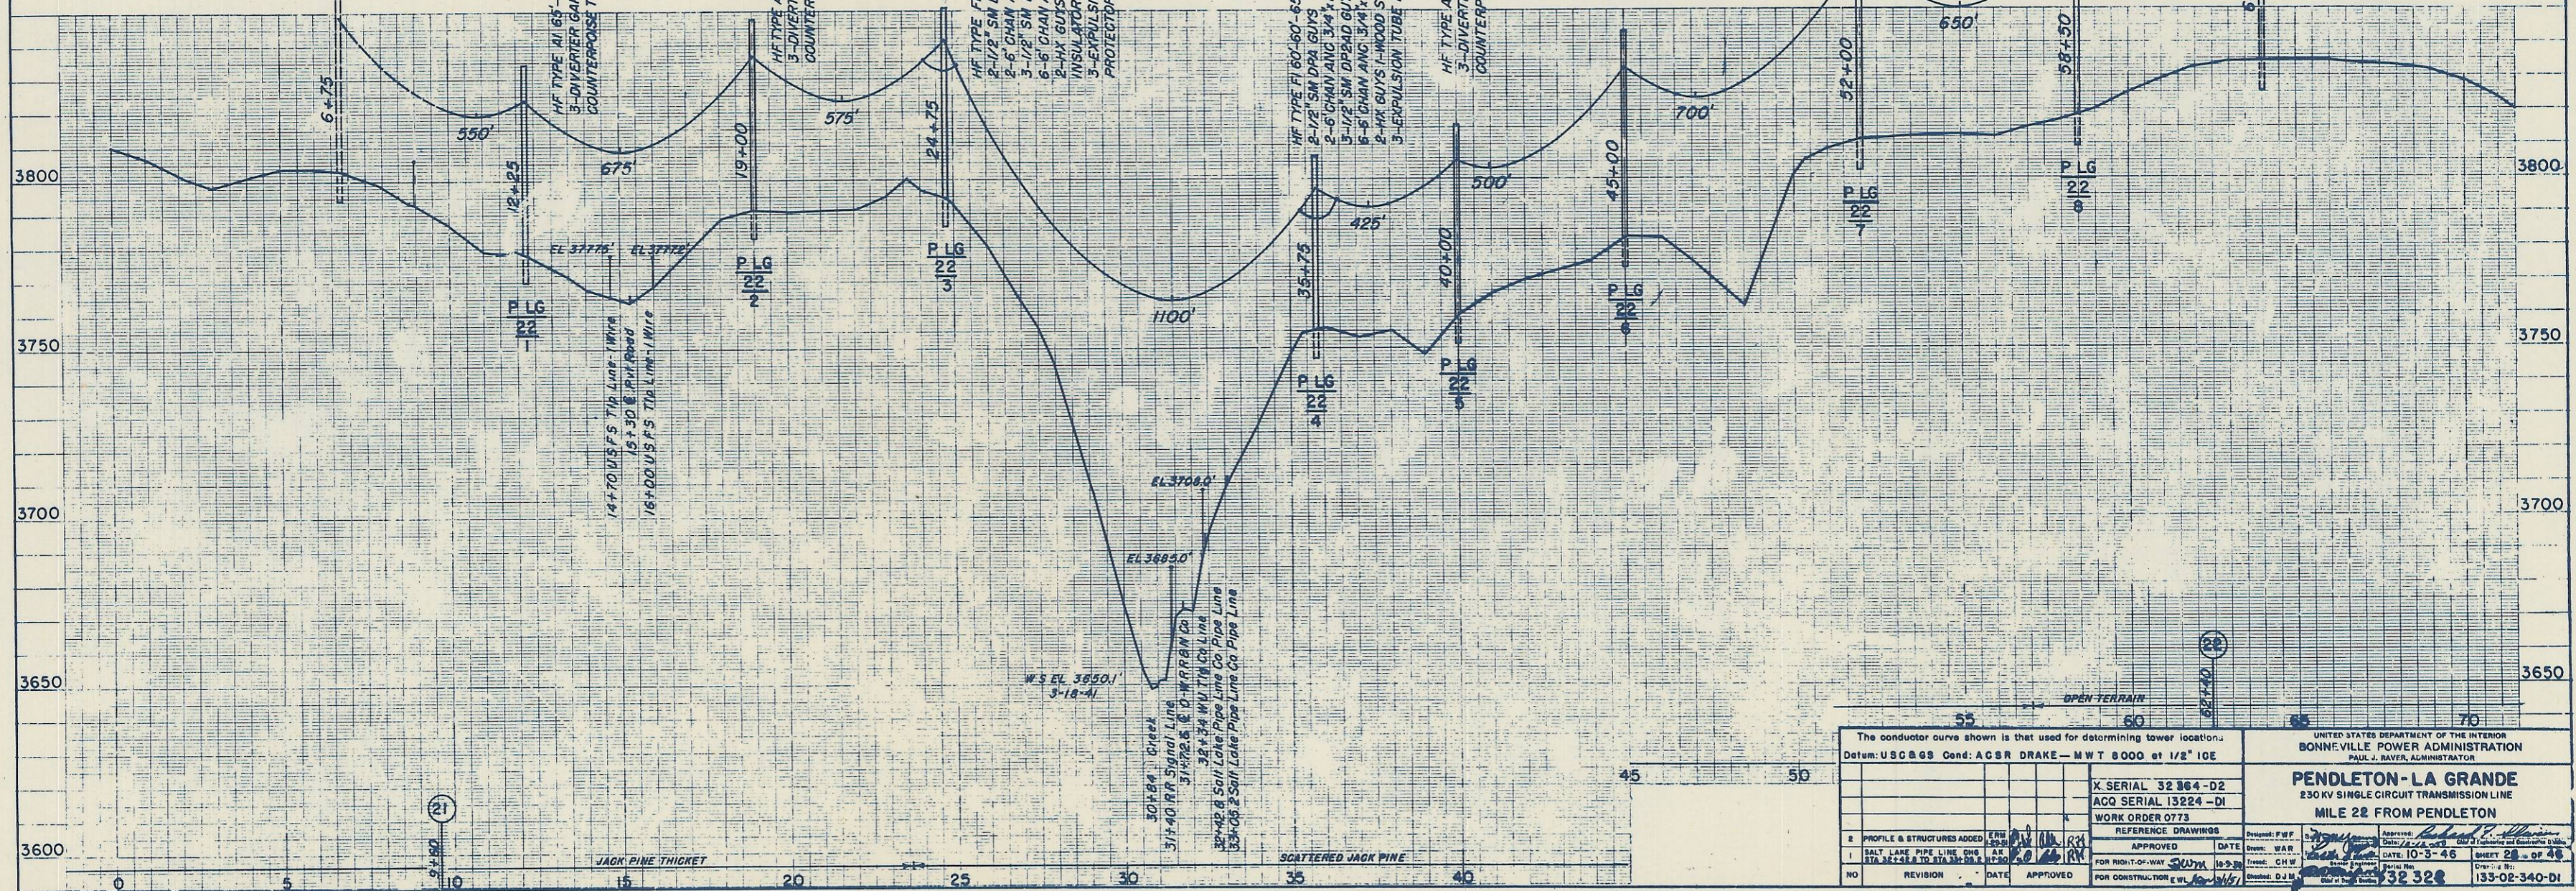

The conductor curve shown is that used for determining tower locations.  
Datum: USC & GS Cond: ACSR DRAKE - MWT 8000 at 1/2" 10E

UNITED STATES DEPARTMENT OF THE INTERIOR  
BONNEVILLE POWER ADMINISTRATION  
PAUL J. RAVER, ADMINISTRATOR

X SERIAL 32364-02 ACQ SERIAL 13224-DI WORK ORDER 0773		DATE: 10-3-46	
2	PROFILE & STRUCTURES ADDED	DATE	APPROVED
1	SALT LAKE PIPE LINE CO	DATE	APPROVED
NO	REVISION	DATE	APPROVED

PENDELTON-LA GRANDE  
230 KV SINGLE CIRCUIT TRANSMISSION LINE  
MILE 22 FROM PENDLETON  
DATE: 10-3-46  
SHEET 28 OF 48  
133-02-340-DI